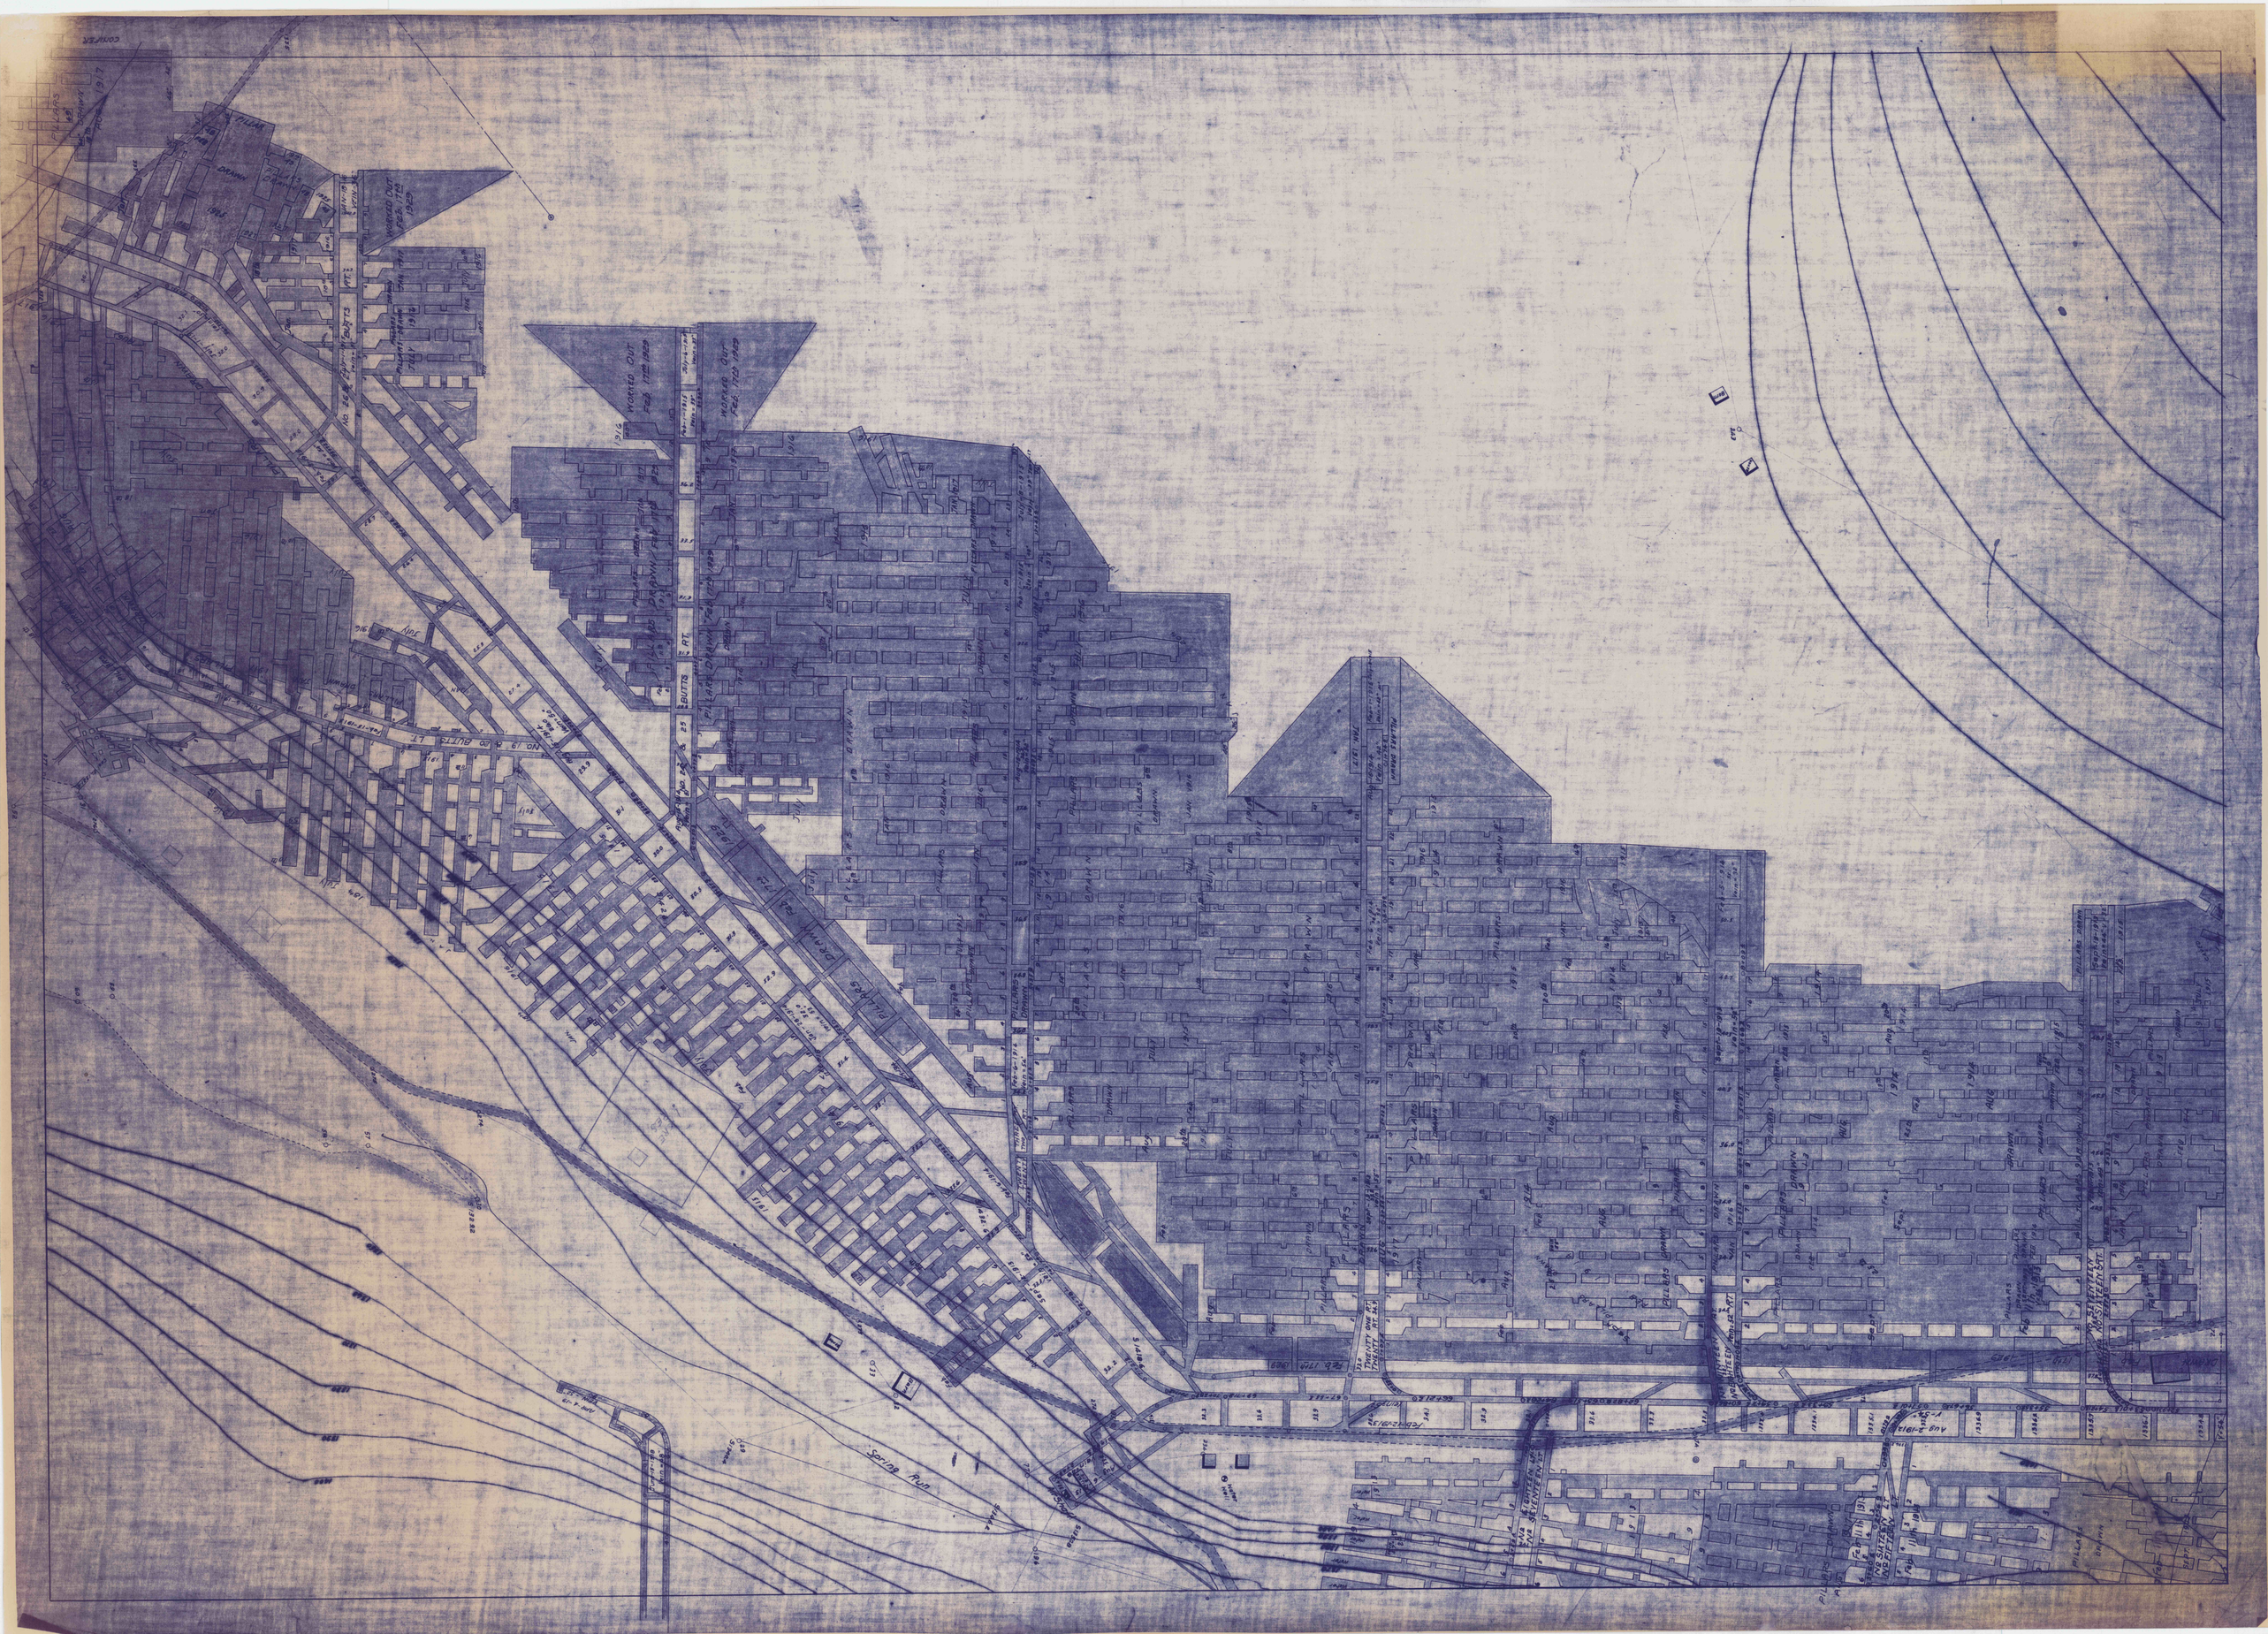

PILLARS DRAWN
Aug.
Feb. 11th 1915
No. SIXTEEN & No. FIFTEEN LT.
Feb. 11th 1915
No. EIGHTEEN LT. & No. SEVENTEEN LT.
Water
1370
1380
1390
Water Hole
Aug-2-1912
V-54"
Feb-12-1913
vein=57"
DRAWN Feb. 17th 1929
Feb. 17th 1929
No. SEVENTEEN RT. No. SIXTEEN RT.
No. NINETEEN RT. No. EIGHTEEN RT.
vein=52"
TWENTY ONE RT. TWENTY RT.
Sept-18-1913
vein=55"
Sept-18-1913
vein=52"
Feb-5-1914
vein=32"
Aug-18-1914
vein=42"
Feb-6-1914
vein=54"
TWENTY THREE RT. TWENTY TWO RT.
Feb-6-1914
Sept. 1913
vein=52"
Jan-28-1914
vein=53"
PILLARS DRAWN Feb. 17th 1929
Spring Run
Barn
House
APR-4-19
VEIN-52"
1400
1390
1380
1370
1360
1350
1340
1330
JAN.
18th July
1916
NO. 19 & 20 BUTTS LT.
Aug-15-1914
vein=50"
Feb-15-1915
July-6-1915
PILLARS DRAWN JAN 1917
PILLARS DRAWN
No. 24 & 25 BUTTS RT.
PILLARS DRAWN Feb 17th 1929
WORKED OUT Feb. 17th 1929
Feb-1-1915
July-6-1915
PILLARS DRAWN Feb 17th 1929
WORKED OUT Feb. 17th 1929
No. 26 & 27 BUTTS RT.
PILLARS DRAWN JULY 1916
PILLARS DRAWN JAN 1917
WORKED OUT Feb. 17th 1929
JAN-18
VEIN-36"
PILLARS DRAWN
July-1-1915
vein-50"
Feb-8-1916
PILLAR DRAWN
PILLARS DRAWN AUG 1917
Barn
House
243
1914
1915
1916
1917
1925

CONIFER