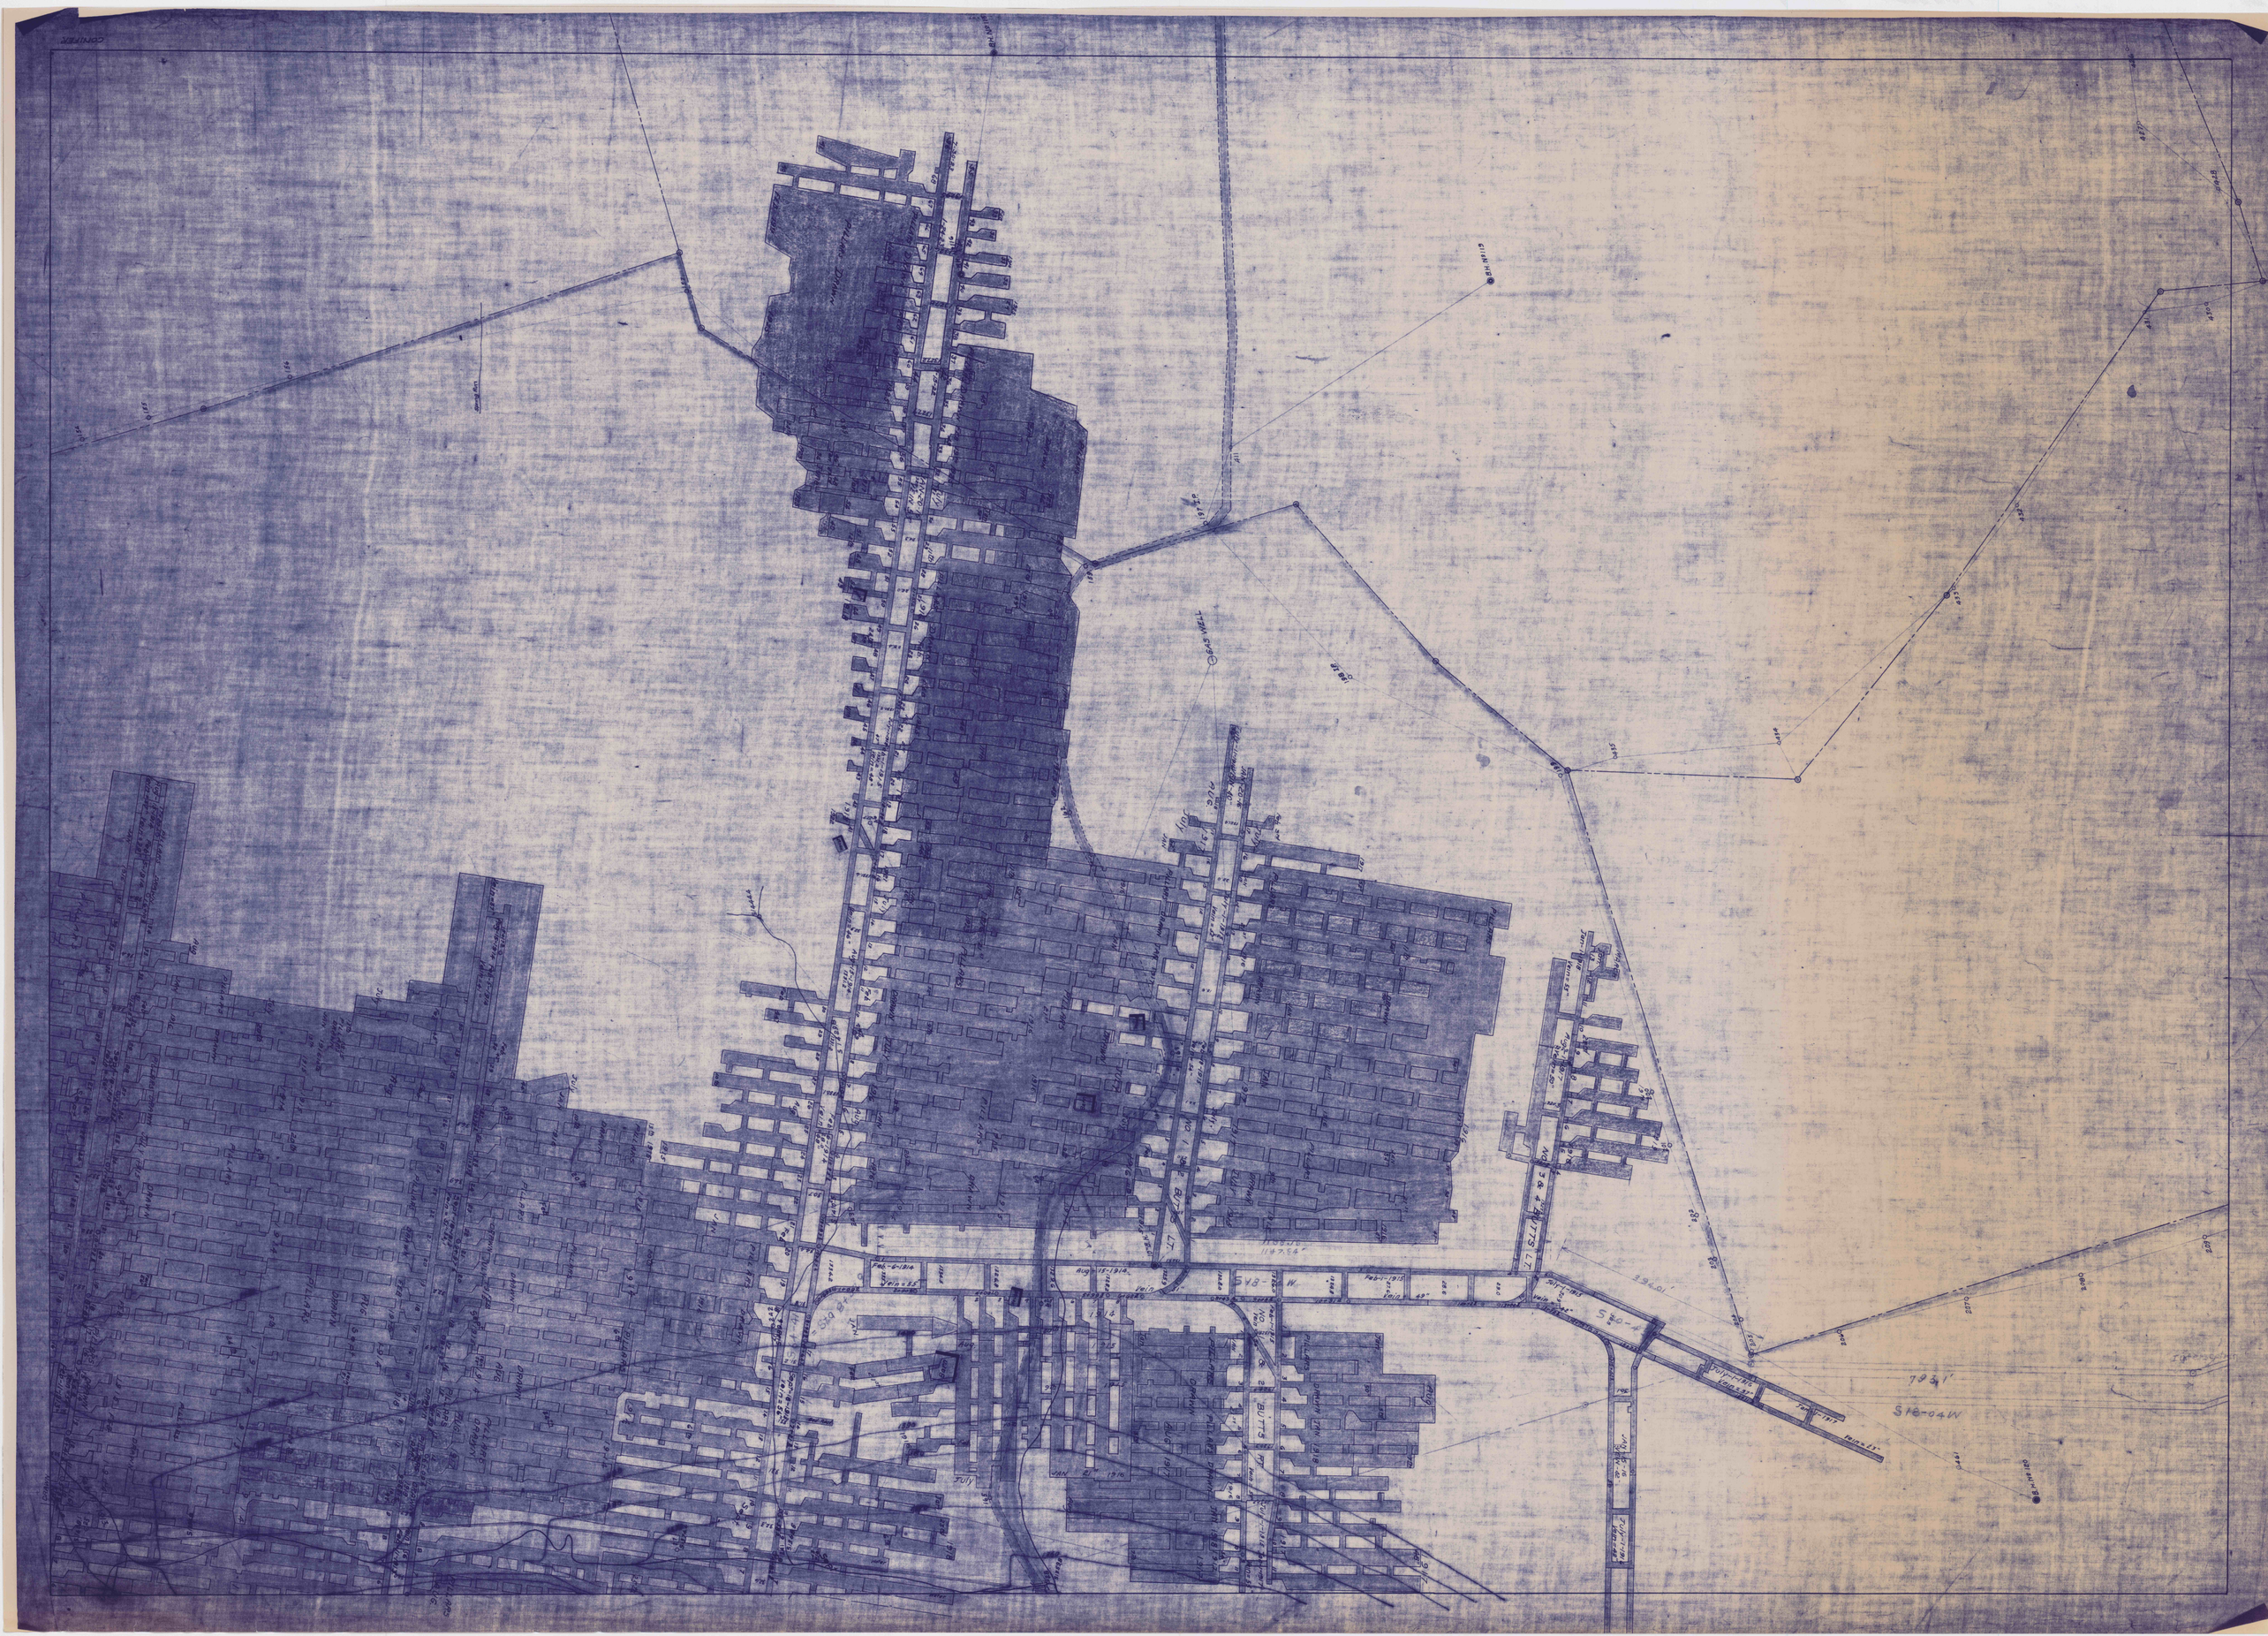

S18-04W
1931'
B.H. No 120
Vein=23"
Jan-1-1917
July-1-1916 Vein=37"
S40-4
July-1-1915 Vein=42"
July-1-1916 Vein=42"
Jan-15-16 Vein-42
No 3 & 4 BUTTS LT.
Aug-1-1917 Vein=50"
Jan-1-1918 Vein=53"
MARCH
BUTTS RT.
No 1 & 2
Feb-1-1915
S48-W
Aug-15-1914
Feb-6-1914 Vein=55
No 1 & 2 BUTTS LT.
Sept-16-1913 Vein=56"
PILLARS
DRAWN
JAN
JULY
AUG
FEB
SEPT
1914
1915
1916
1917
1918
1923
1925
GAS WELL
B.H. No 119
B.H. No 118
Spring Run
CONIFER