


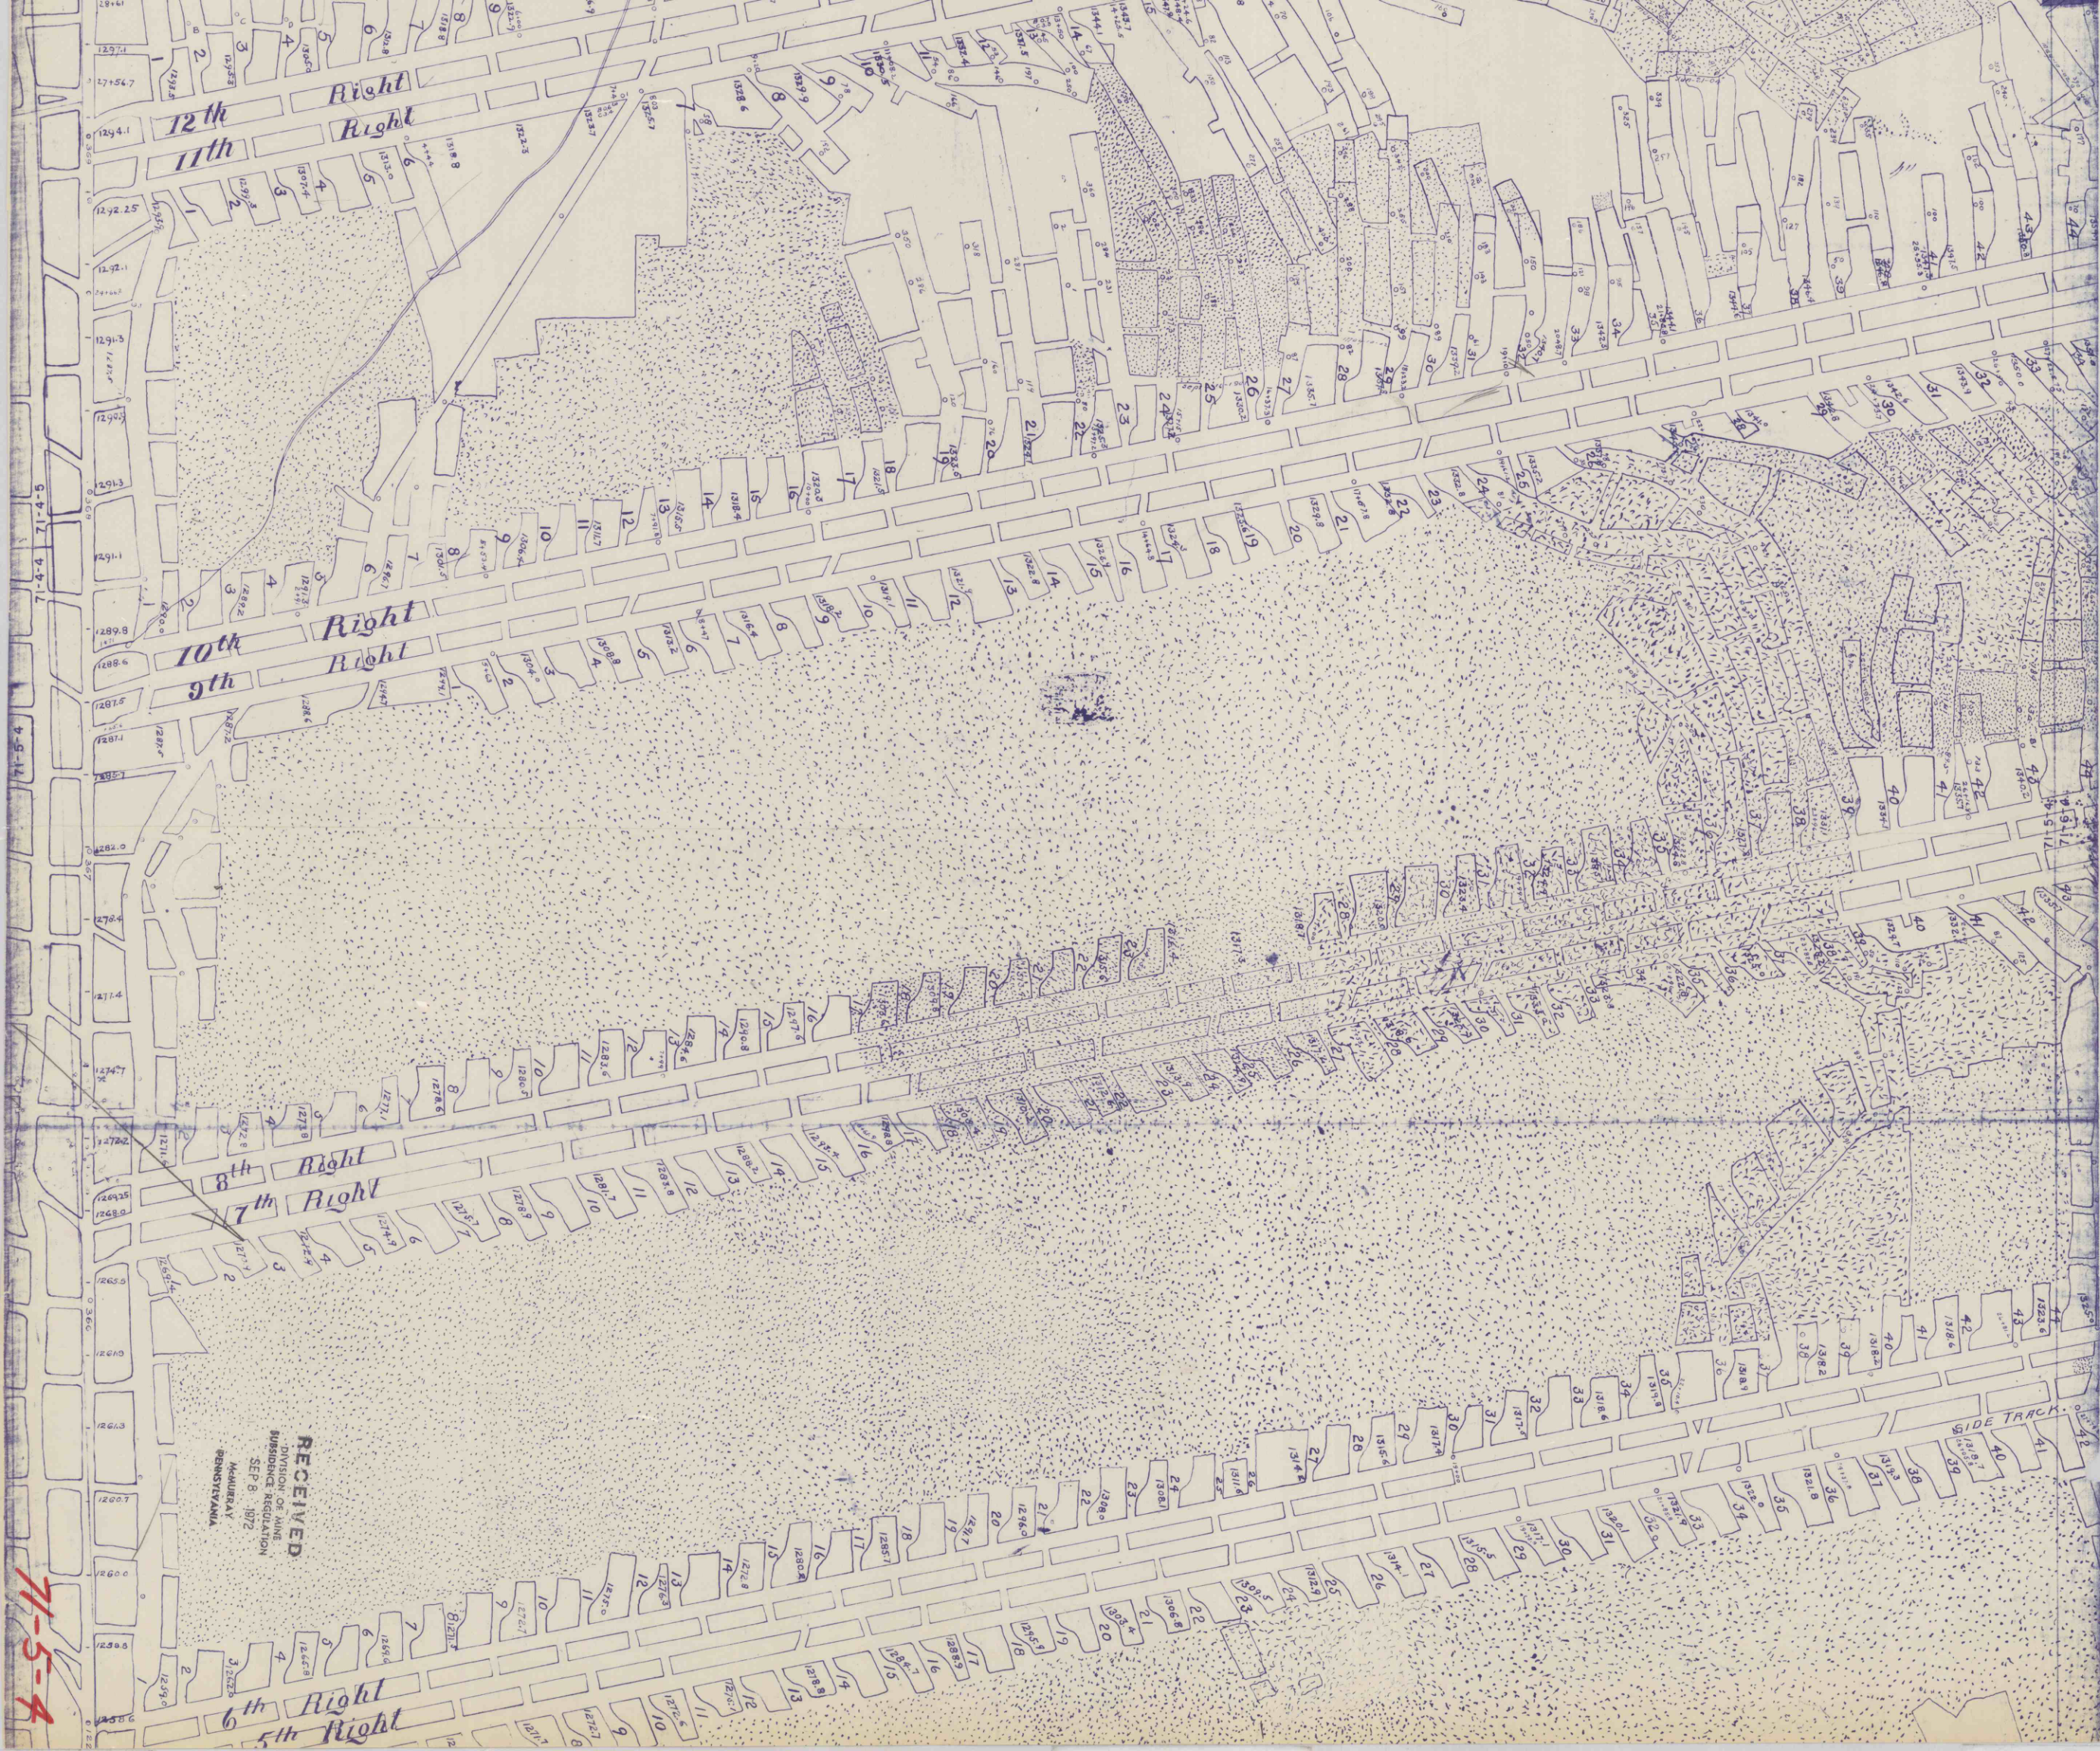

RECEIVED
DIVISION OF MINE
SUSPENSION REGULATION
SEP 8 1972
McMURRAY
PENNSYLVANIA

71-5-4