


4-6-11

71-7-4

71-6-4
71-7-4

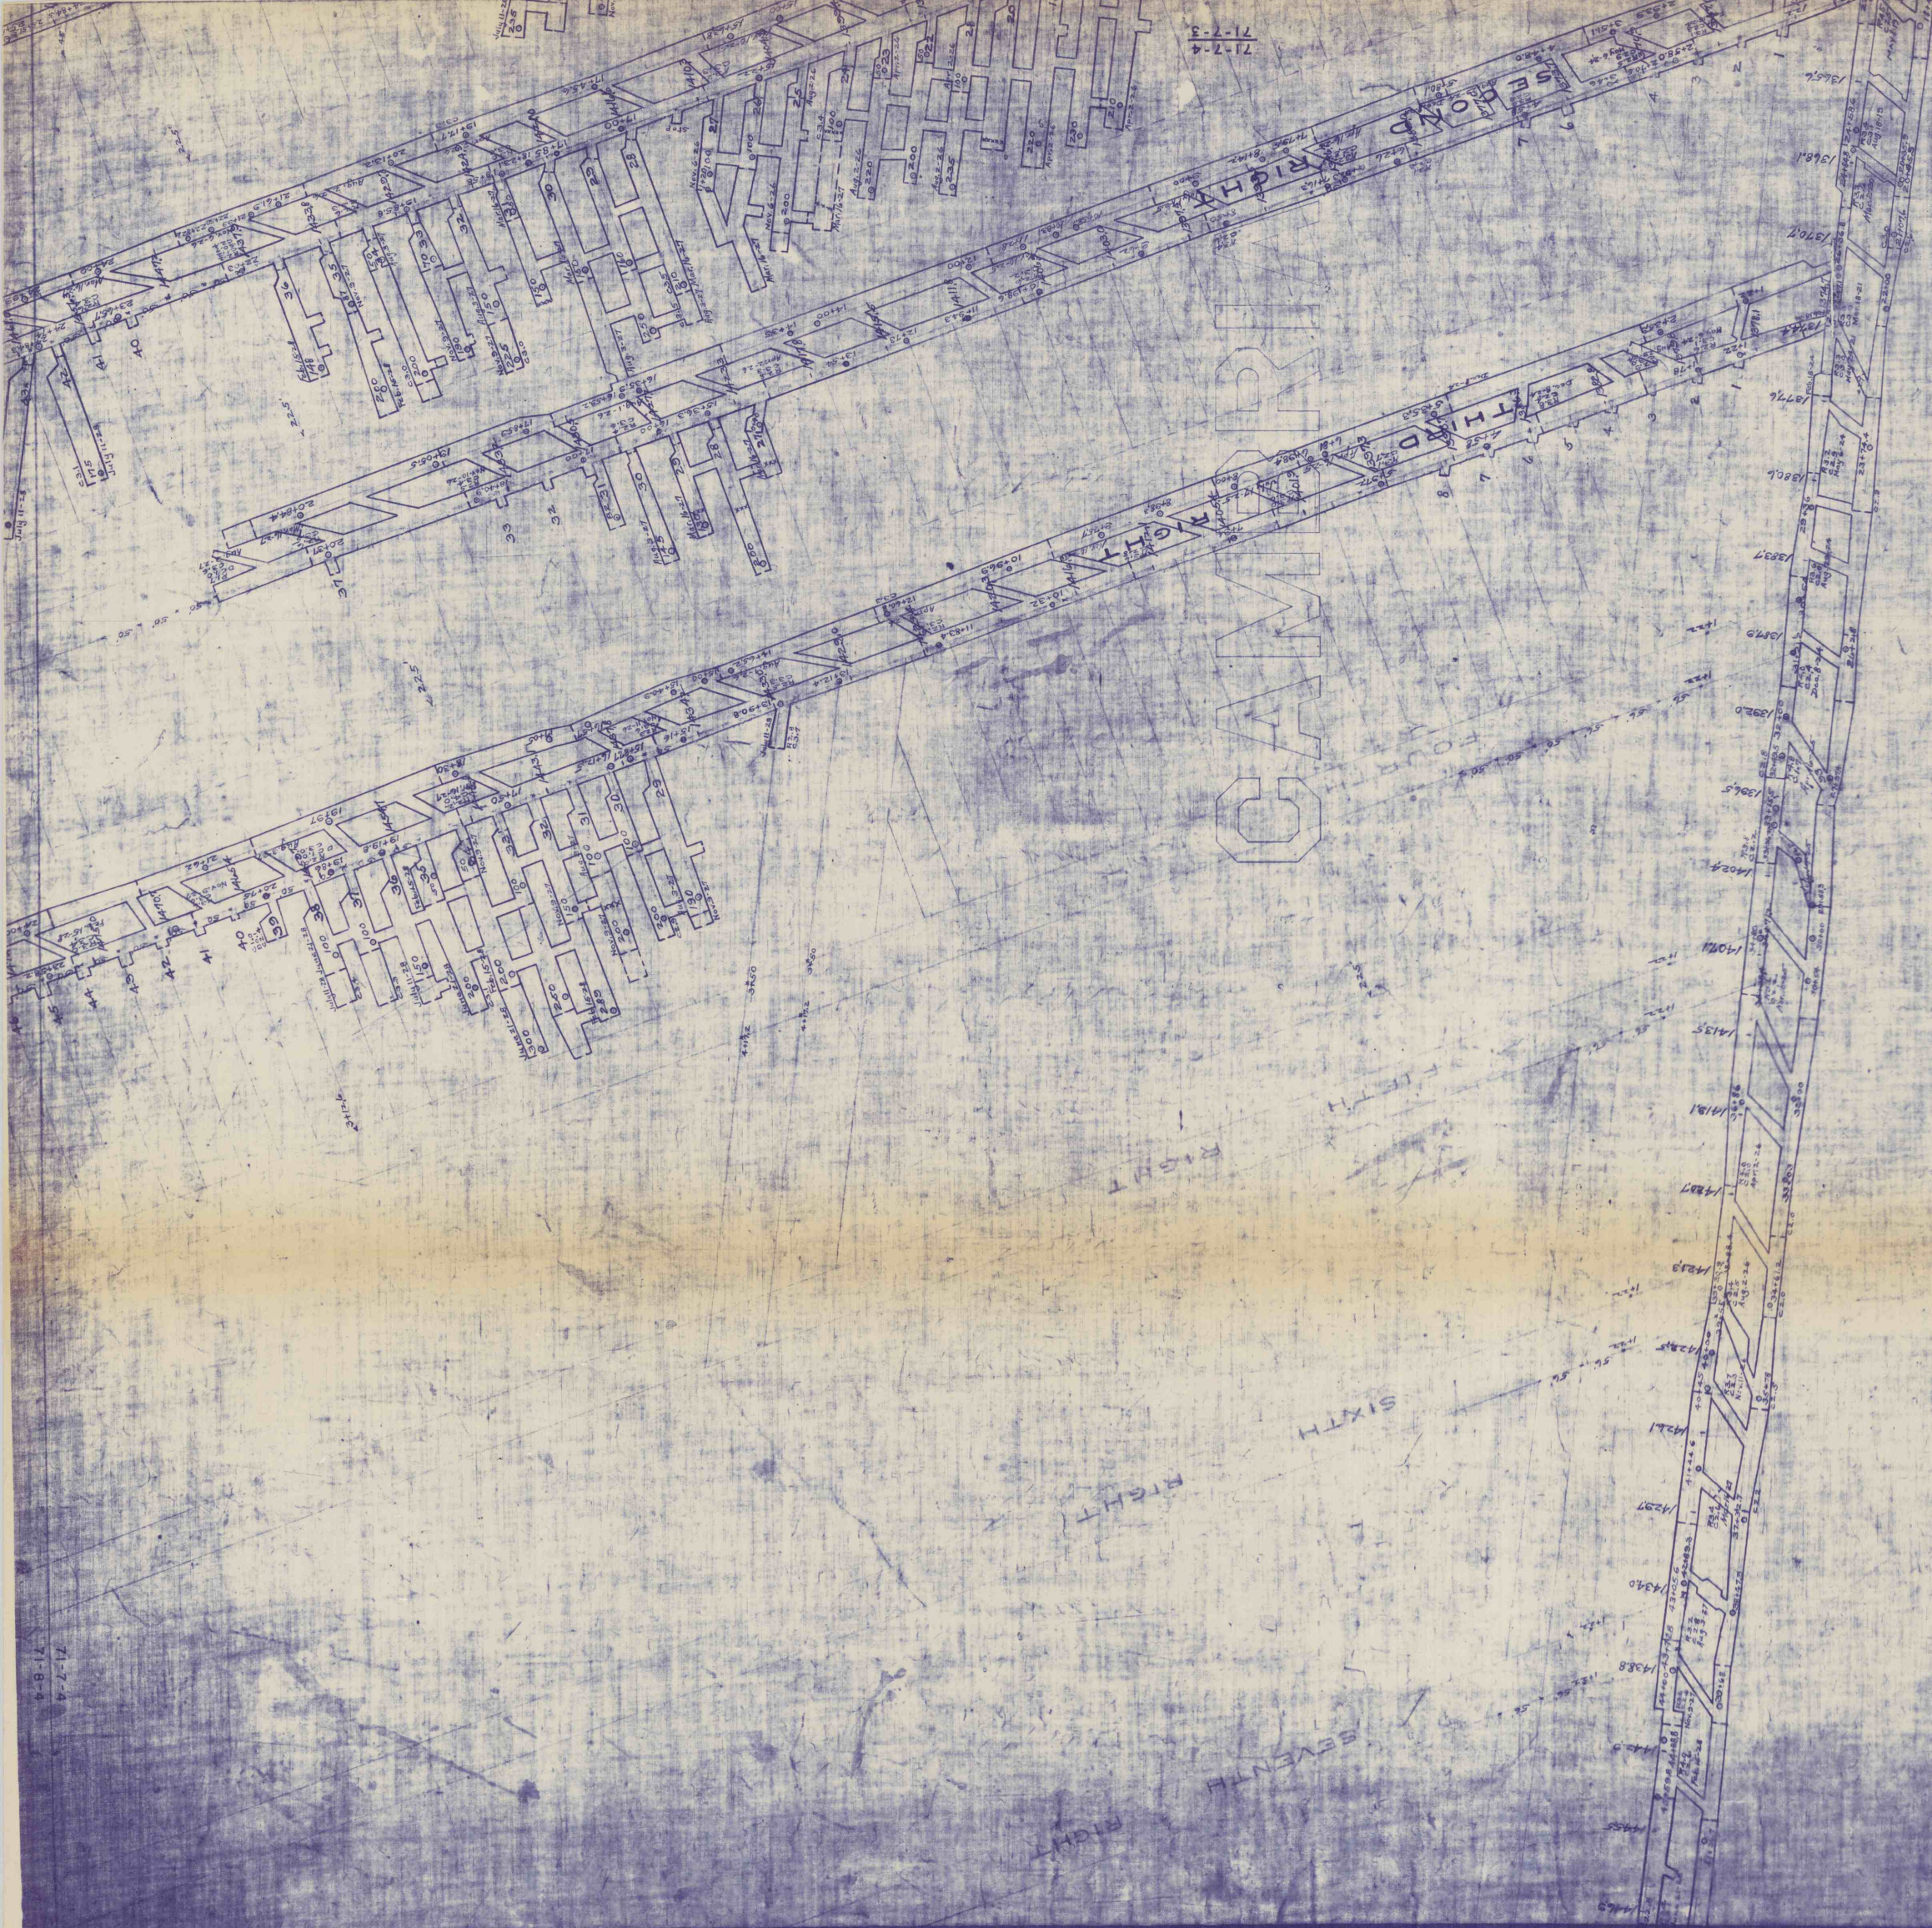

RECEIVED
DIVISION OF HIGHWAYS
SUBSIDENCE REGULATION
SEP 8 1922
McMURRAY
PENNSYLVANIA