


12

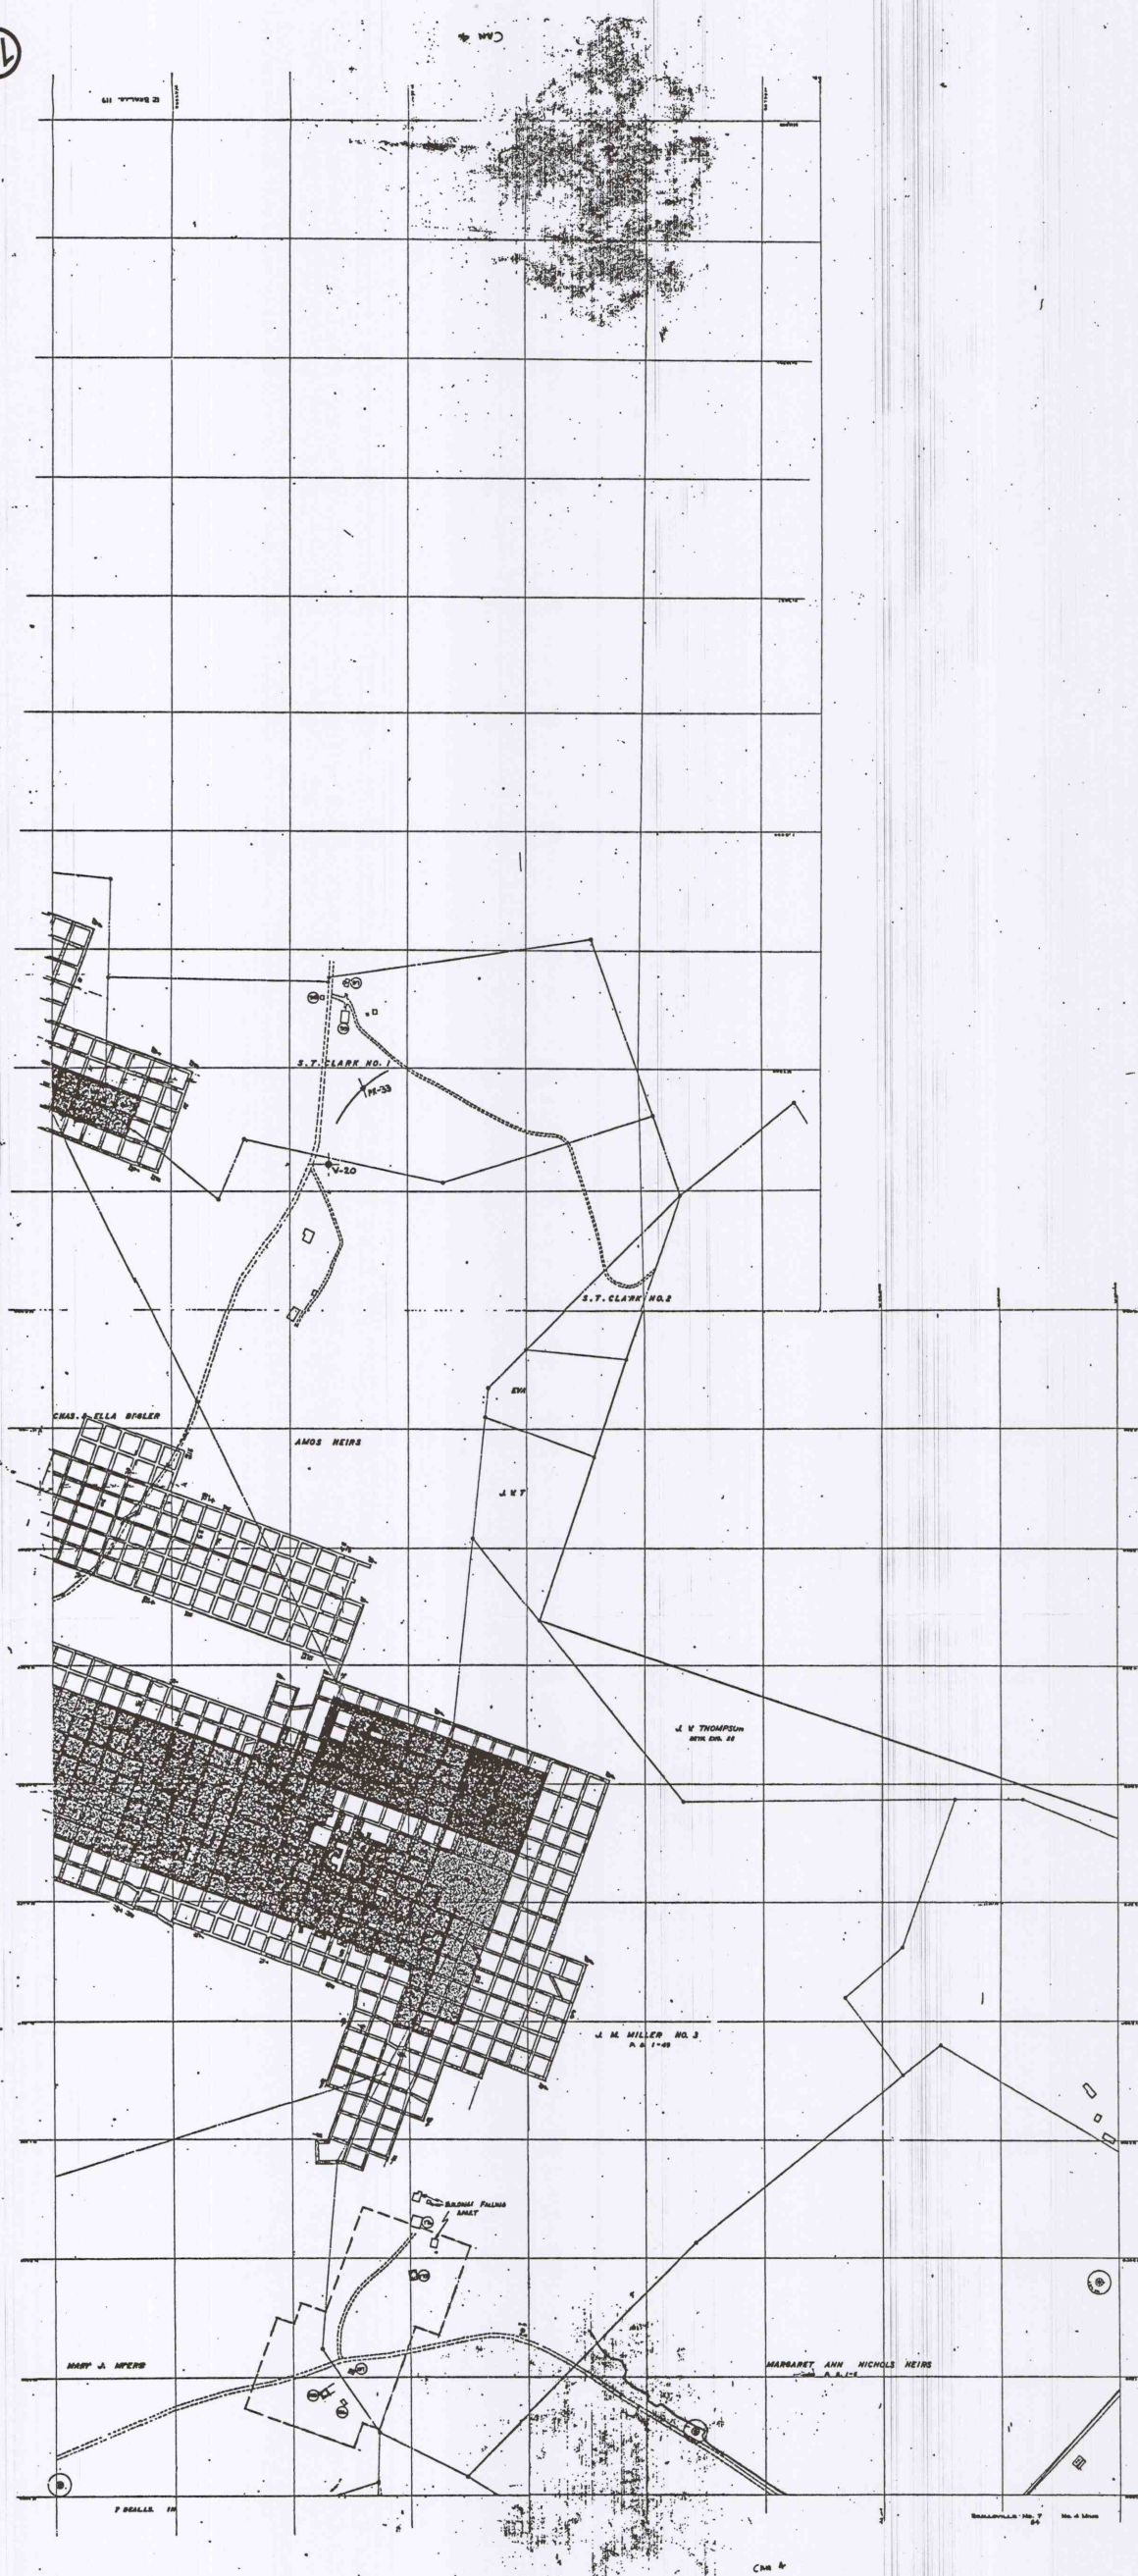

VESTA MINE
FEDERAL I. D. NO. 36-00962
FEDERAL I. D. NO. 36-07646

SHEET 12 OF 18

1" = 400' JANUARY 2001

I, the undersigned, hereby certify that to the best of my knowledge and belief, this map is accurate as of January 19, 2001 and shows the mining as of June 23, 1987 as represented by Maxwell Coal Company on November 7, 1998 and shows all of the information required by the mining laws of this state.

Taken subscribed and sworn to before me the undersigned authority this 14th day of January 2001.

My Commission Expires:

Notarial Seal Kimberly M. Jacobino, Notary Public Peters Twp., Washington County My Commission Expires Aug. 24, 2004

Member, Pennsylvania Association of Notaries

COPY