


COPIED
MAY 17 2001

13

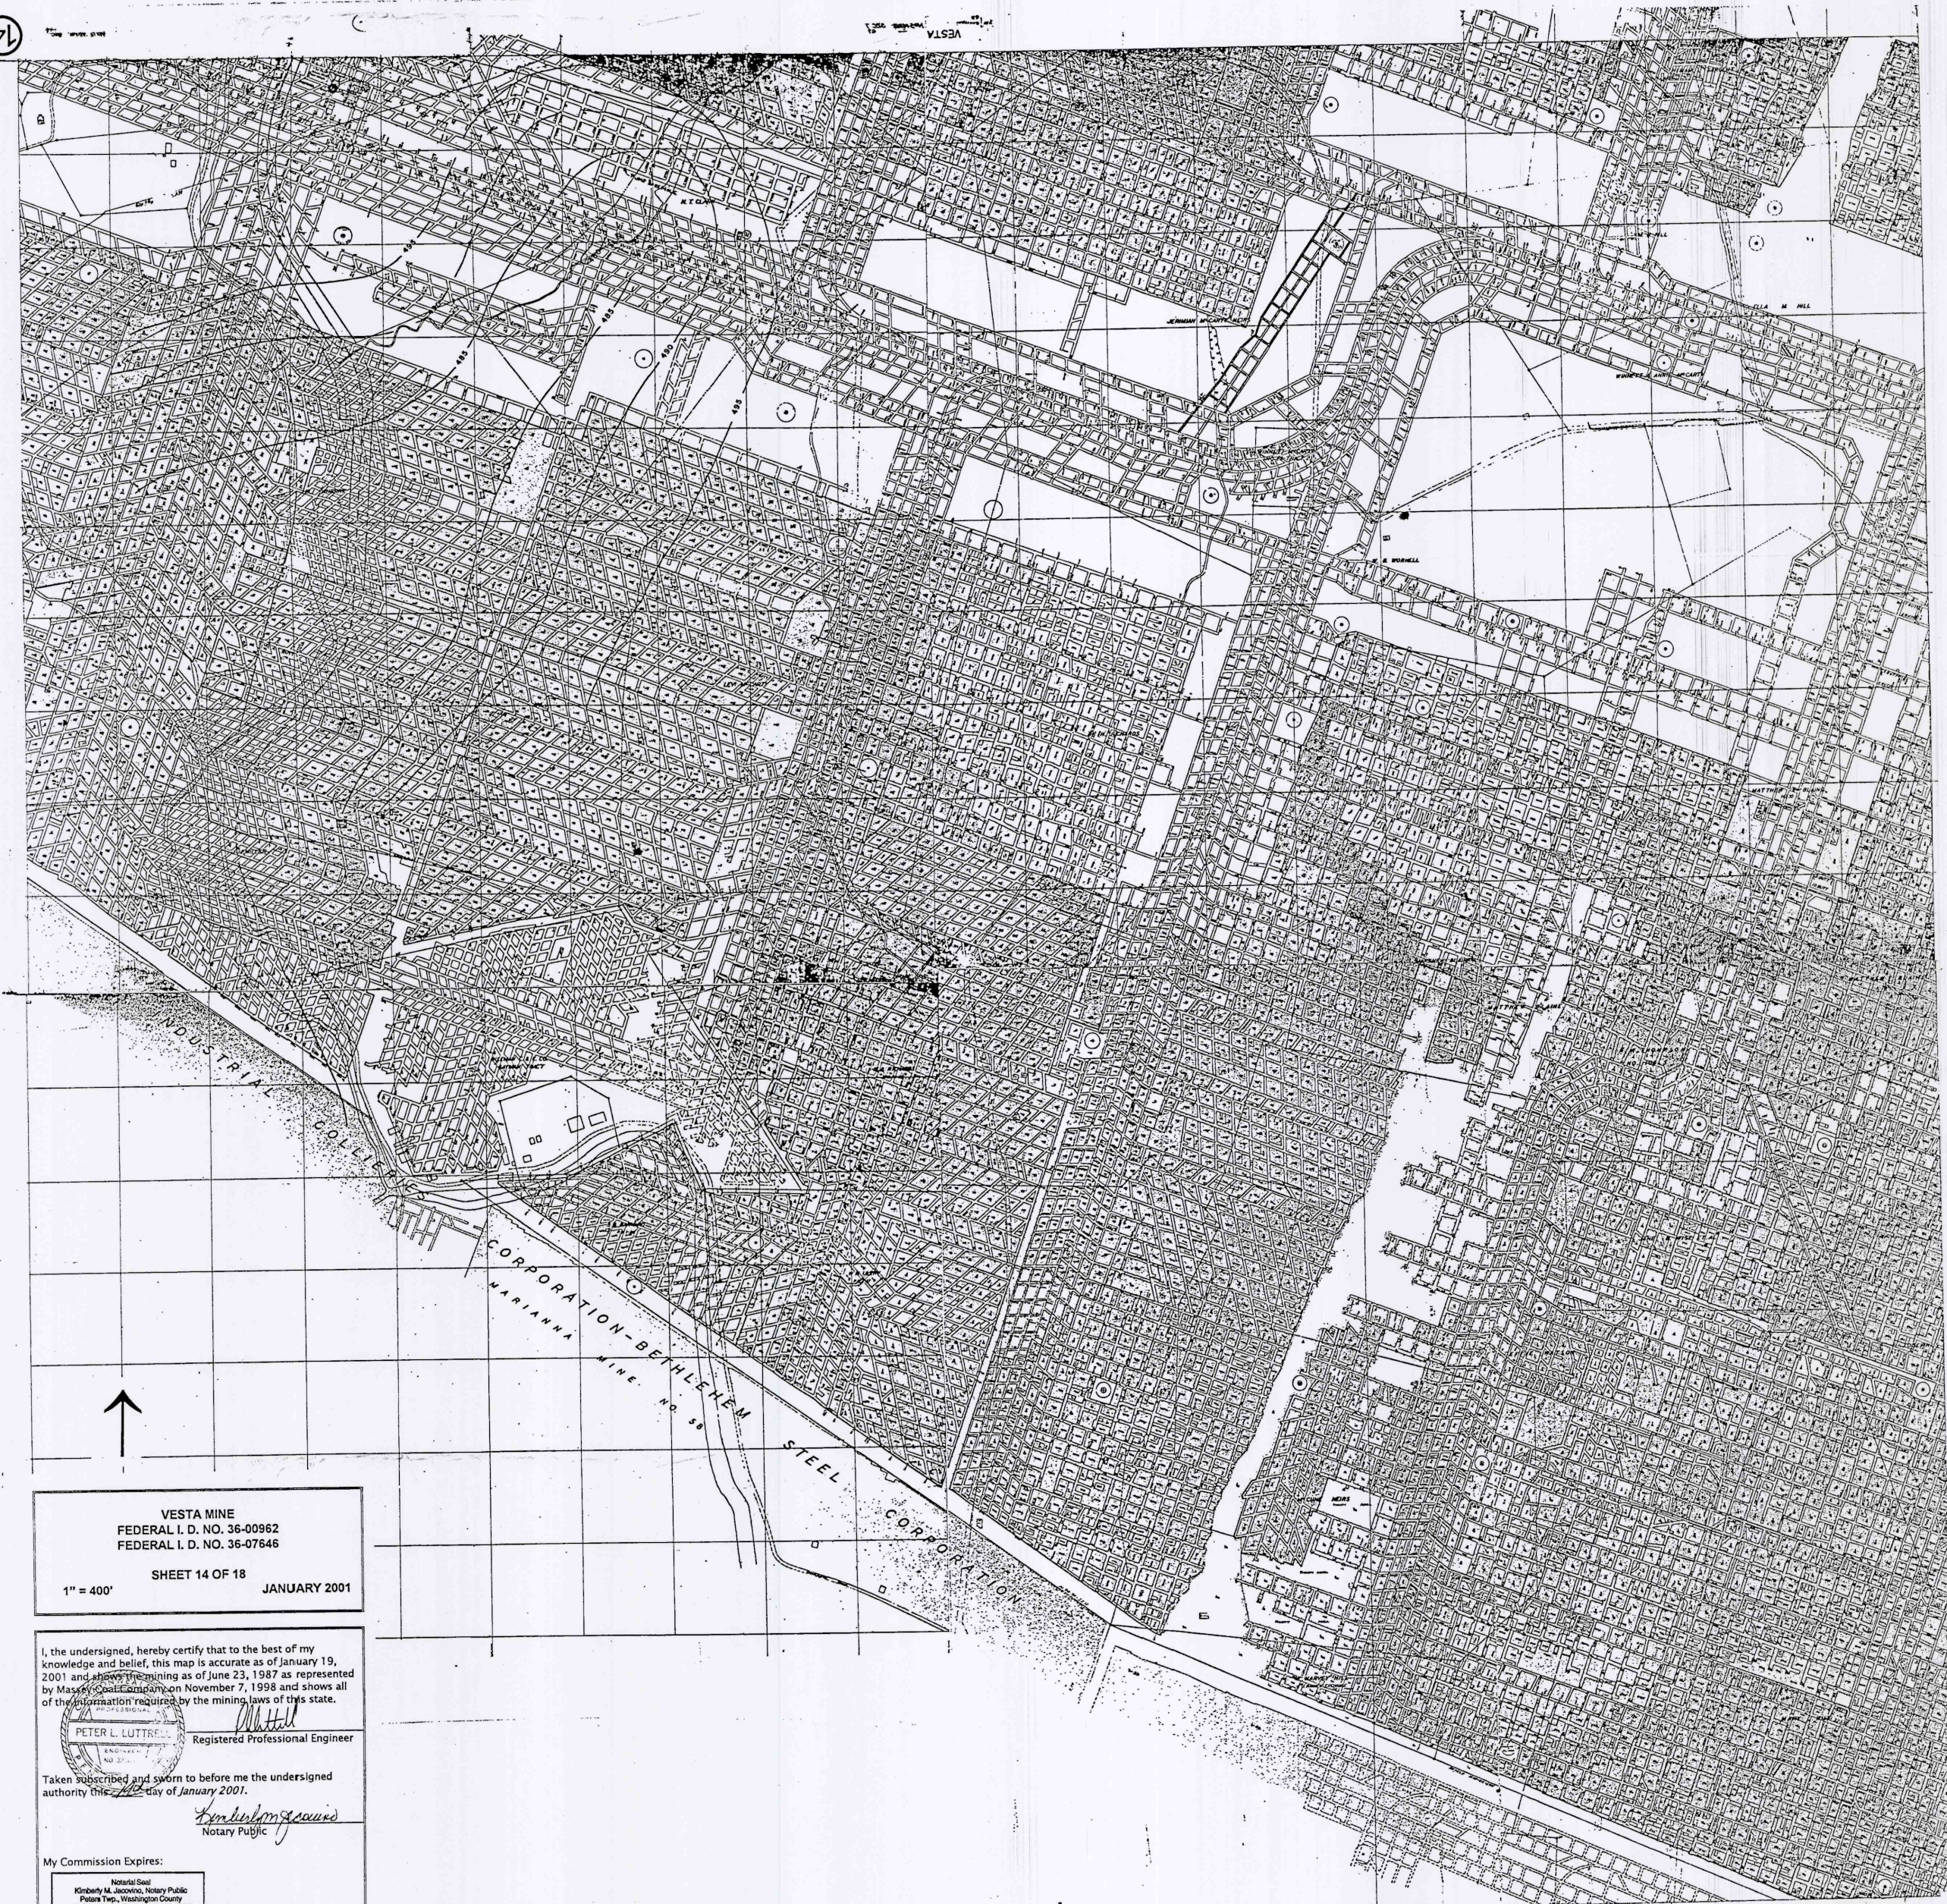

COPY

VESTA MINE
FEDERAL I. D. NO. 36-00962
FEDERAL I. D. NO. 36-07646
SHEET 14 OF 18
1" = 400' JANUARY 2001


PETER L. LUTTRE
Registered Professional Engineer

Taken subscribed and sworn to before me the undersigned authority this 12th day of January 2001.

Notary Public

My Commission Expires:

Notary Seal
My Commission Expires Aug. 28, 2004

14