


4

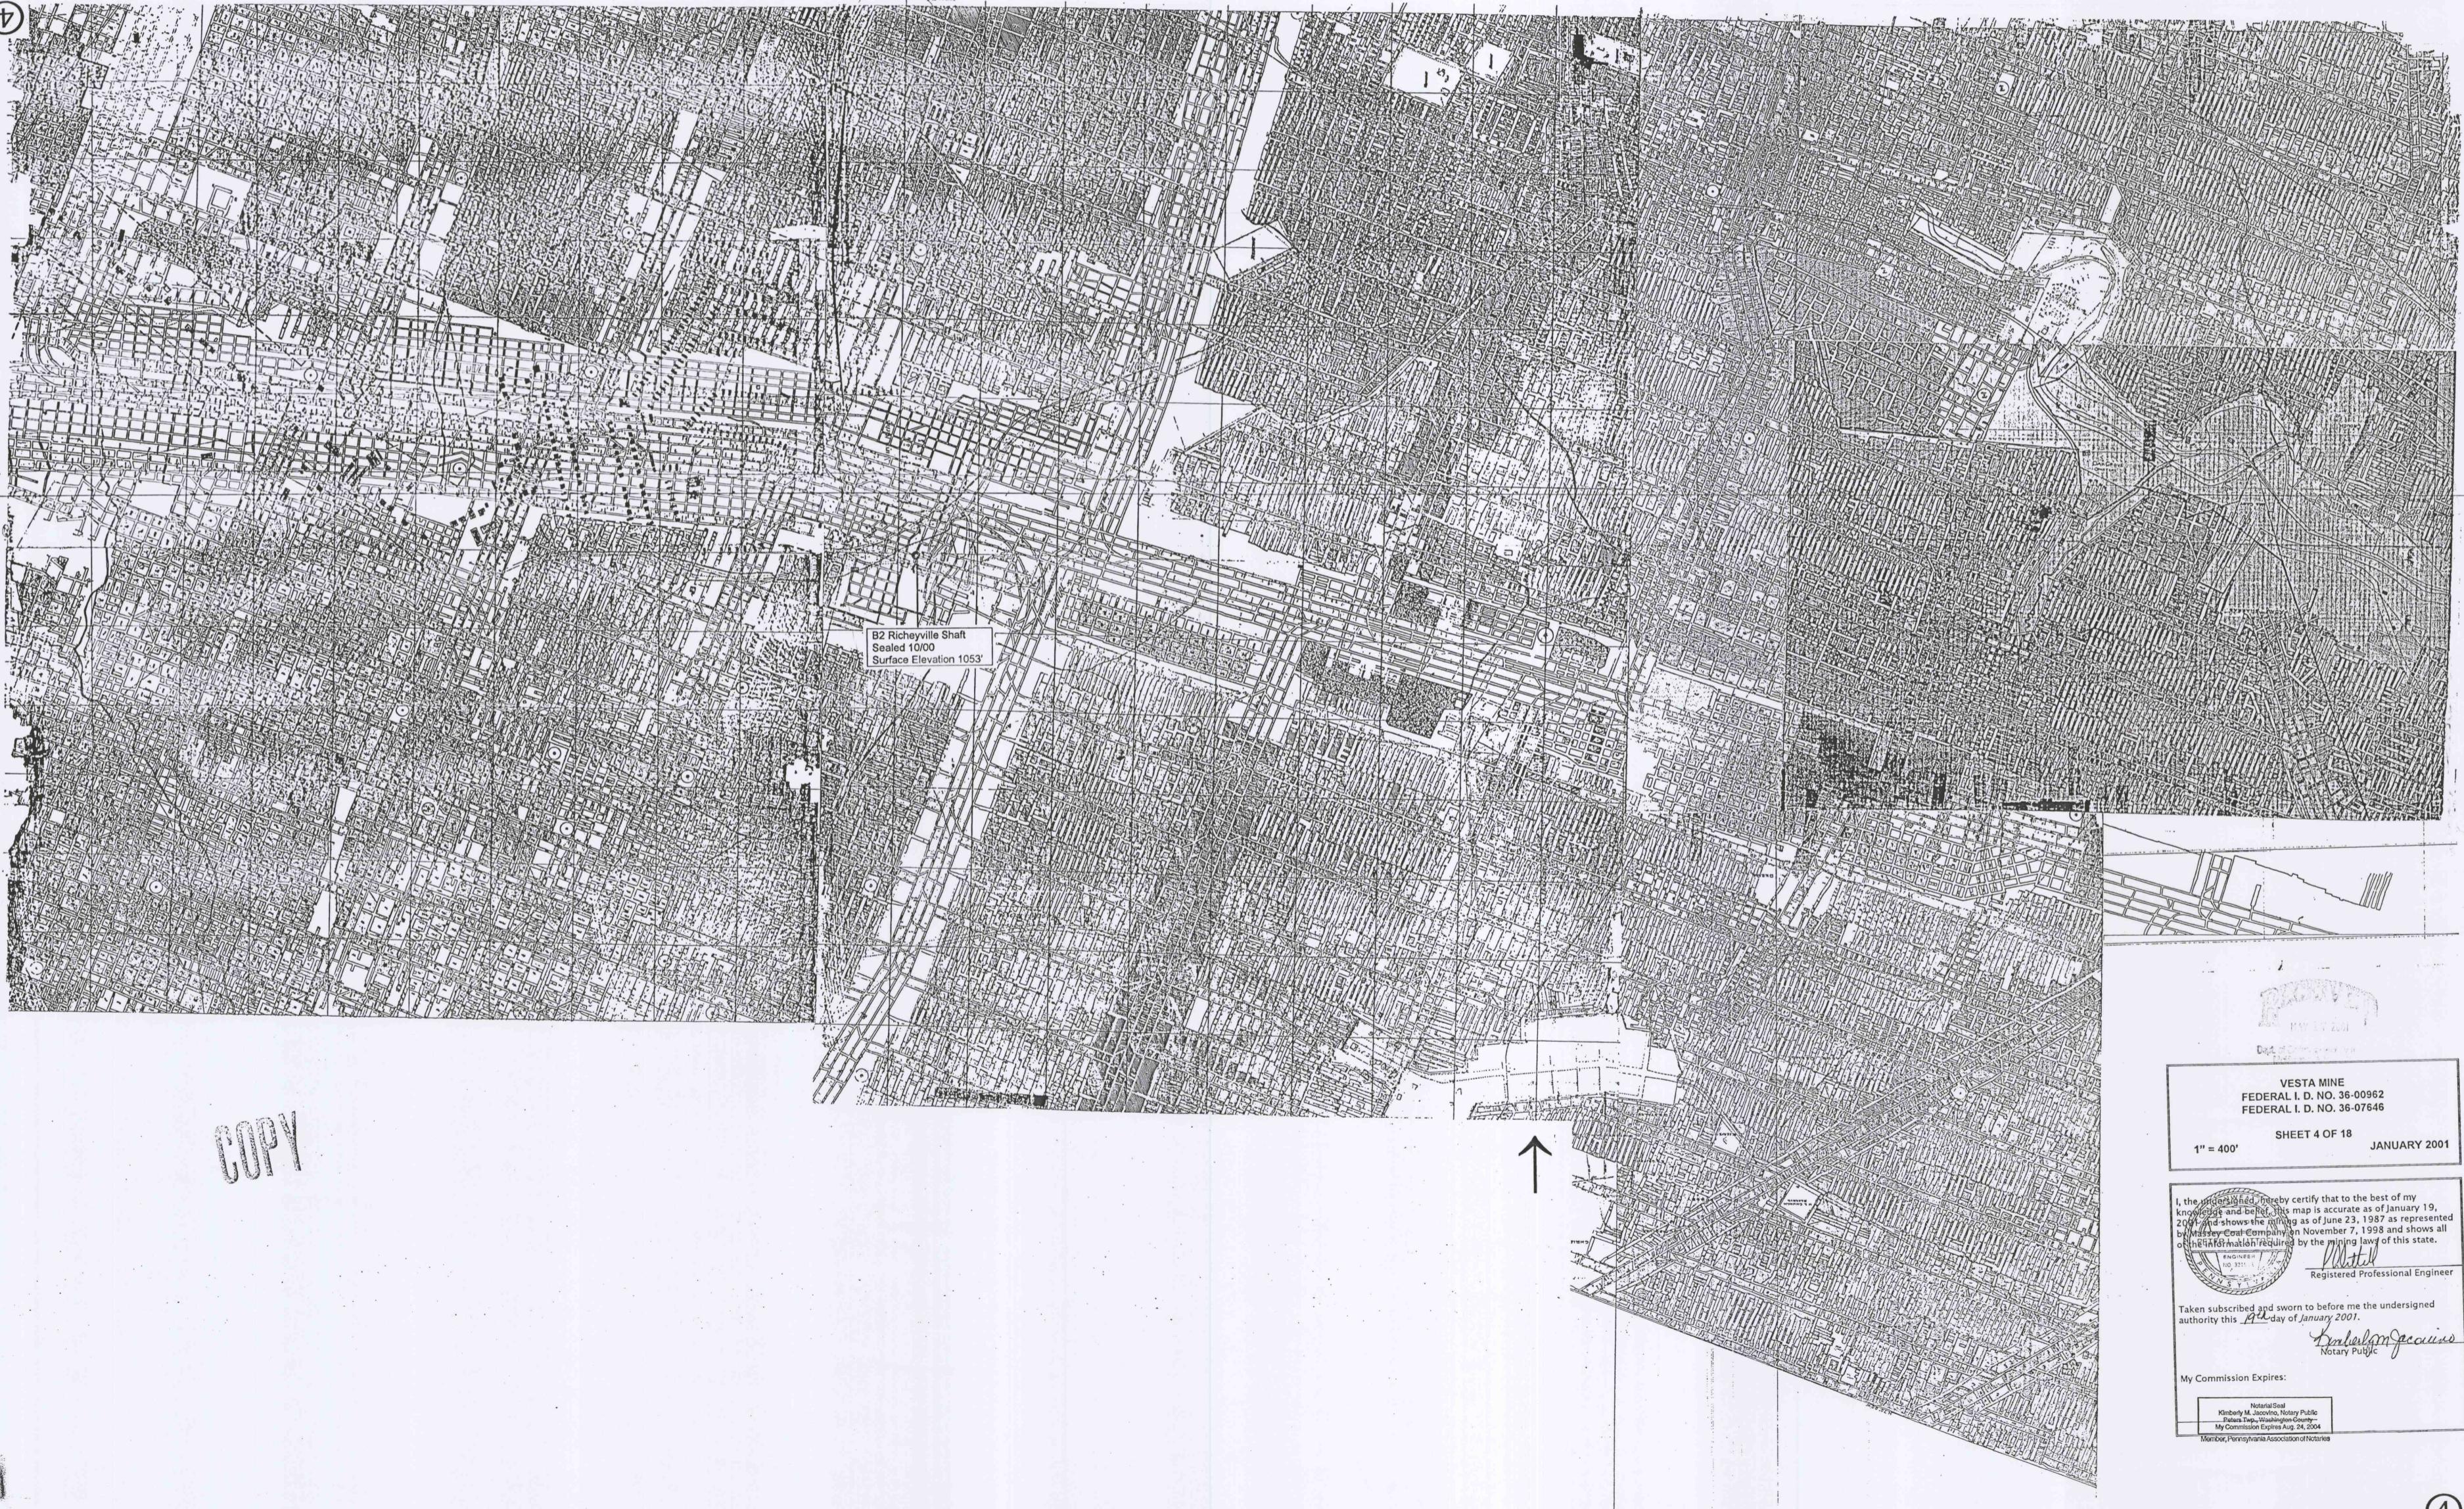

copy

B2 Richeyville Shaft
Sealed 10/00
Surface Elevation 1

VESTA MINE
FEDERAL I. D. NO. 36-00962
FEDERAL I. D. NO. 36-07646

SHEET 4 OF 18

1" = 400' JANUARY 2001

I, the undersigned, hereby certify that to the best of my knowledge and belief, this map is accurate as of January 19, 2004, and shows the mining as of June 23, 1987 as represented by Massey Coal Company on November 7, 1998 and shows all of the information required by the mining laws of this state.

Taken subscribed and sworn to before me the undersigned authority this 19th day of January 2001.

4