


9

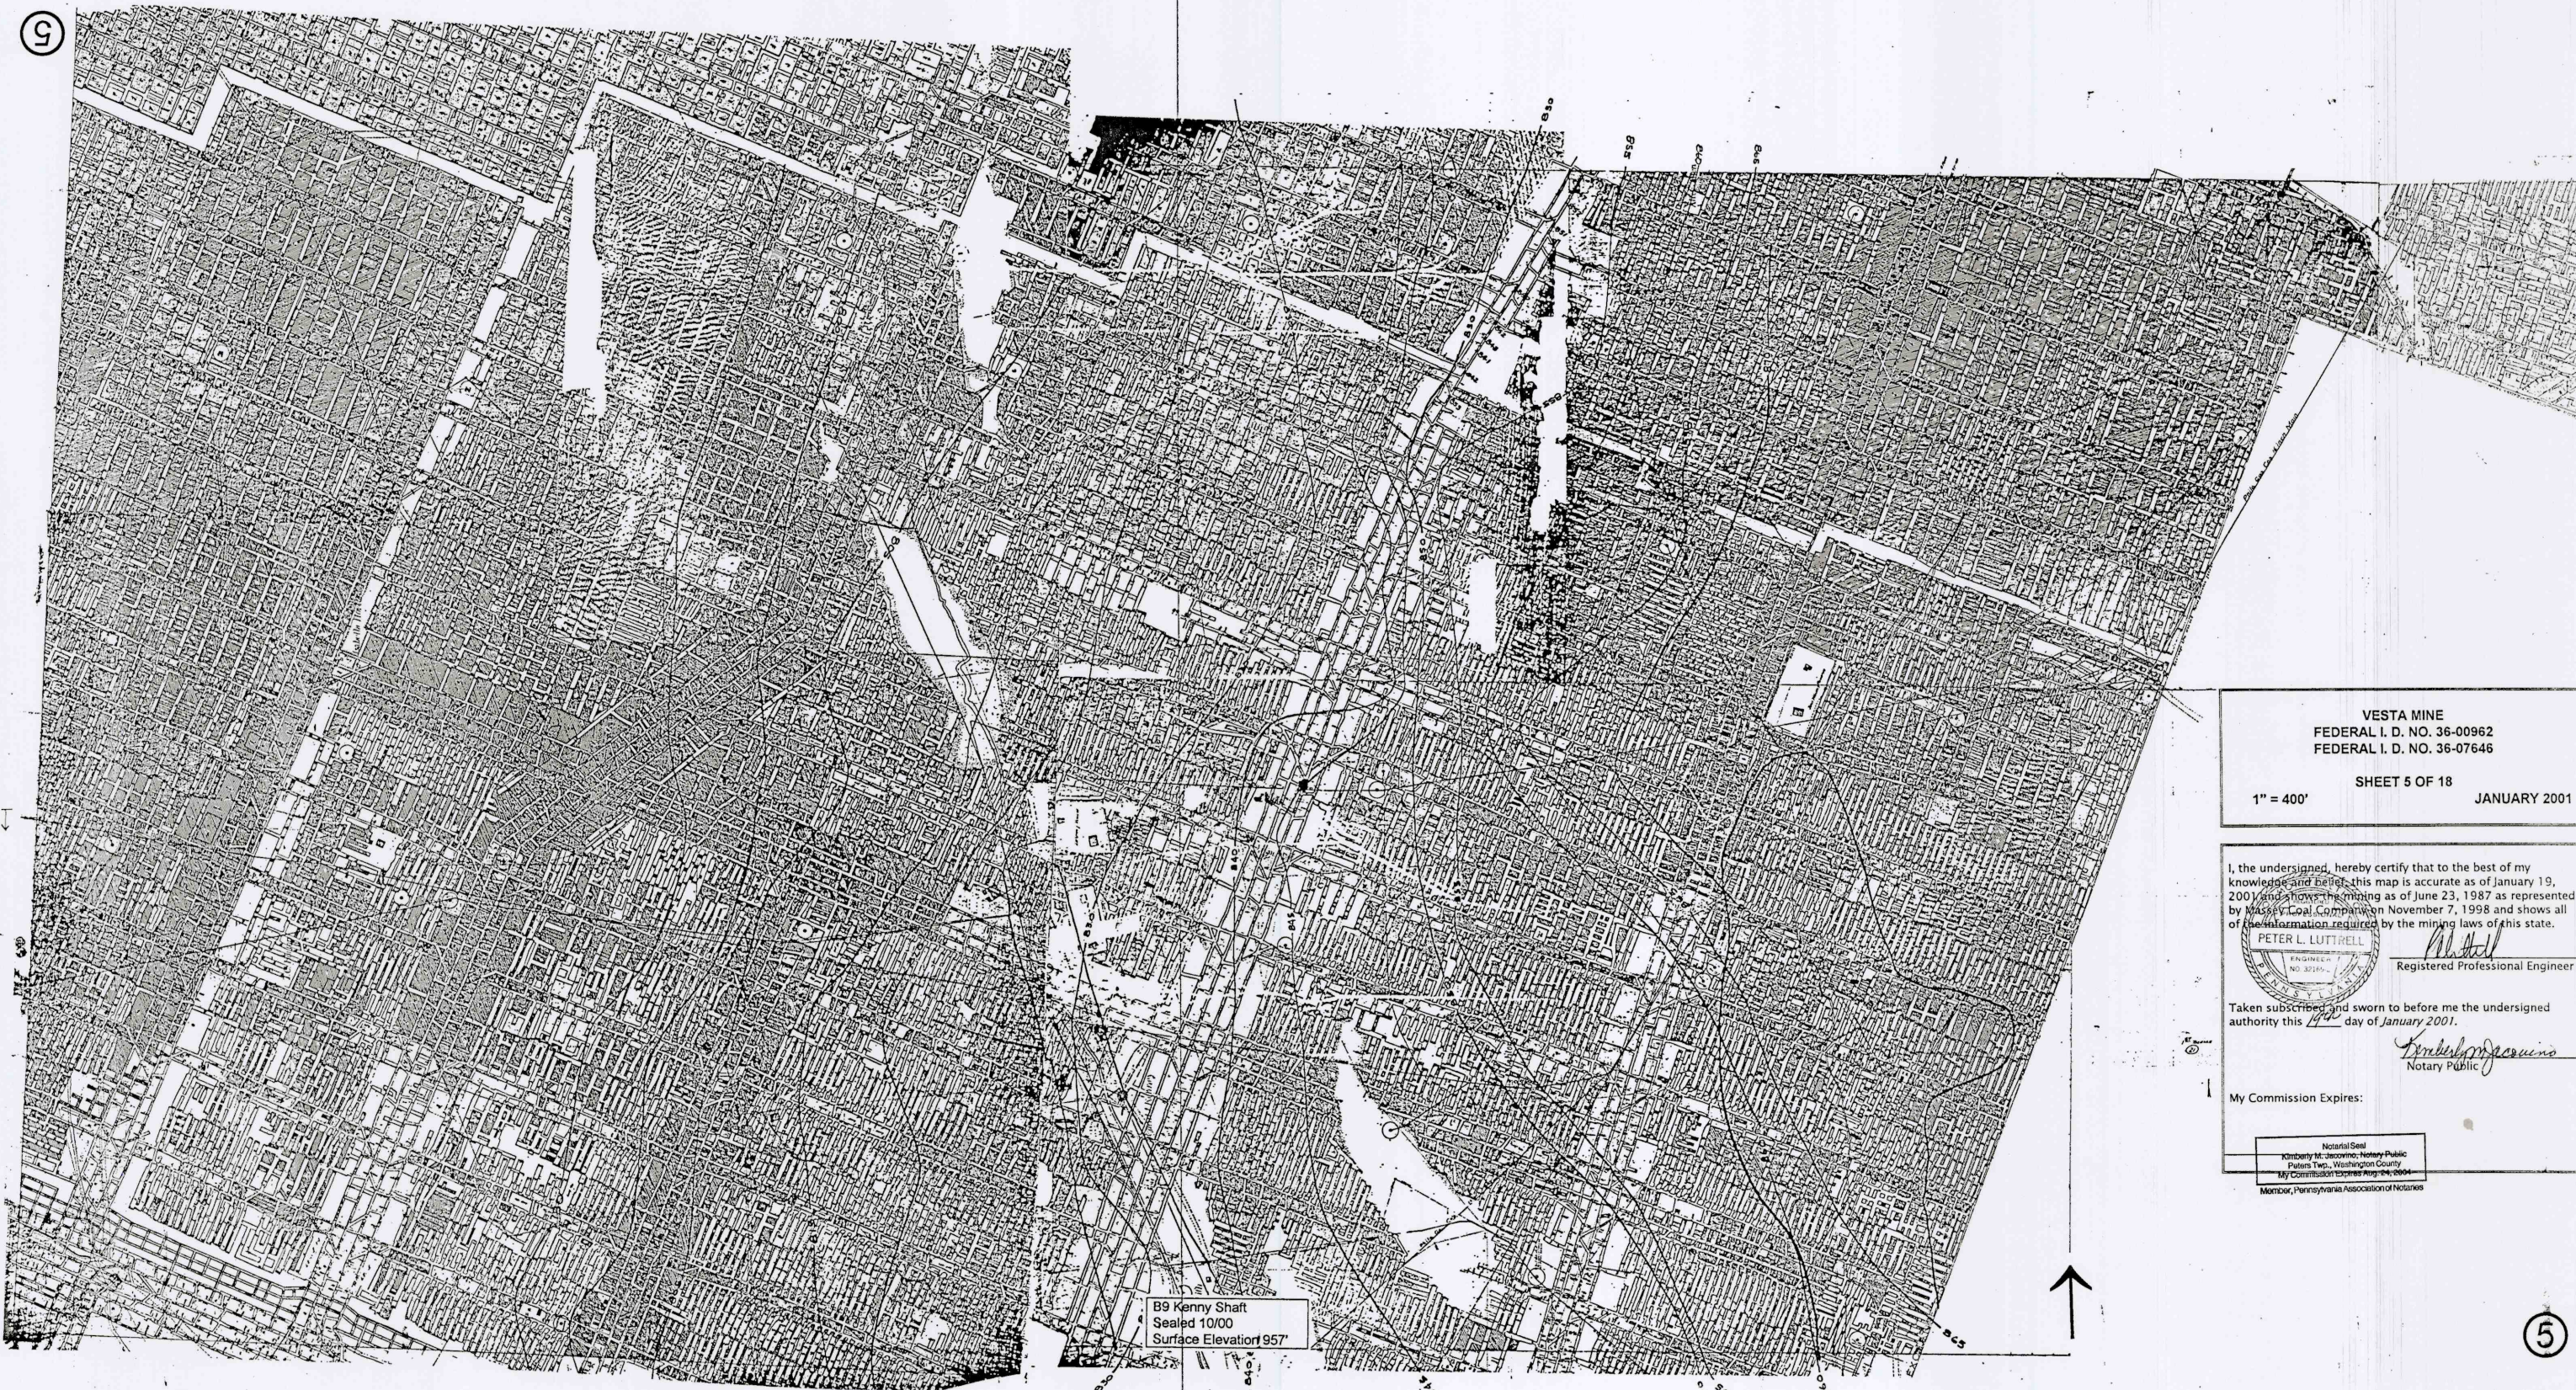

B9 Kenny Shaft  
Sealed 10/00  
Surface Elevation 957'

VESTA MINE  
FEDERAL I. D. NO. 36-00962  
FEDERAL I. D. NO. 36-07646

SHEET 5 OF 18 JANUARY 2001  
1" = 400'

I, the undersigned, hereby certify that to the best of my knowledge and belief, this map is accurate as of January 19, 2001, and shows the mining as of June 23, 1987 as represented by Mass. Coal Company November 7, 1998 and shows all of the information required by the mining laws of this state.

PETER L. LUTHELL  
REGISTERED PROFESSIONAL ENGINEER  

Taken, subscribed and sworn to before me the undersigned authority this 14th day of January, 2001.

*[Signature]*  
Notary Public

My Commission Expires:

Notary Seal  
Notary Public  
Member, Pennsylvania Association of Notaries

5