


PAID
MAY 17 2001
DEPT. OF REVENUE
HARRISBURG, PA.

9

COPY

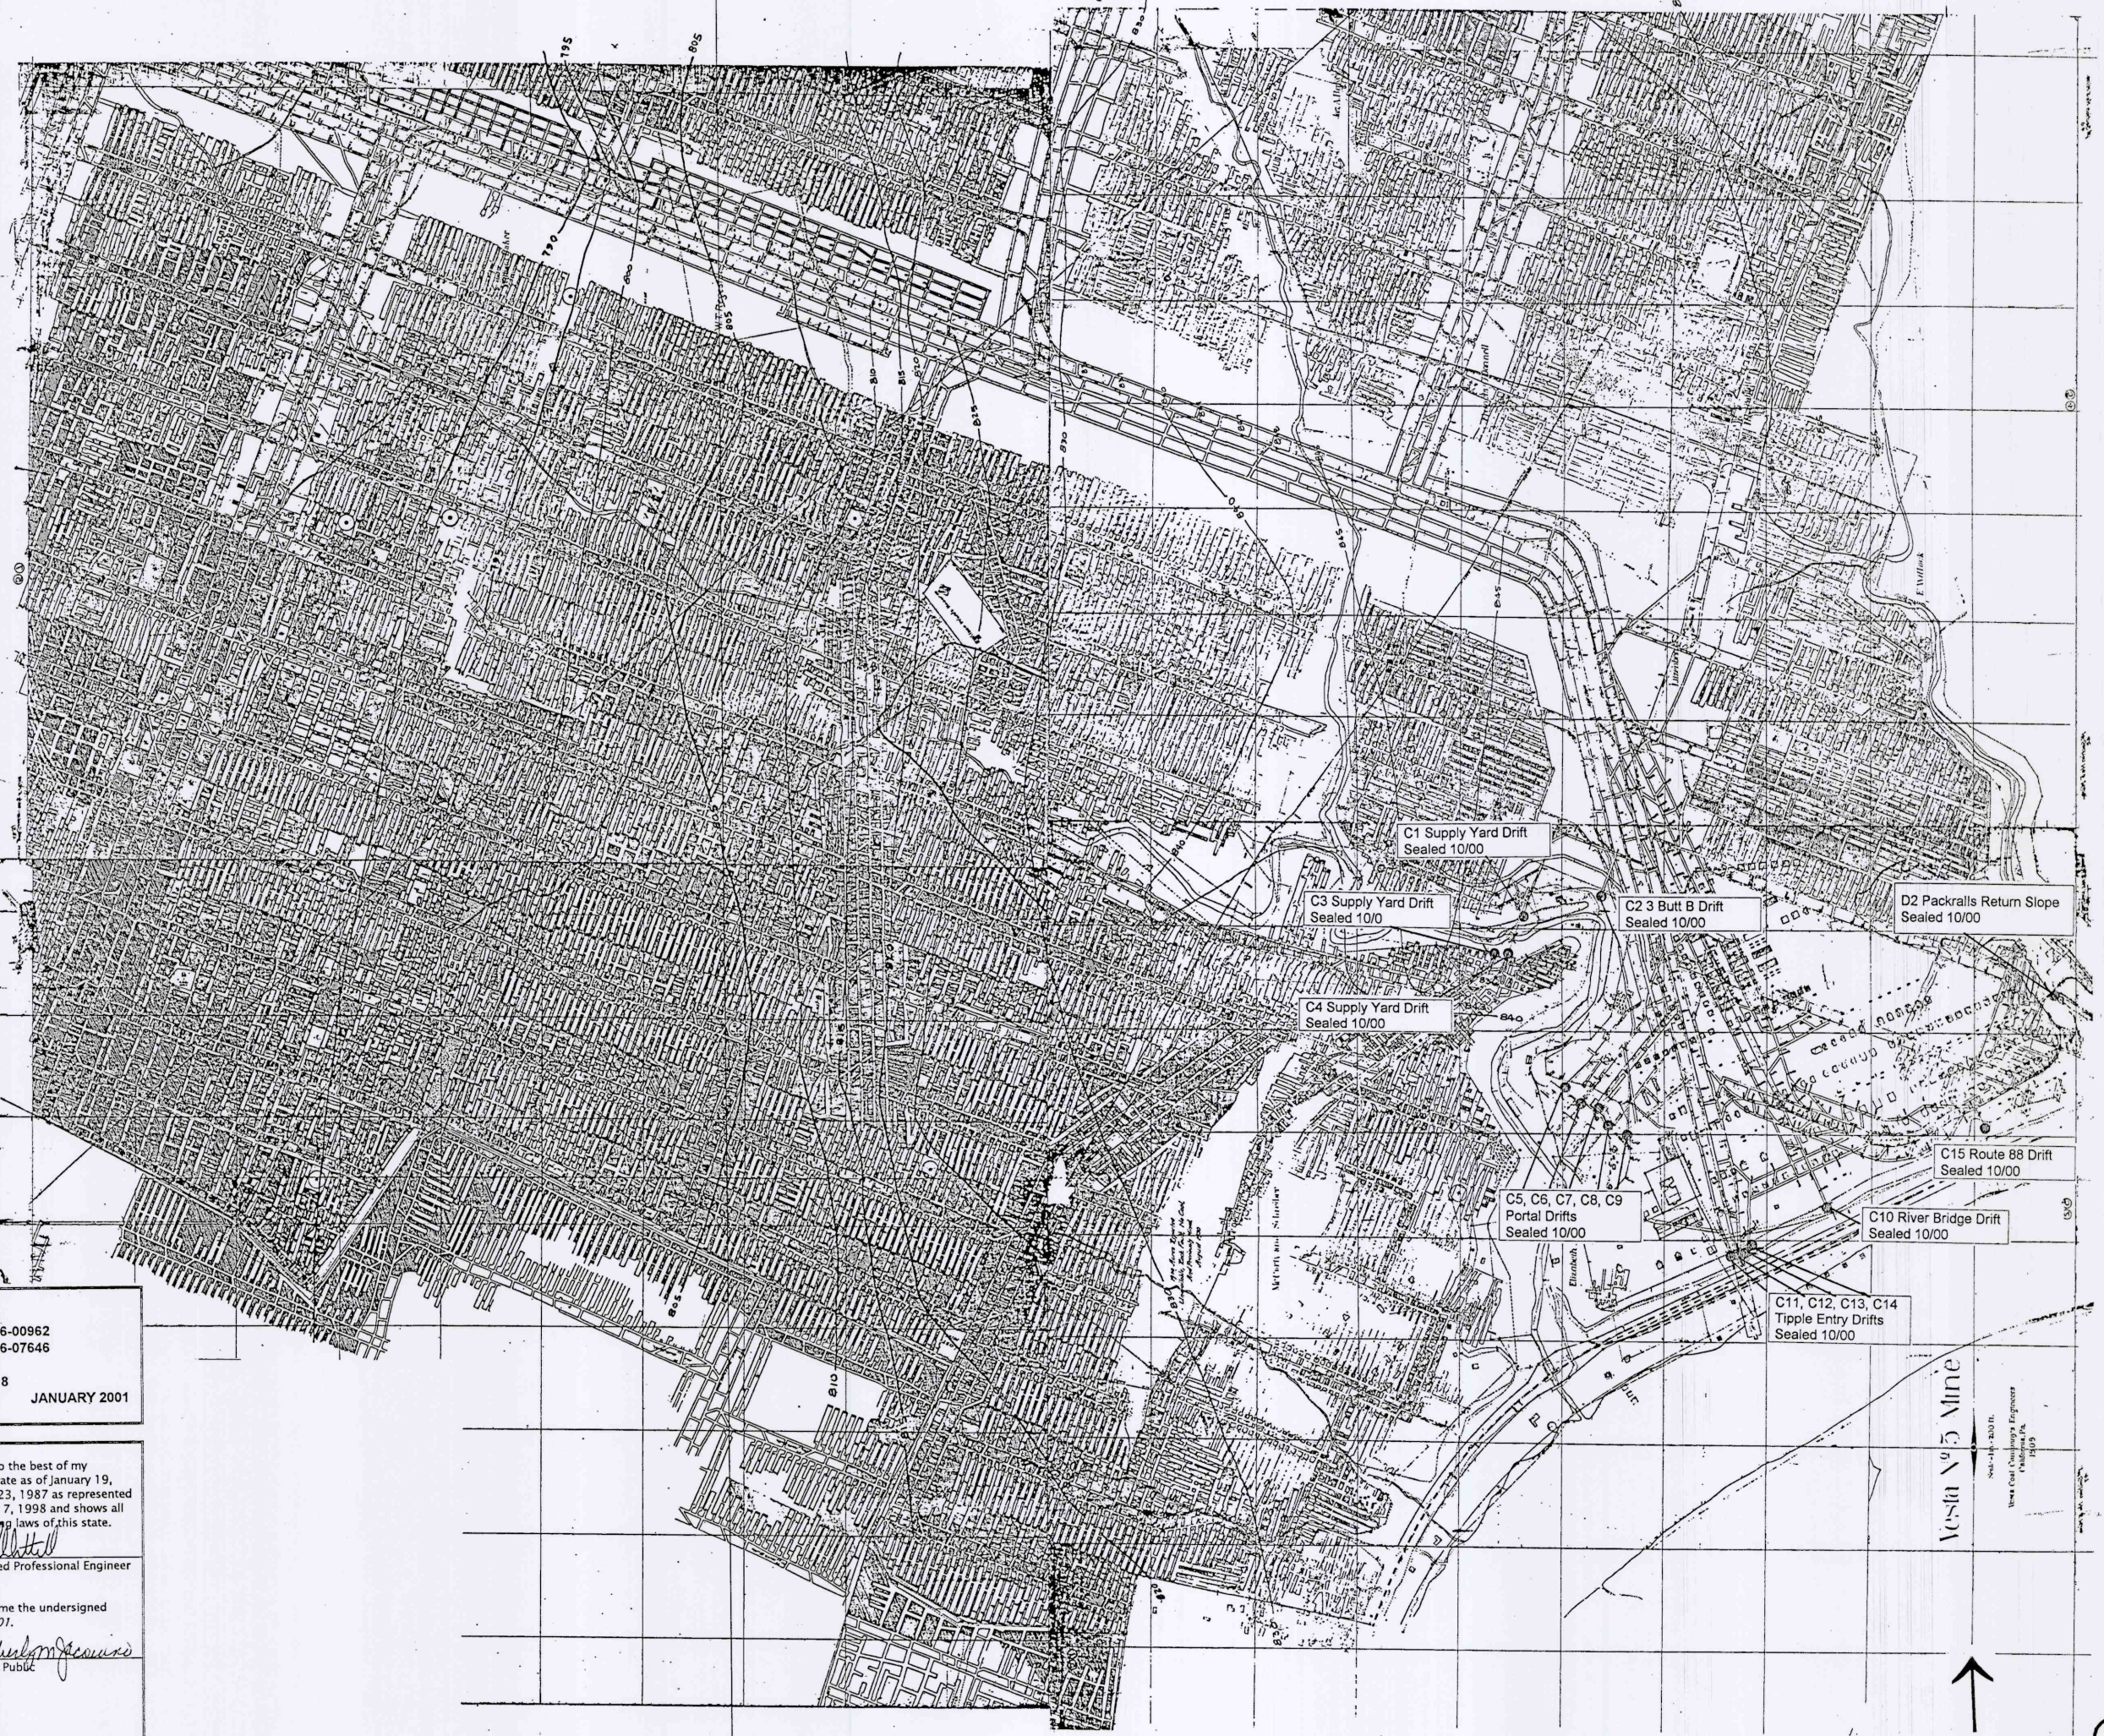

6

VESTA MINE
FEDERAL I. D. NO. 36-00962
FEDERAL I. D. NO. 36-07646

SHEET 6 OF 18
JANUARY 2001

1" = 400'

I, the undersigned, hereby certify that to the best of my knowledge and belief, this map is accurate as of January 19, 2001 and shows the mining as of June 23, 1987 as represented by Masses Coal Corporation on November 7, 1998 and shows all of the information required by the mining laws of this state.

PETER L. LUTTRELL
ENGINEER
Registered Professional Engineer

Taken and sworn to before me the undersigned authority this 14th day of January 2001.

[Signature]
Notary Public

My Commission Expires:

Notary Seal
Katherine M. Johnson, Notary Public
Potomac Falls, Washington County
My Commission Expires Aug. 24, 2004
Member, Pennsylvania Association of Notaries