


MAY 17 2001  
Dept. of Environmental Protection  
Mining Section

8

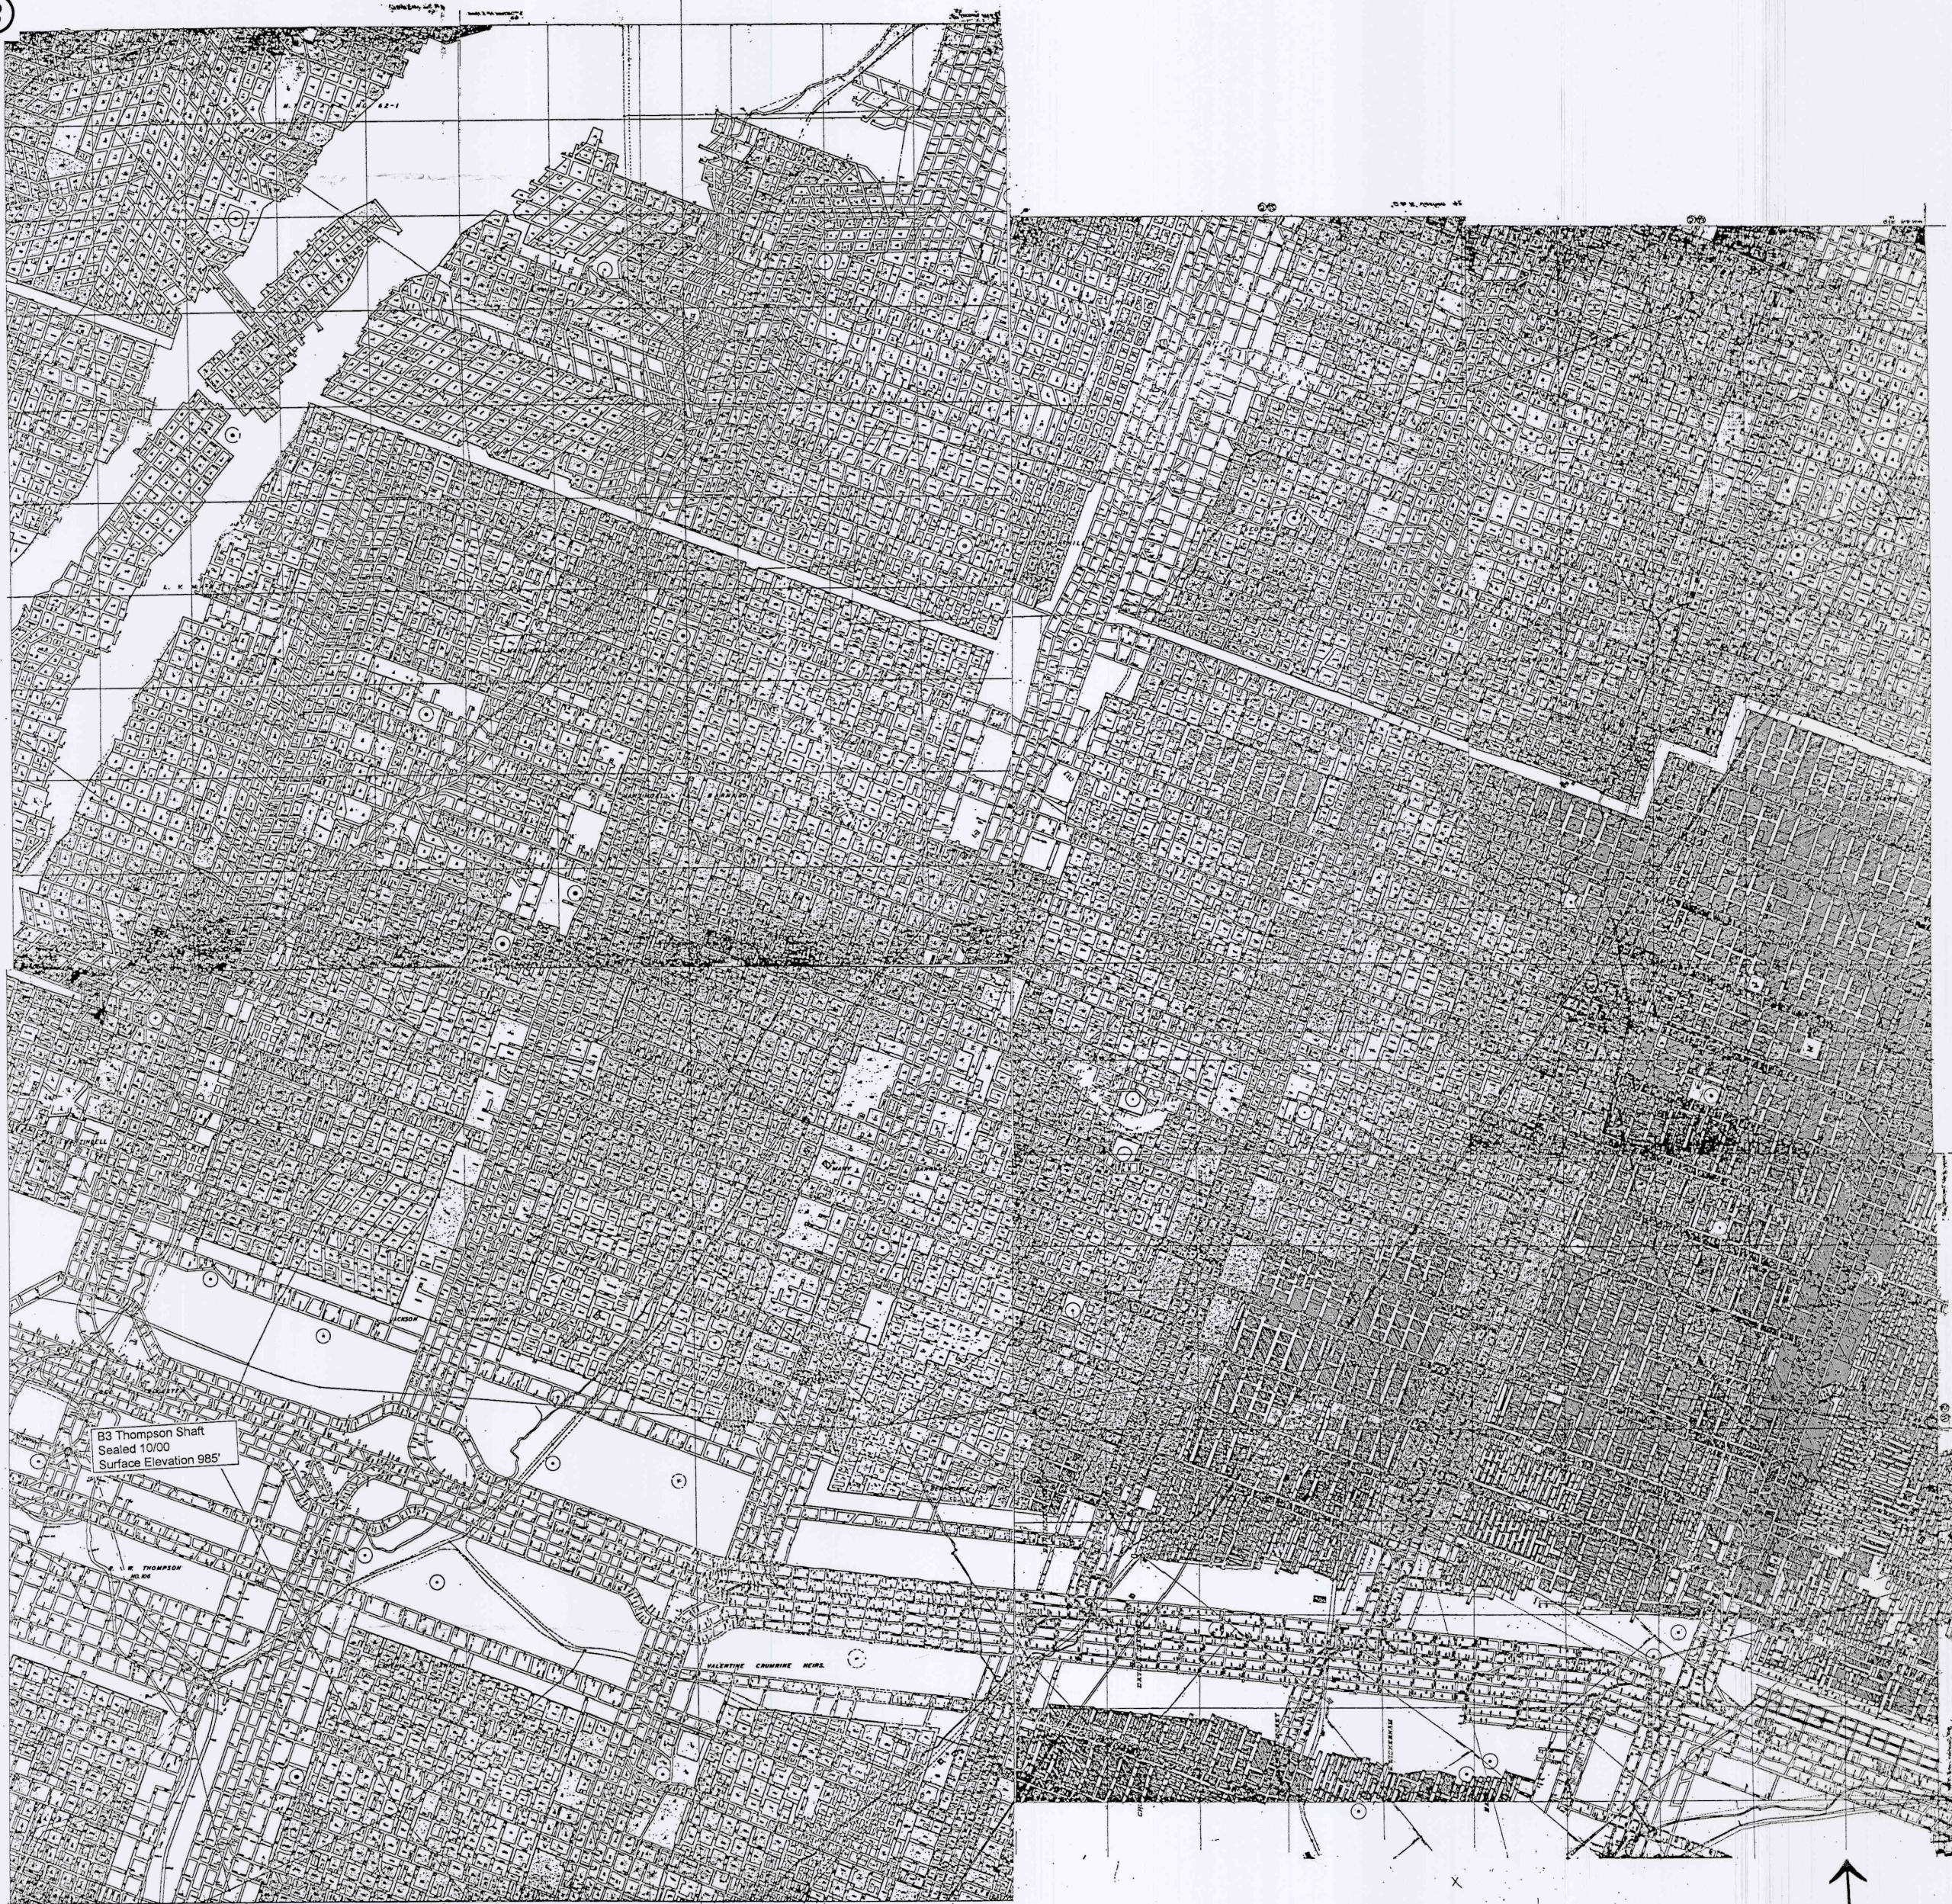

COPY

VESTA MINE  
FEDERAL I. D. NO. 38-00962  
FEDERAL I. D. NO. 38-07646  
SHEET 8 OF 18  
1" = 400' JANUARY 2001

I, the undersigned, hereby certify that to the best of my knowledge and belief, this map is accurate as of January 19, 2001, and shows the following as of June 23, 1987 as represented by Macey Coal Corporation on November 7, 1998 and shows all of the information required by the mining laws of this state.

PETER L. LUTTRELL  
Registered Professional Engineer  
Taken and sworn to before me the undersigned authority this 17th day of January 2001.  
Notary Public

My Commission Expires:  
Notary Public  
Katherine M. Jaramila, Notary Public  
Palmdale, Washington County  
My Commission Expires June 18, 2004  
Member, Pennsylvania Association of Notaries

↑

8