


177 to 183

JOHN FULLER

Sheet 12

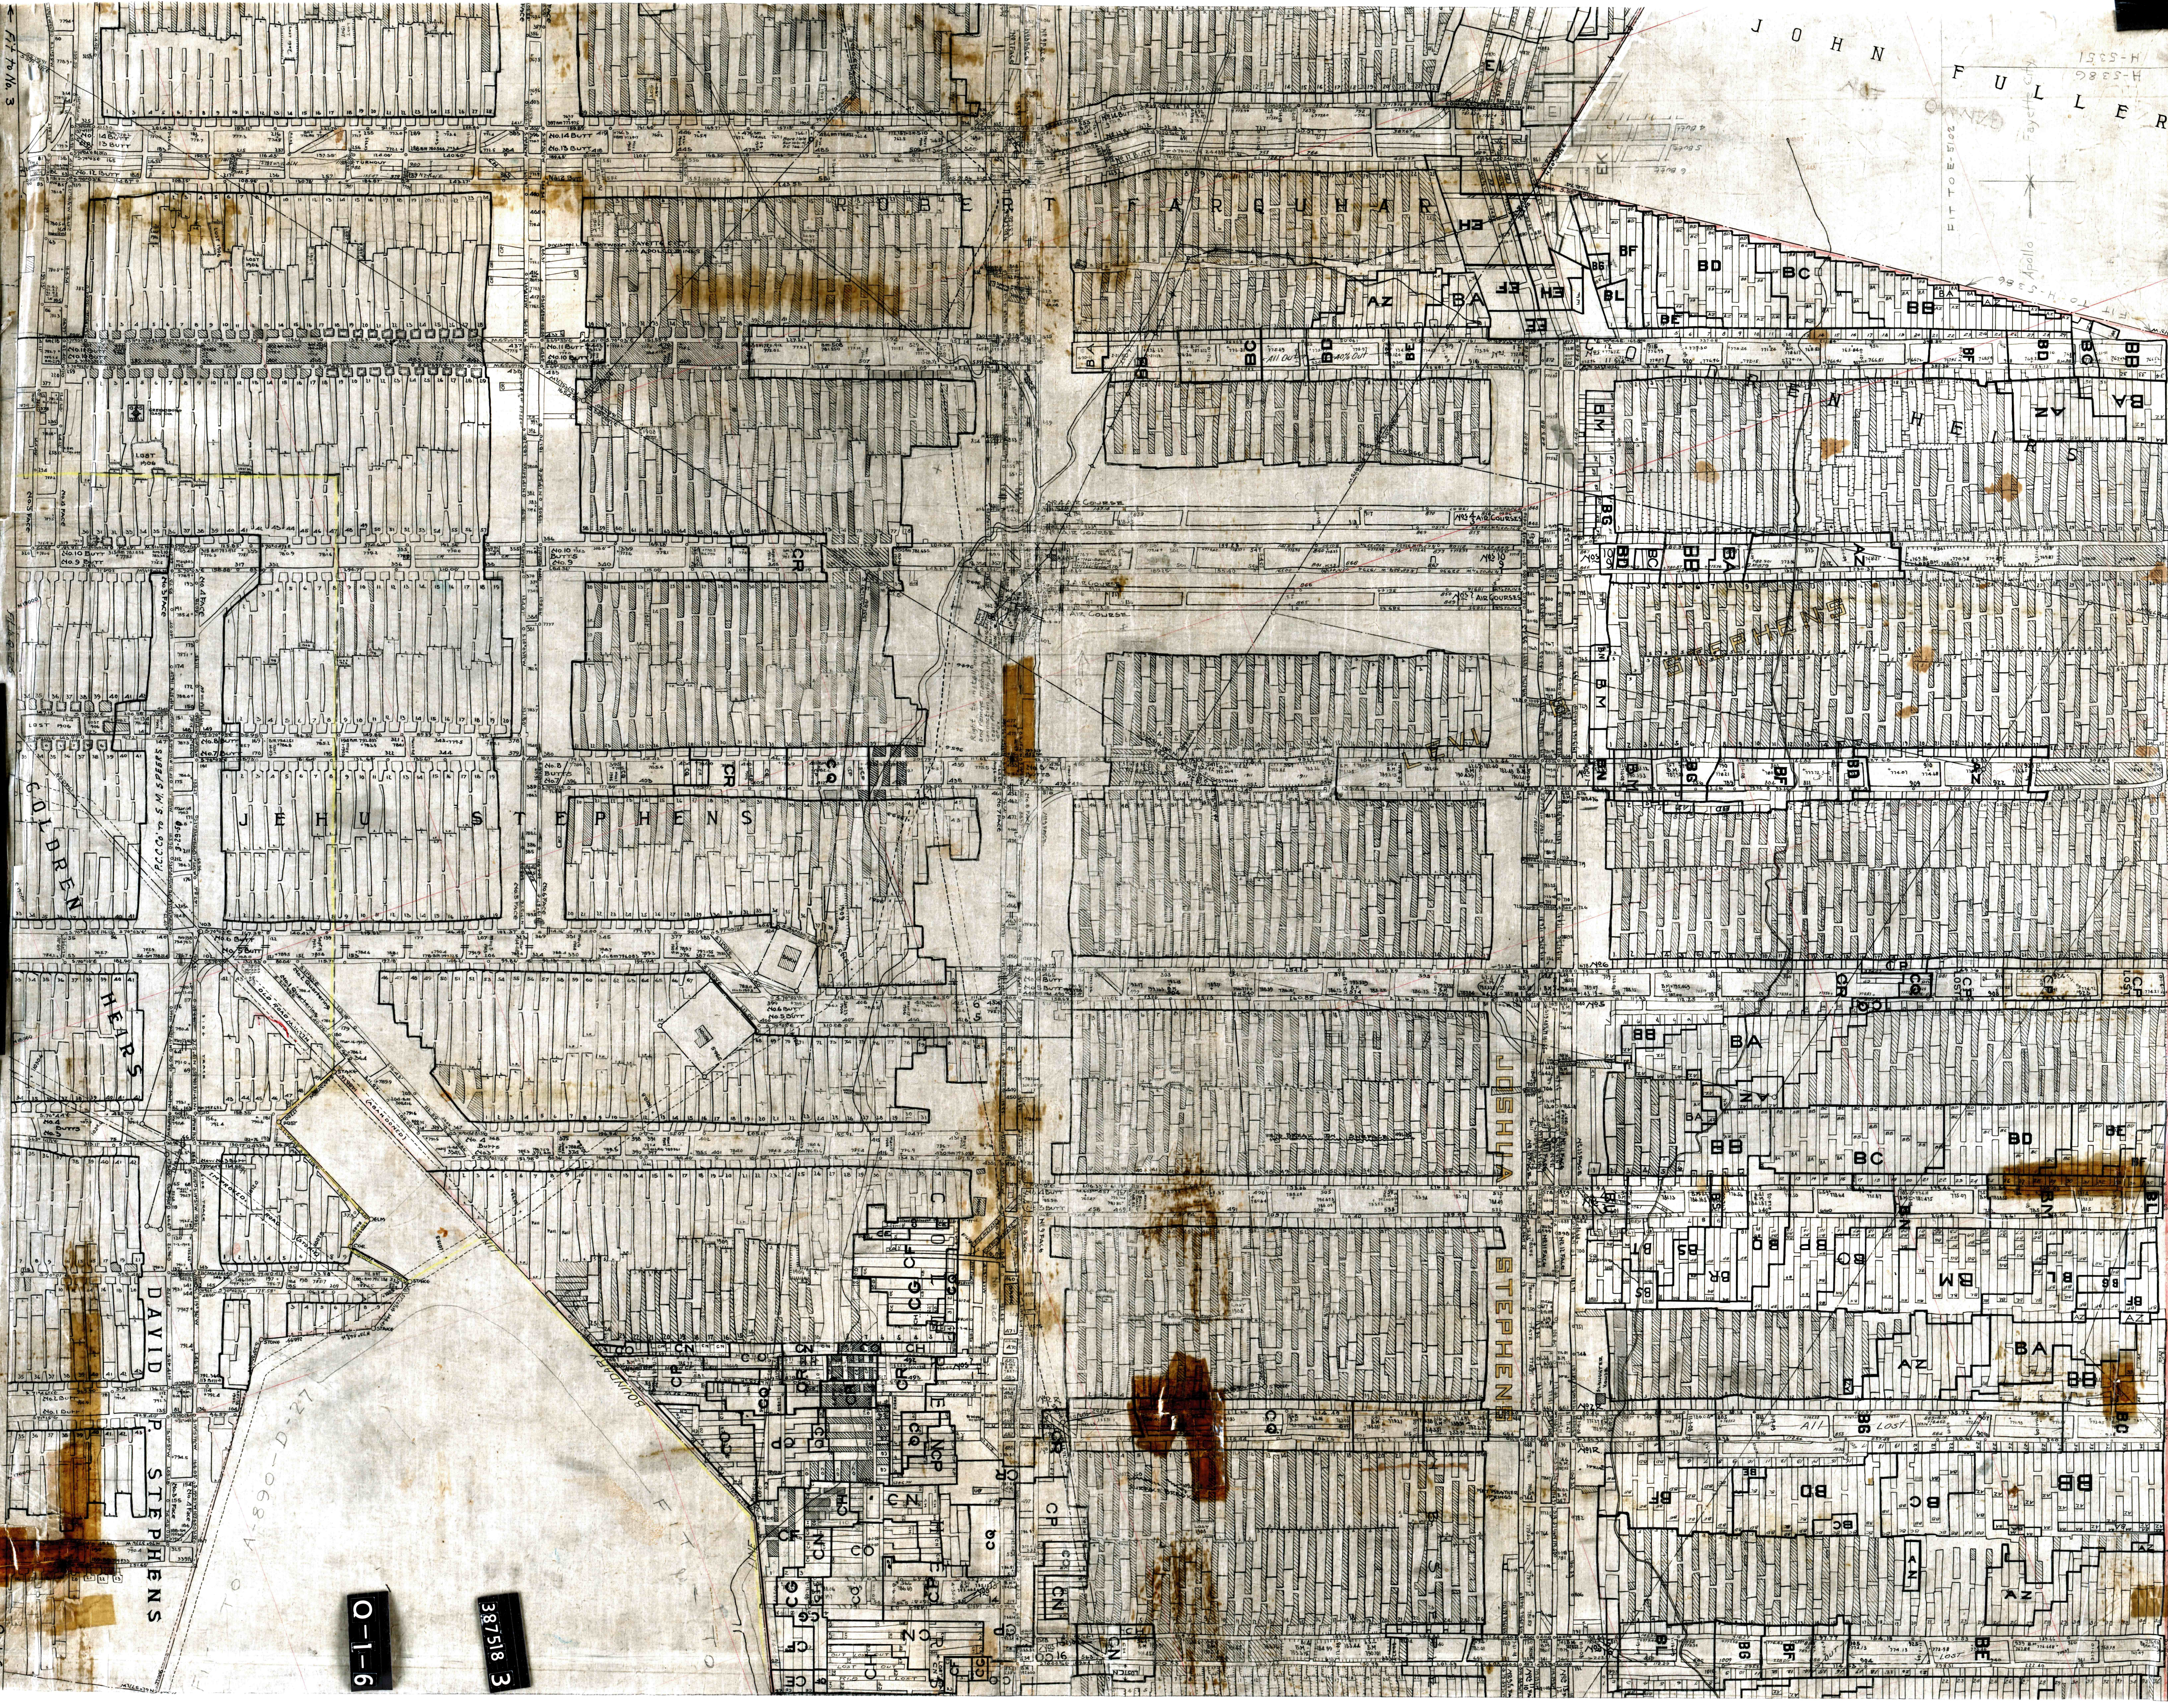

O-1-6

387518 3

TO 1-890-D-27

DAVID STEPHENS

JOSHUA STEPHENS

COLDREN

HEARS

Sheet 12