



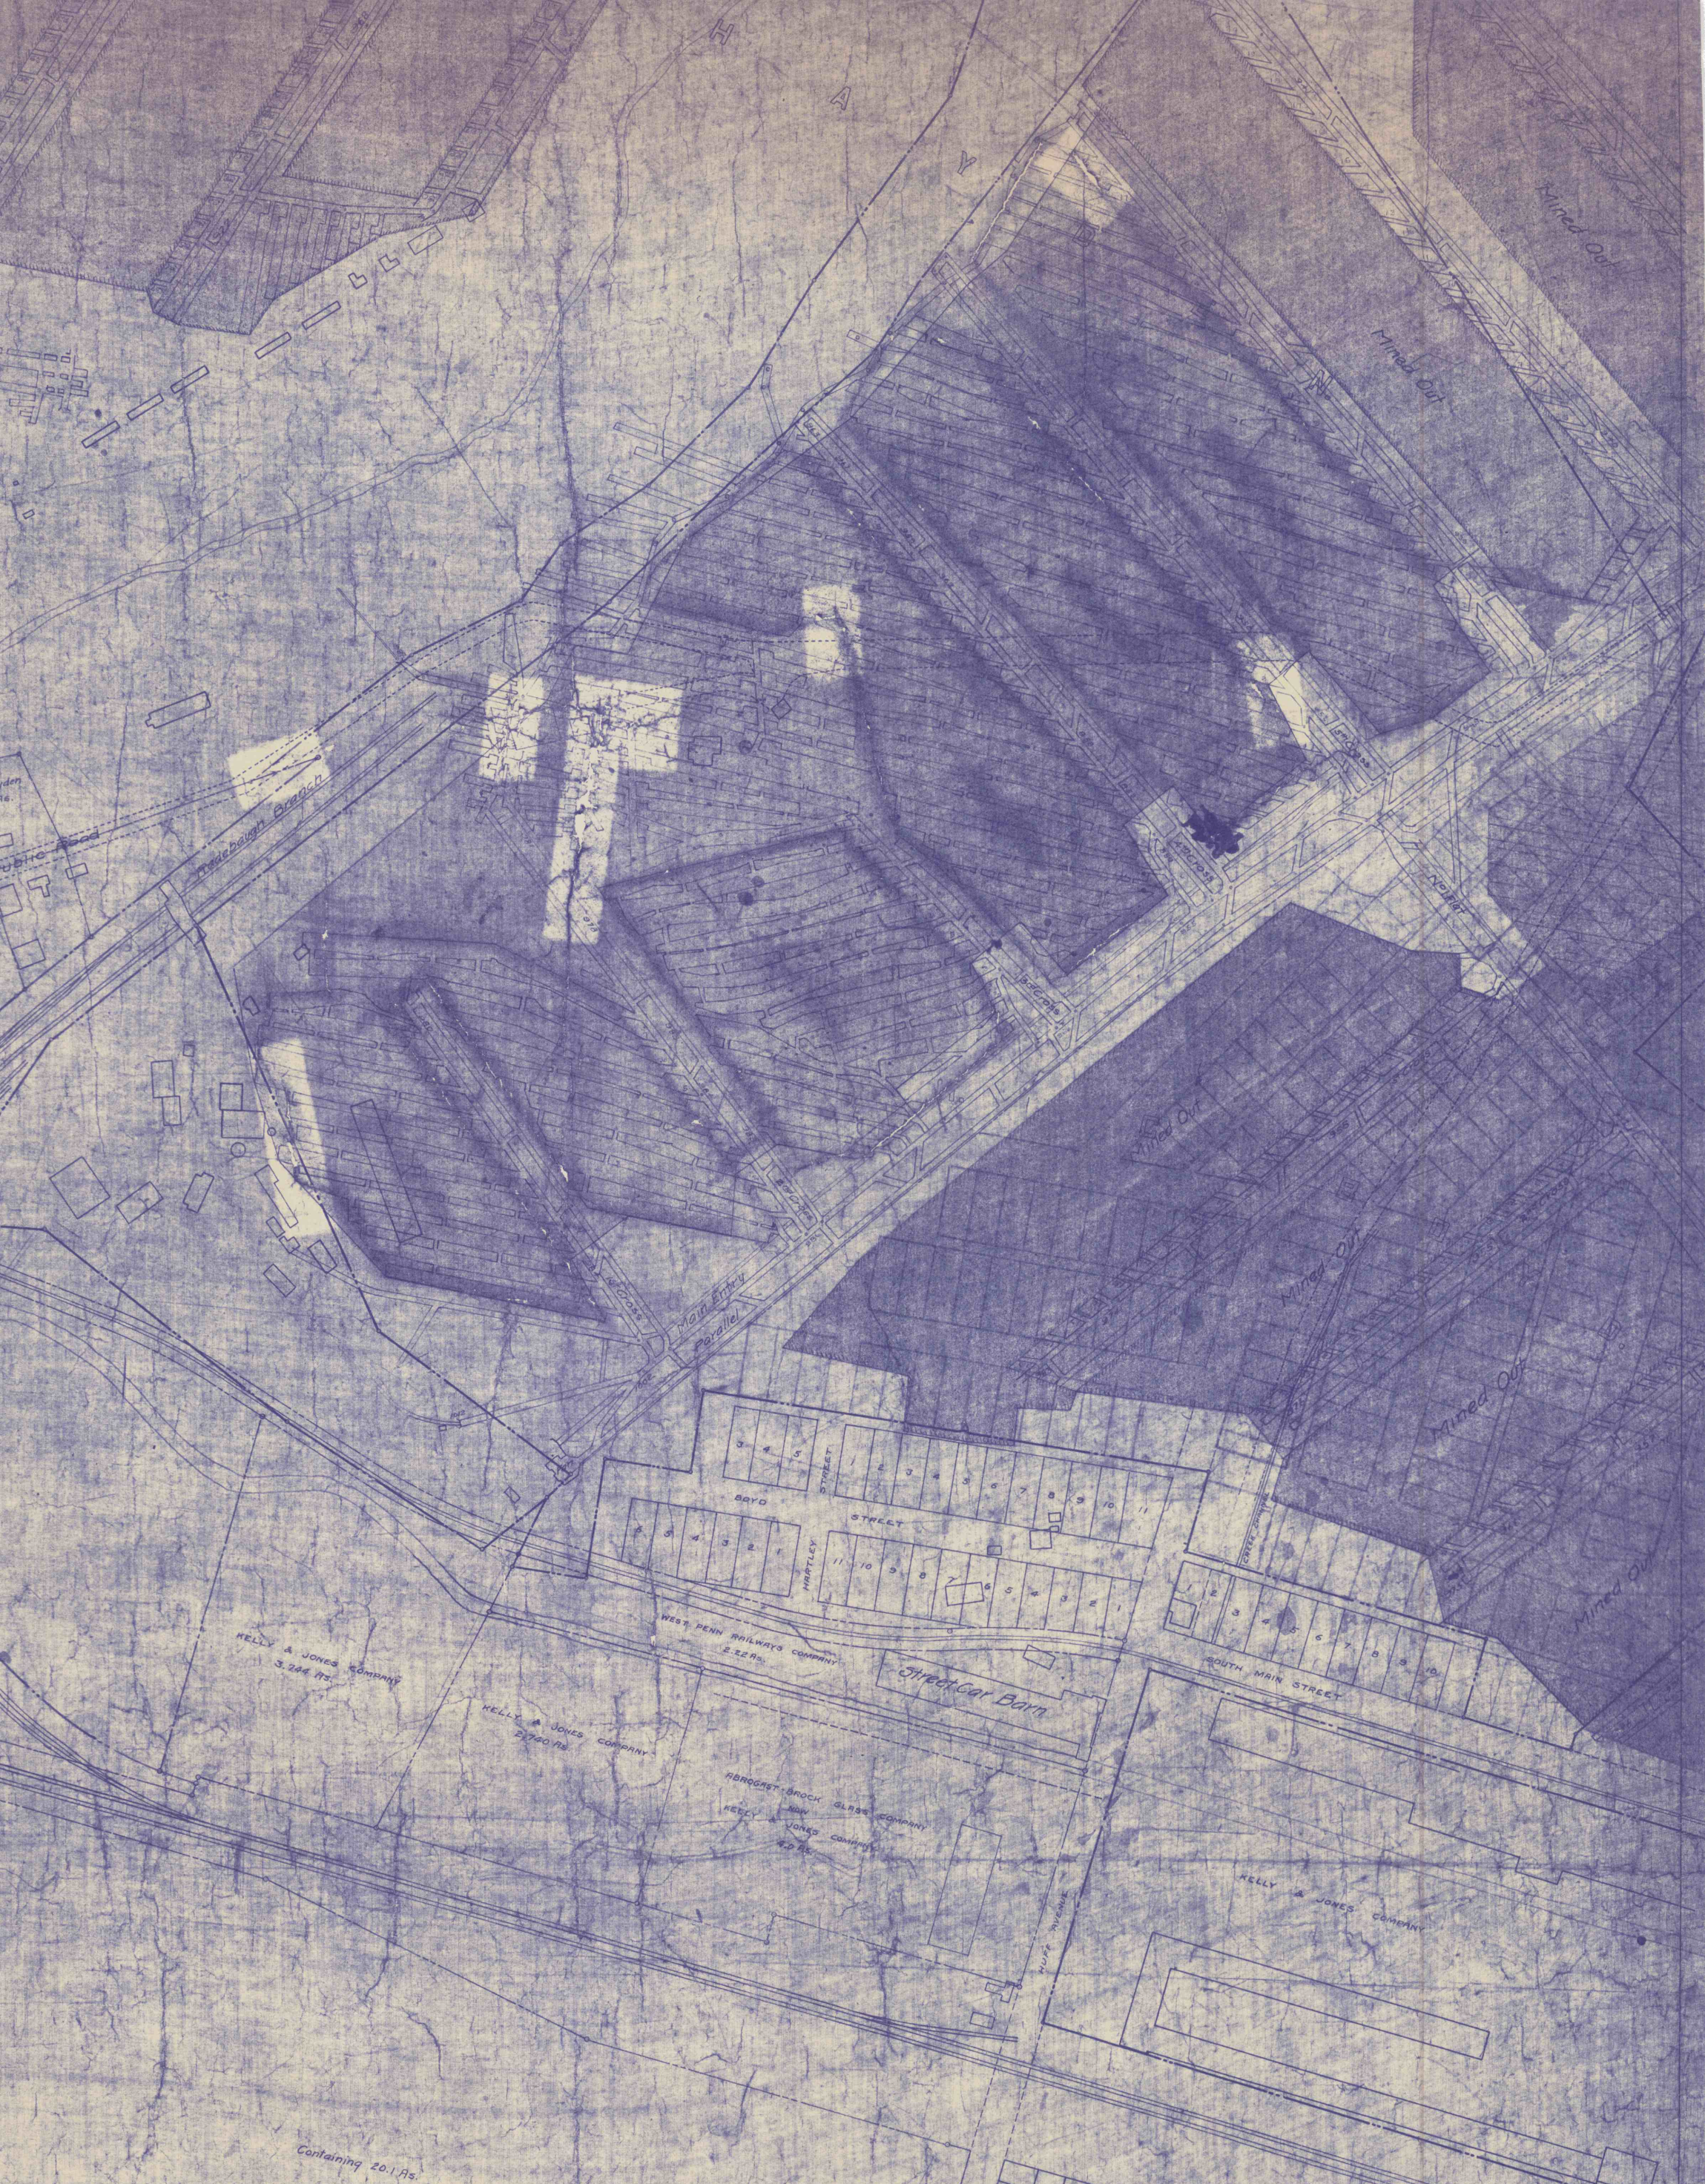

MAP OF
K.C. & C. CO'S GBG. No. 2 MINE
SITUATE NEAR
COUNTY HOME JCT., ON HEMP BR., S.W.P.R.R.
HEMPFIELD TWP., WESTMORELAND CO., PA.
SCALE: 1" = 100'

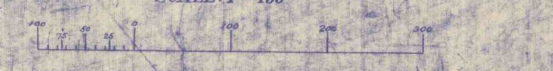

NOTE: WORKINGS SHOWN AS PER SURVEY OF
VENTILATION INDICATED THUS:
DIRECTION OF CURRENT
DOOR
STOPPING

ENGINEER,
GREENSBURG, PA.