


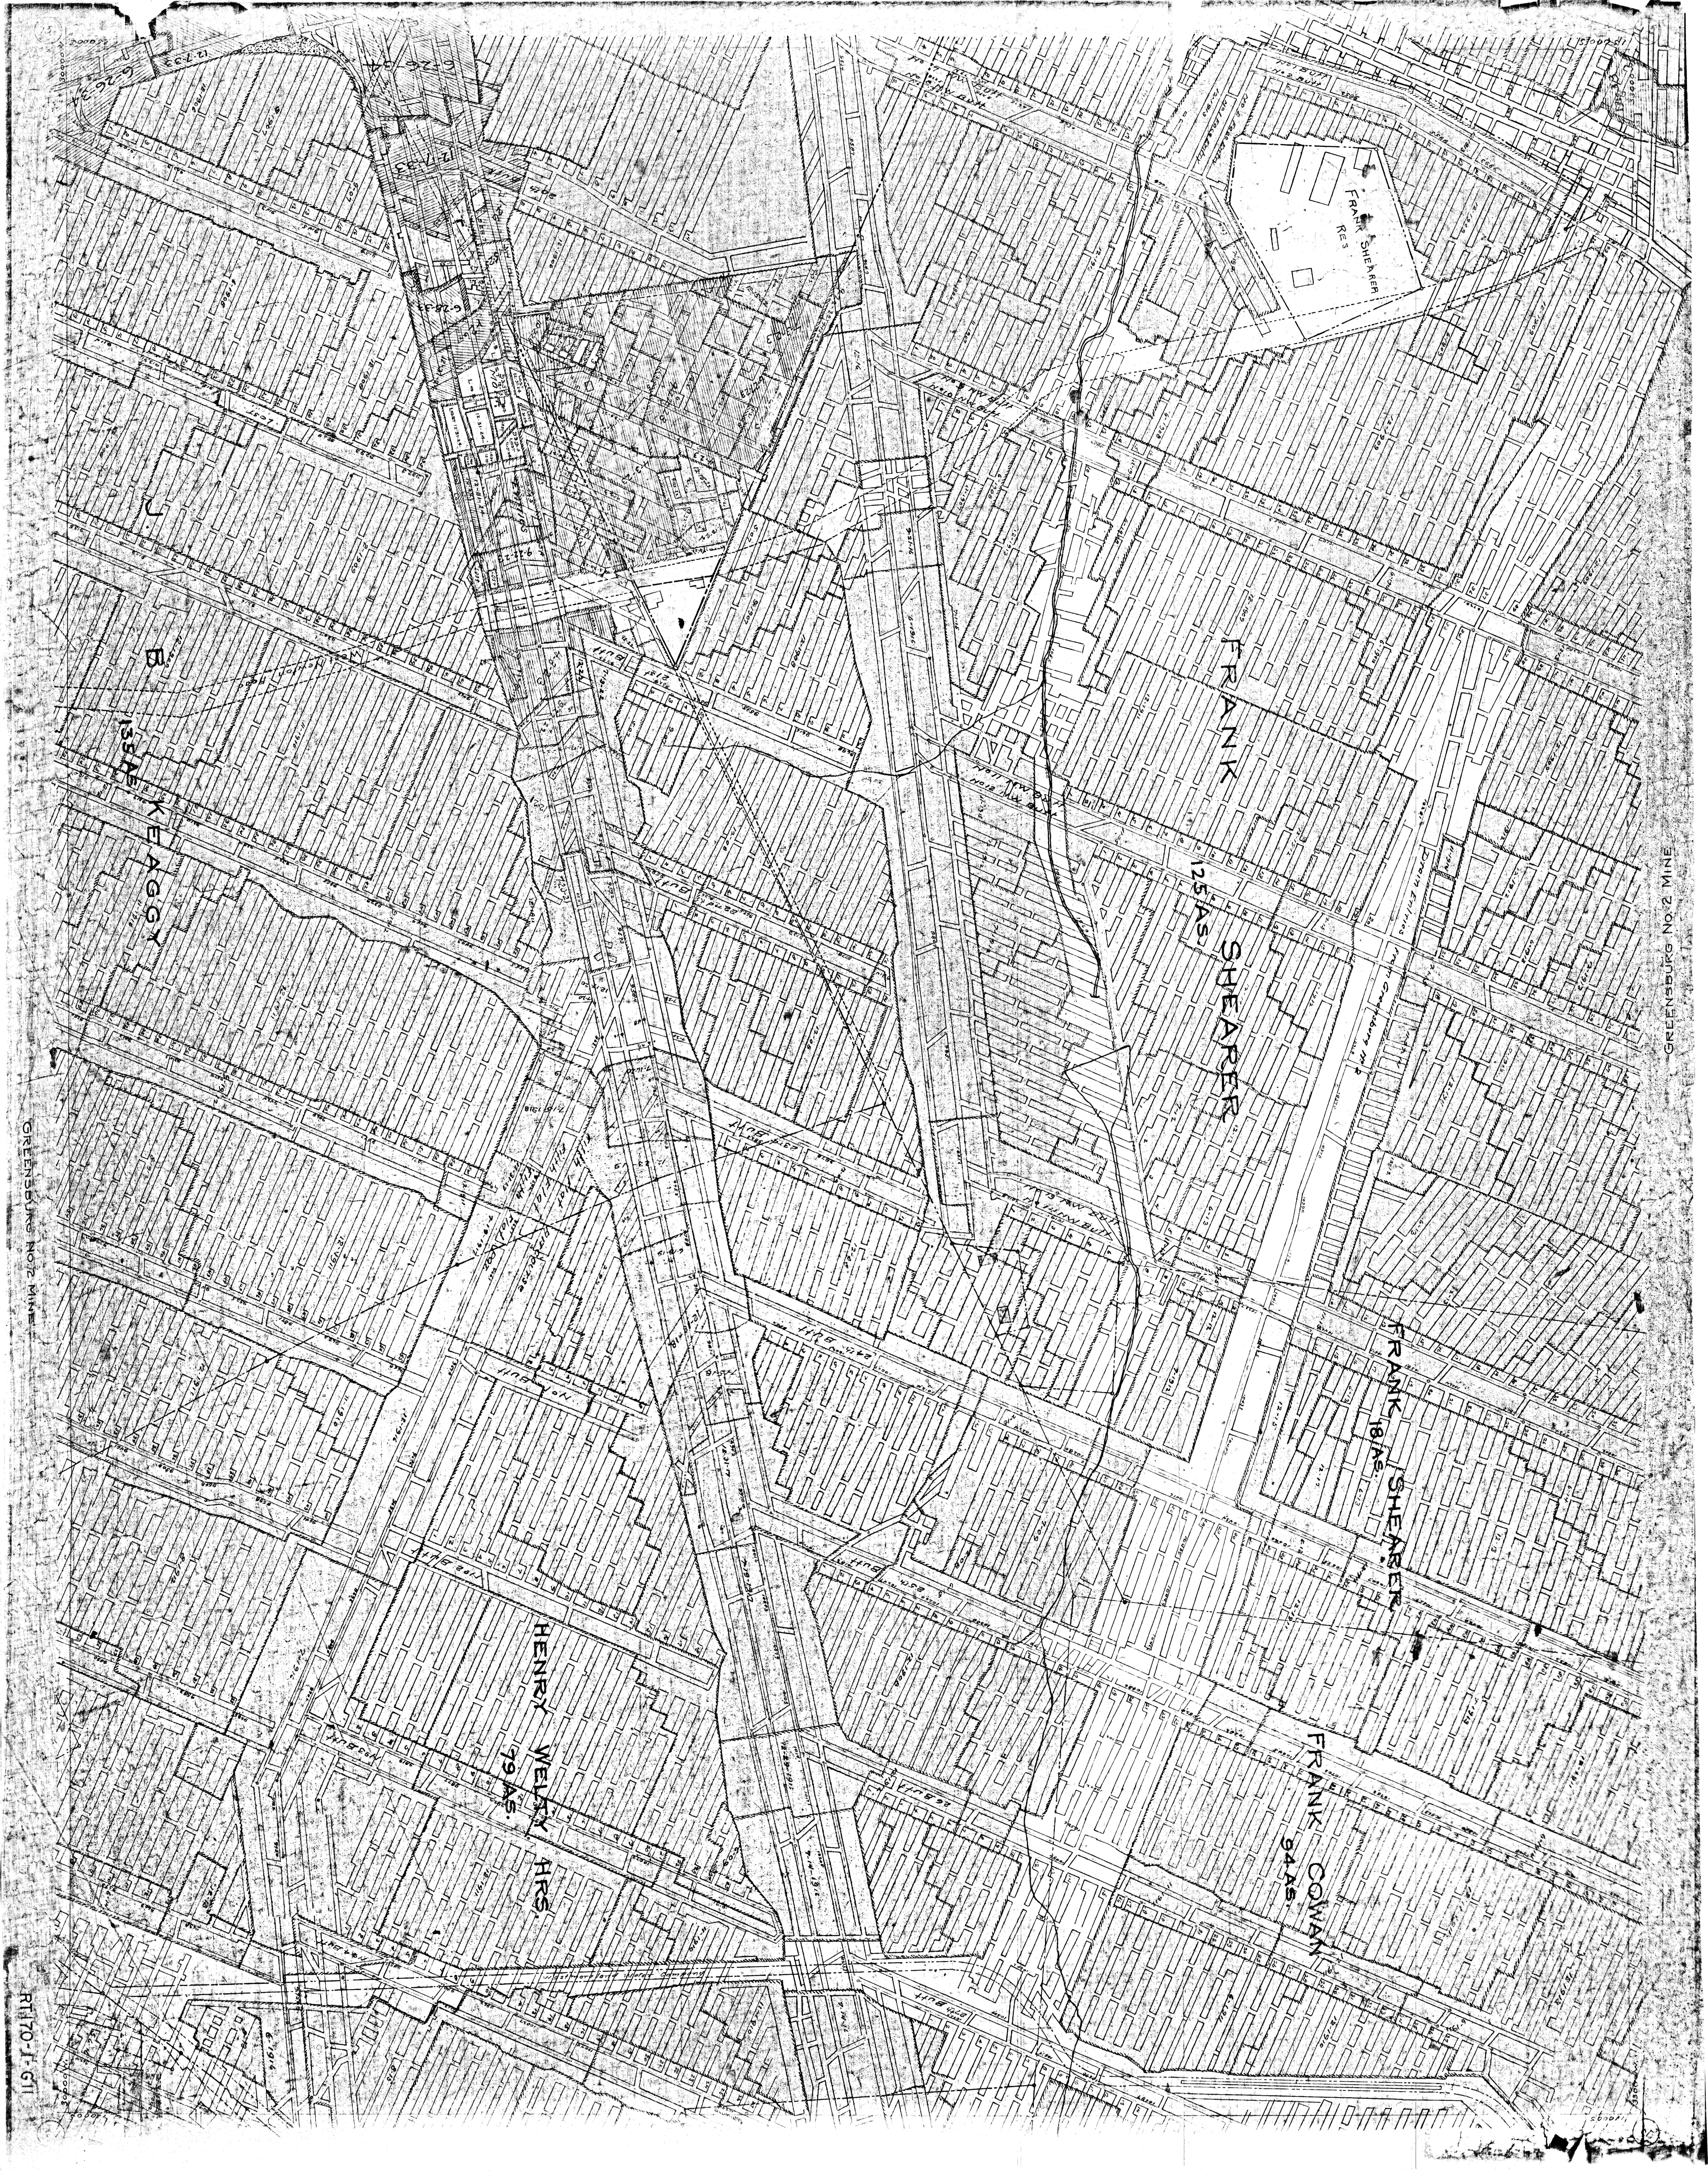

GREENSBURG NO. 2 MINE

GREENSBURG NO. 2 MINE

RT 70-1-611