
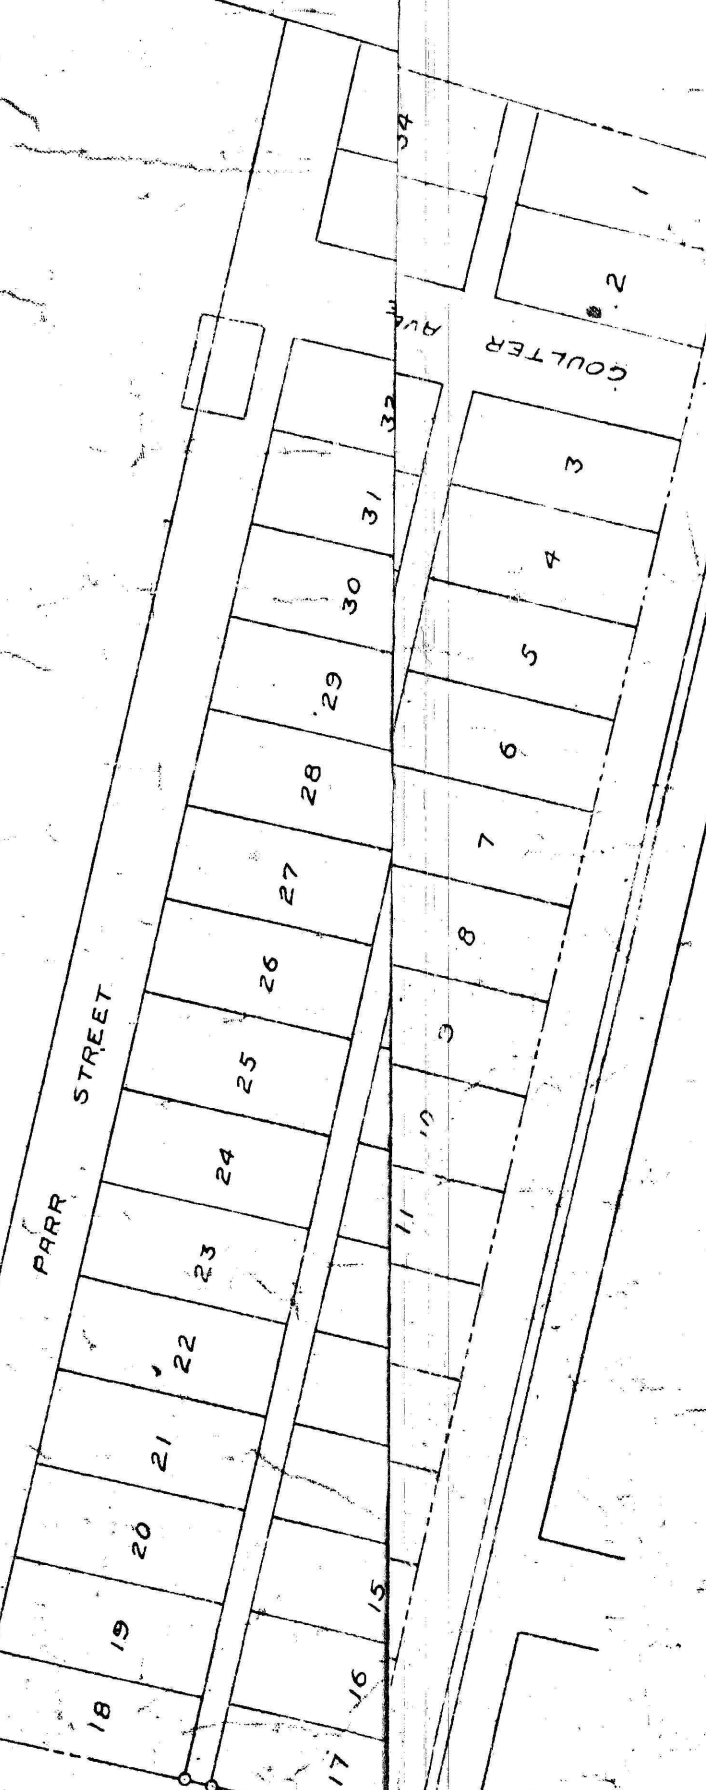


MAP OF
K.C. & C. CO'S CIG. NO. 2 MINE
SITUATE NEAR
COUNTY HOME JCT., ON HEMP. BR., S.W.P.R.R.
HEMPFIELD TWP., WESTMORELAND CO., PA.
SCALE: 1" = 100'

ENGINEER,
GREENSBURG, PA.

NOTE:
WORKINGS SHOWN AS PER SURVEY OF
VENTILATION INDICATED THIS:
DIRECTION OF CURRENT
DOOR
STOPPING
OVERCAST
REGULATOR

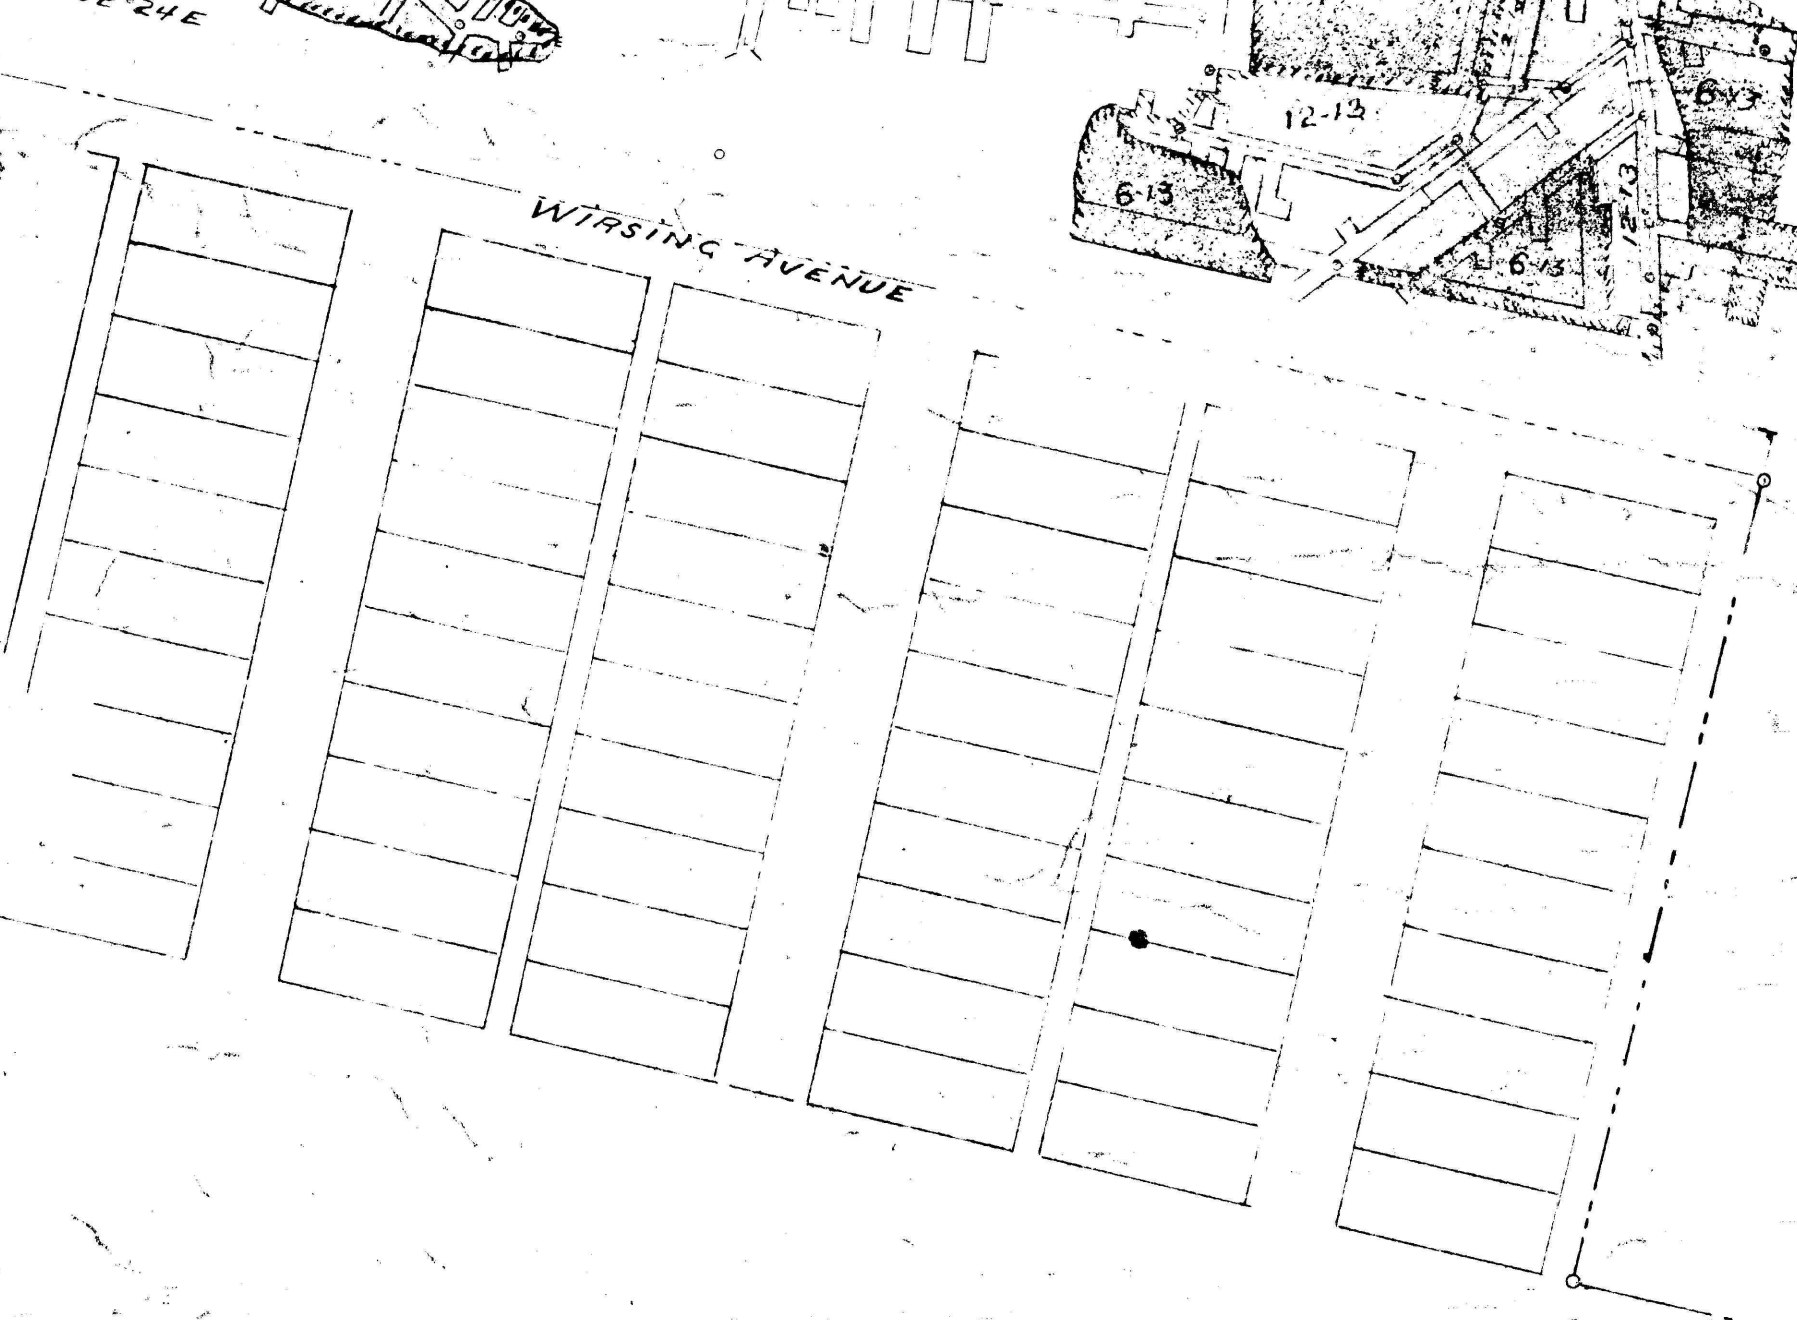

Containing 20,000