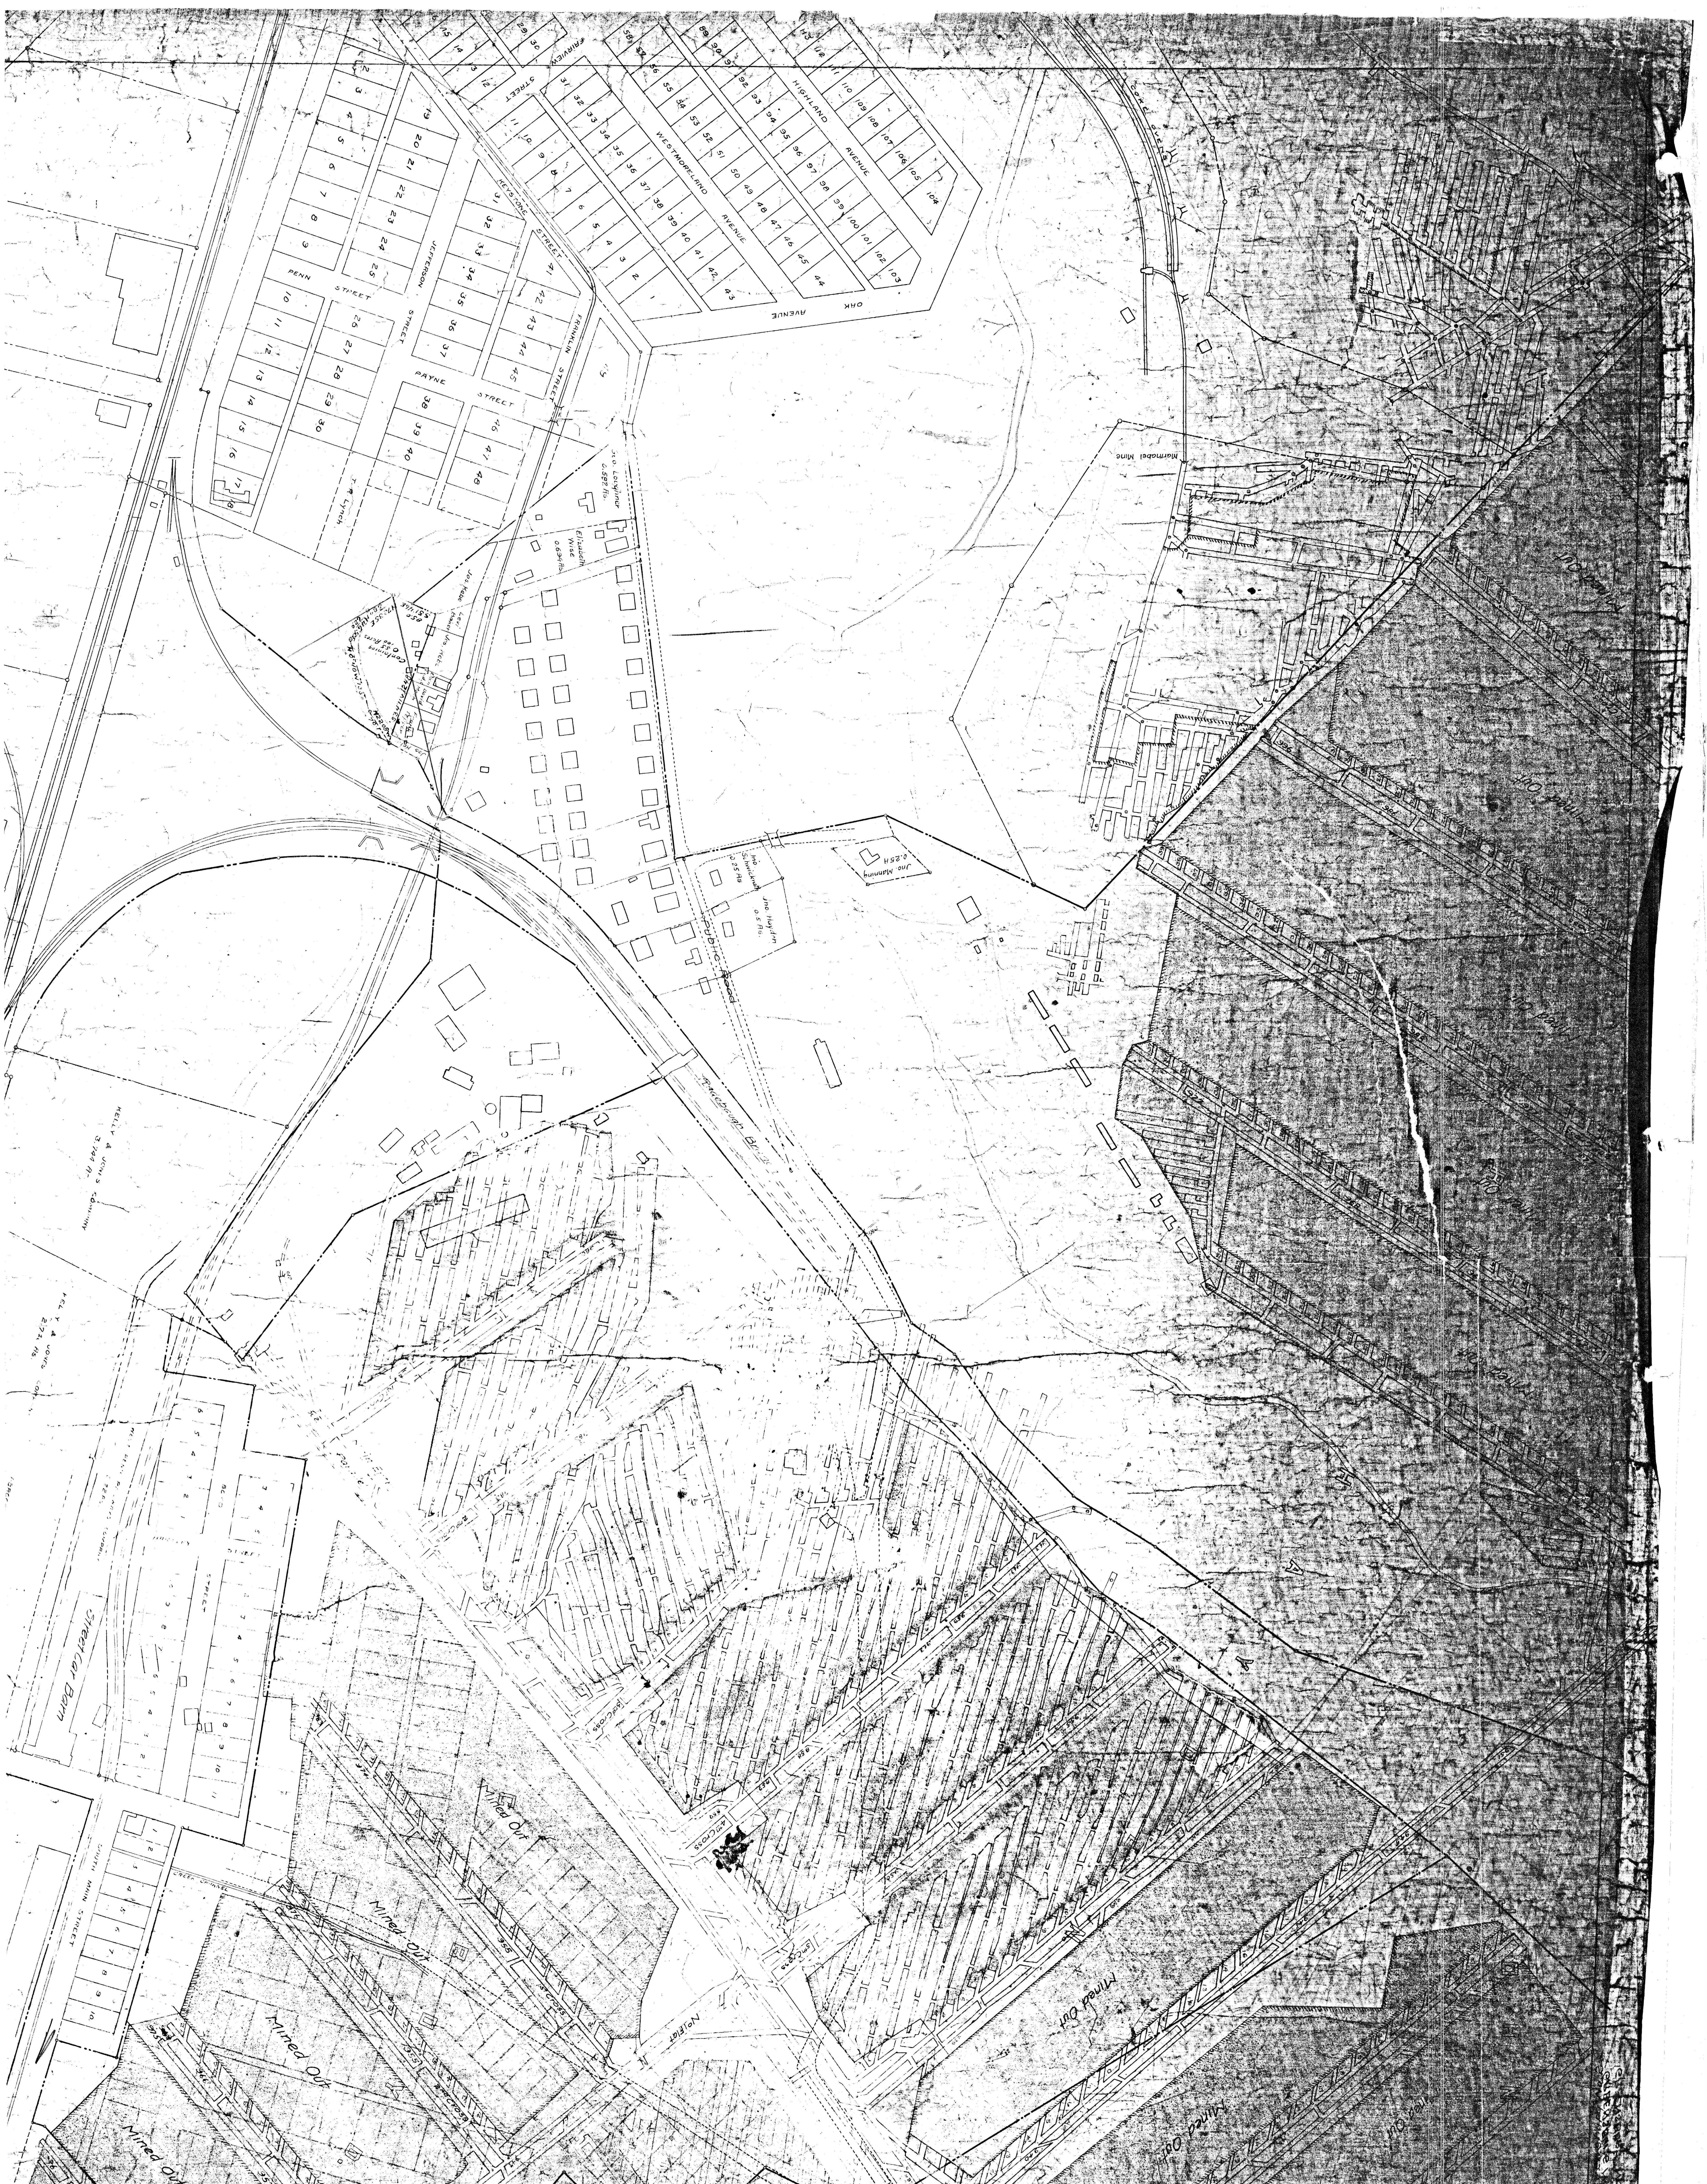
OAK AVENUE
HIGHLAND AVENUE
WESTMORELAND AVENUE
FAIRVIEW STREET
KEYSTONE STREET
FRANKLIN STREET
JEFFERSON STREET
PENN STREET
PAYNE STREET
T. R. Lynch
Geo. Loughner 0.582 As.
Elizabeth Wise 0.634 As.
Jos. Kebe
Levi Baker
Jos. Kebe
Containing 0.55 Acres
Jno. Schwickrath 0.25 As.
Jno. Hayden 0.5 As.
Jno. Manning 0.25 A
Public Road
Marmabel Mine
KELLY & JONES COMPANY 3.744 A.
KELLY & JONES CO. 2.72 As.
Street Car Barn
SOUTH MAIN STREET
CREEK CHANNEL
No. 1 Flat
Mined Out
Mined Out
Mined Out
Mined Out
Mined Out
RT171-1-G18