


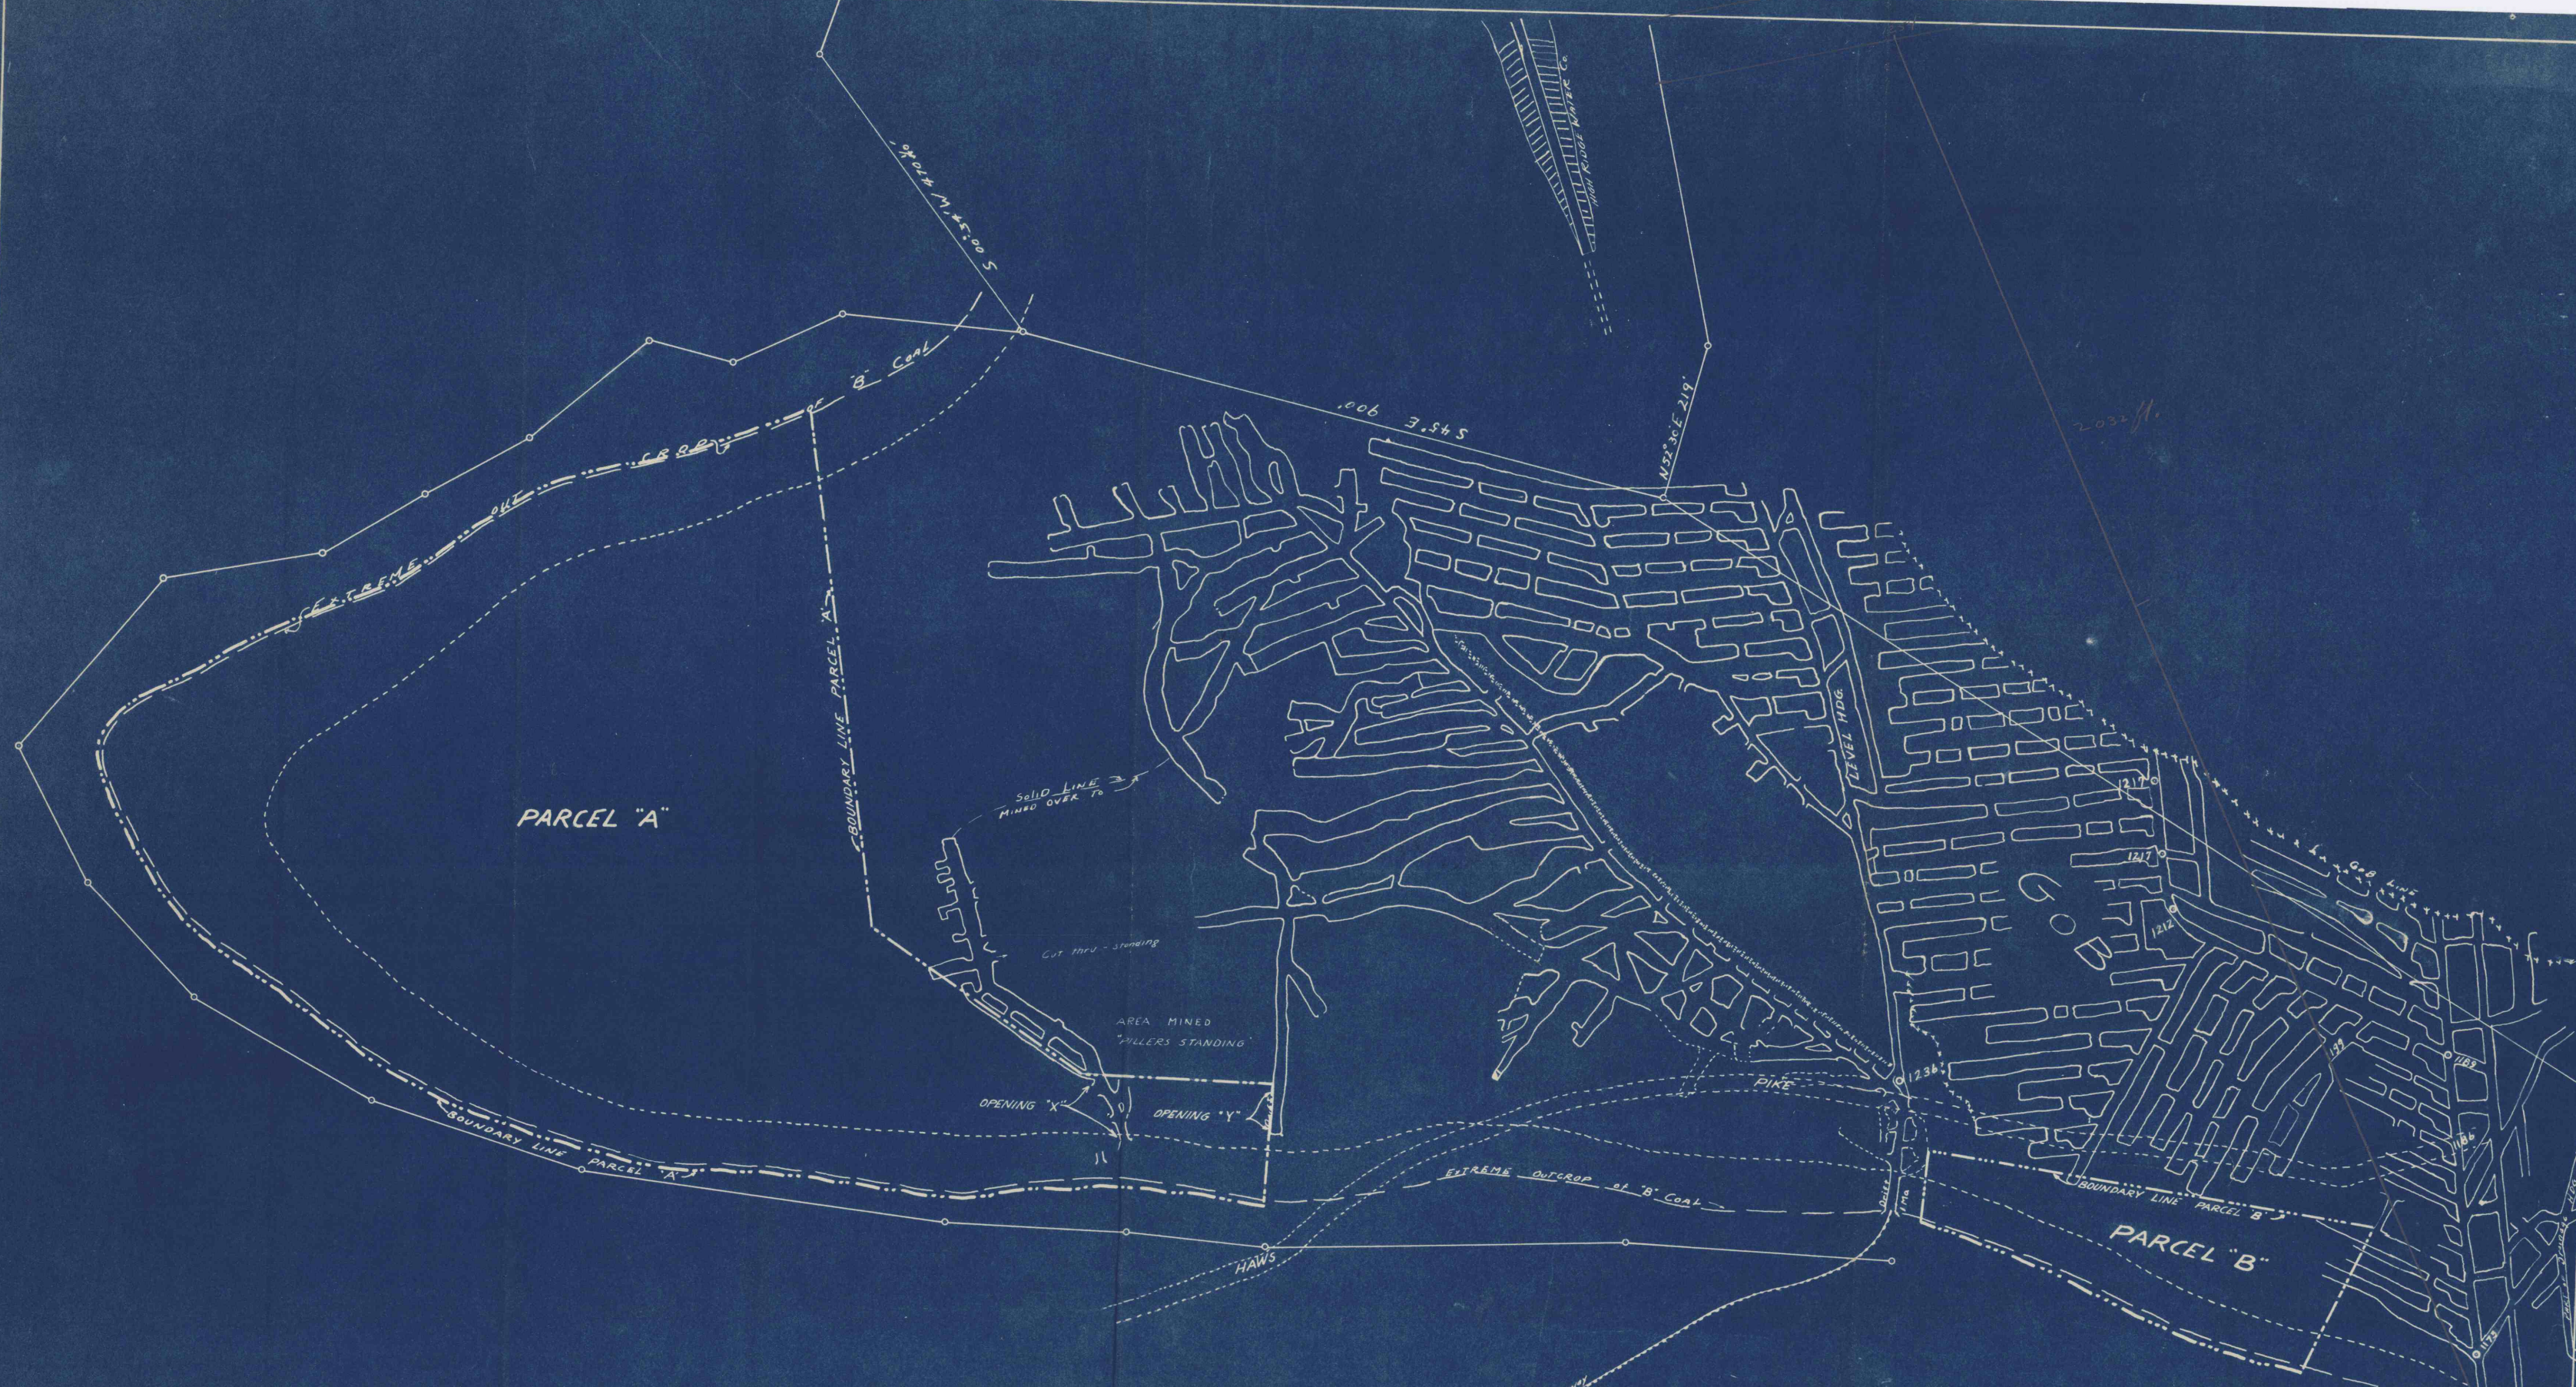

PLAN
OF
H. J. HUETHER FUEL CO. MINE
ST. CLAIR TWP. WEST MORELAND CO. PA.
SCALE: 1 inch = 100 feet