


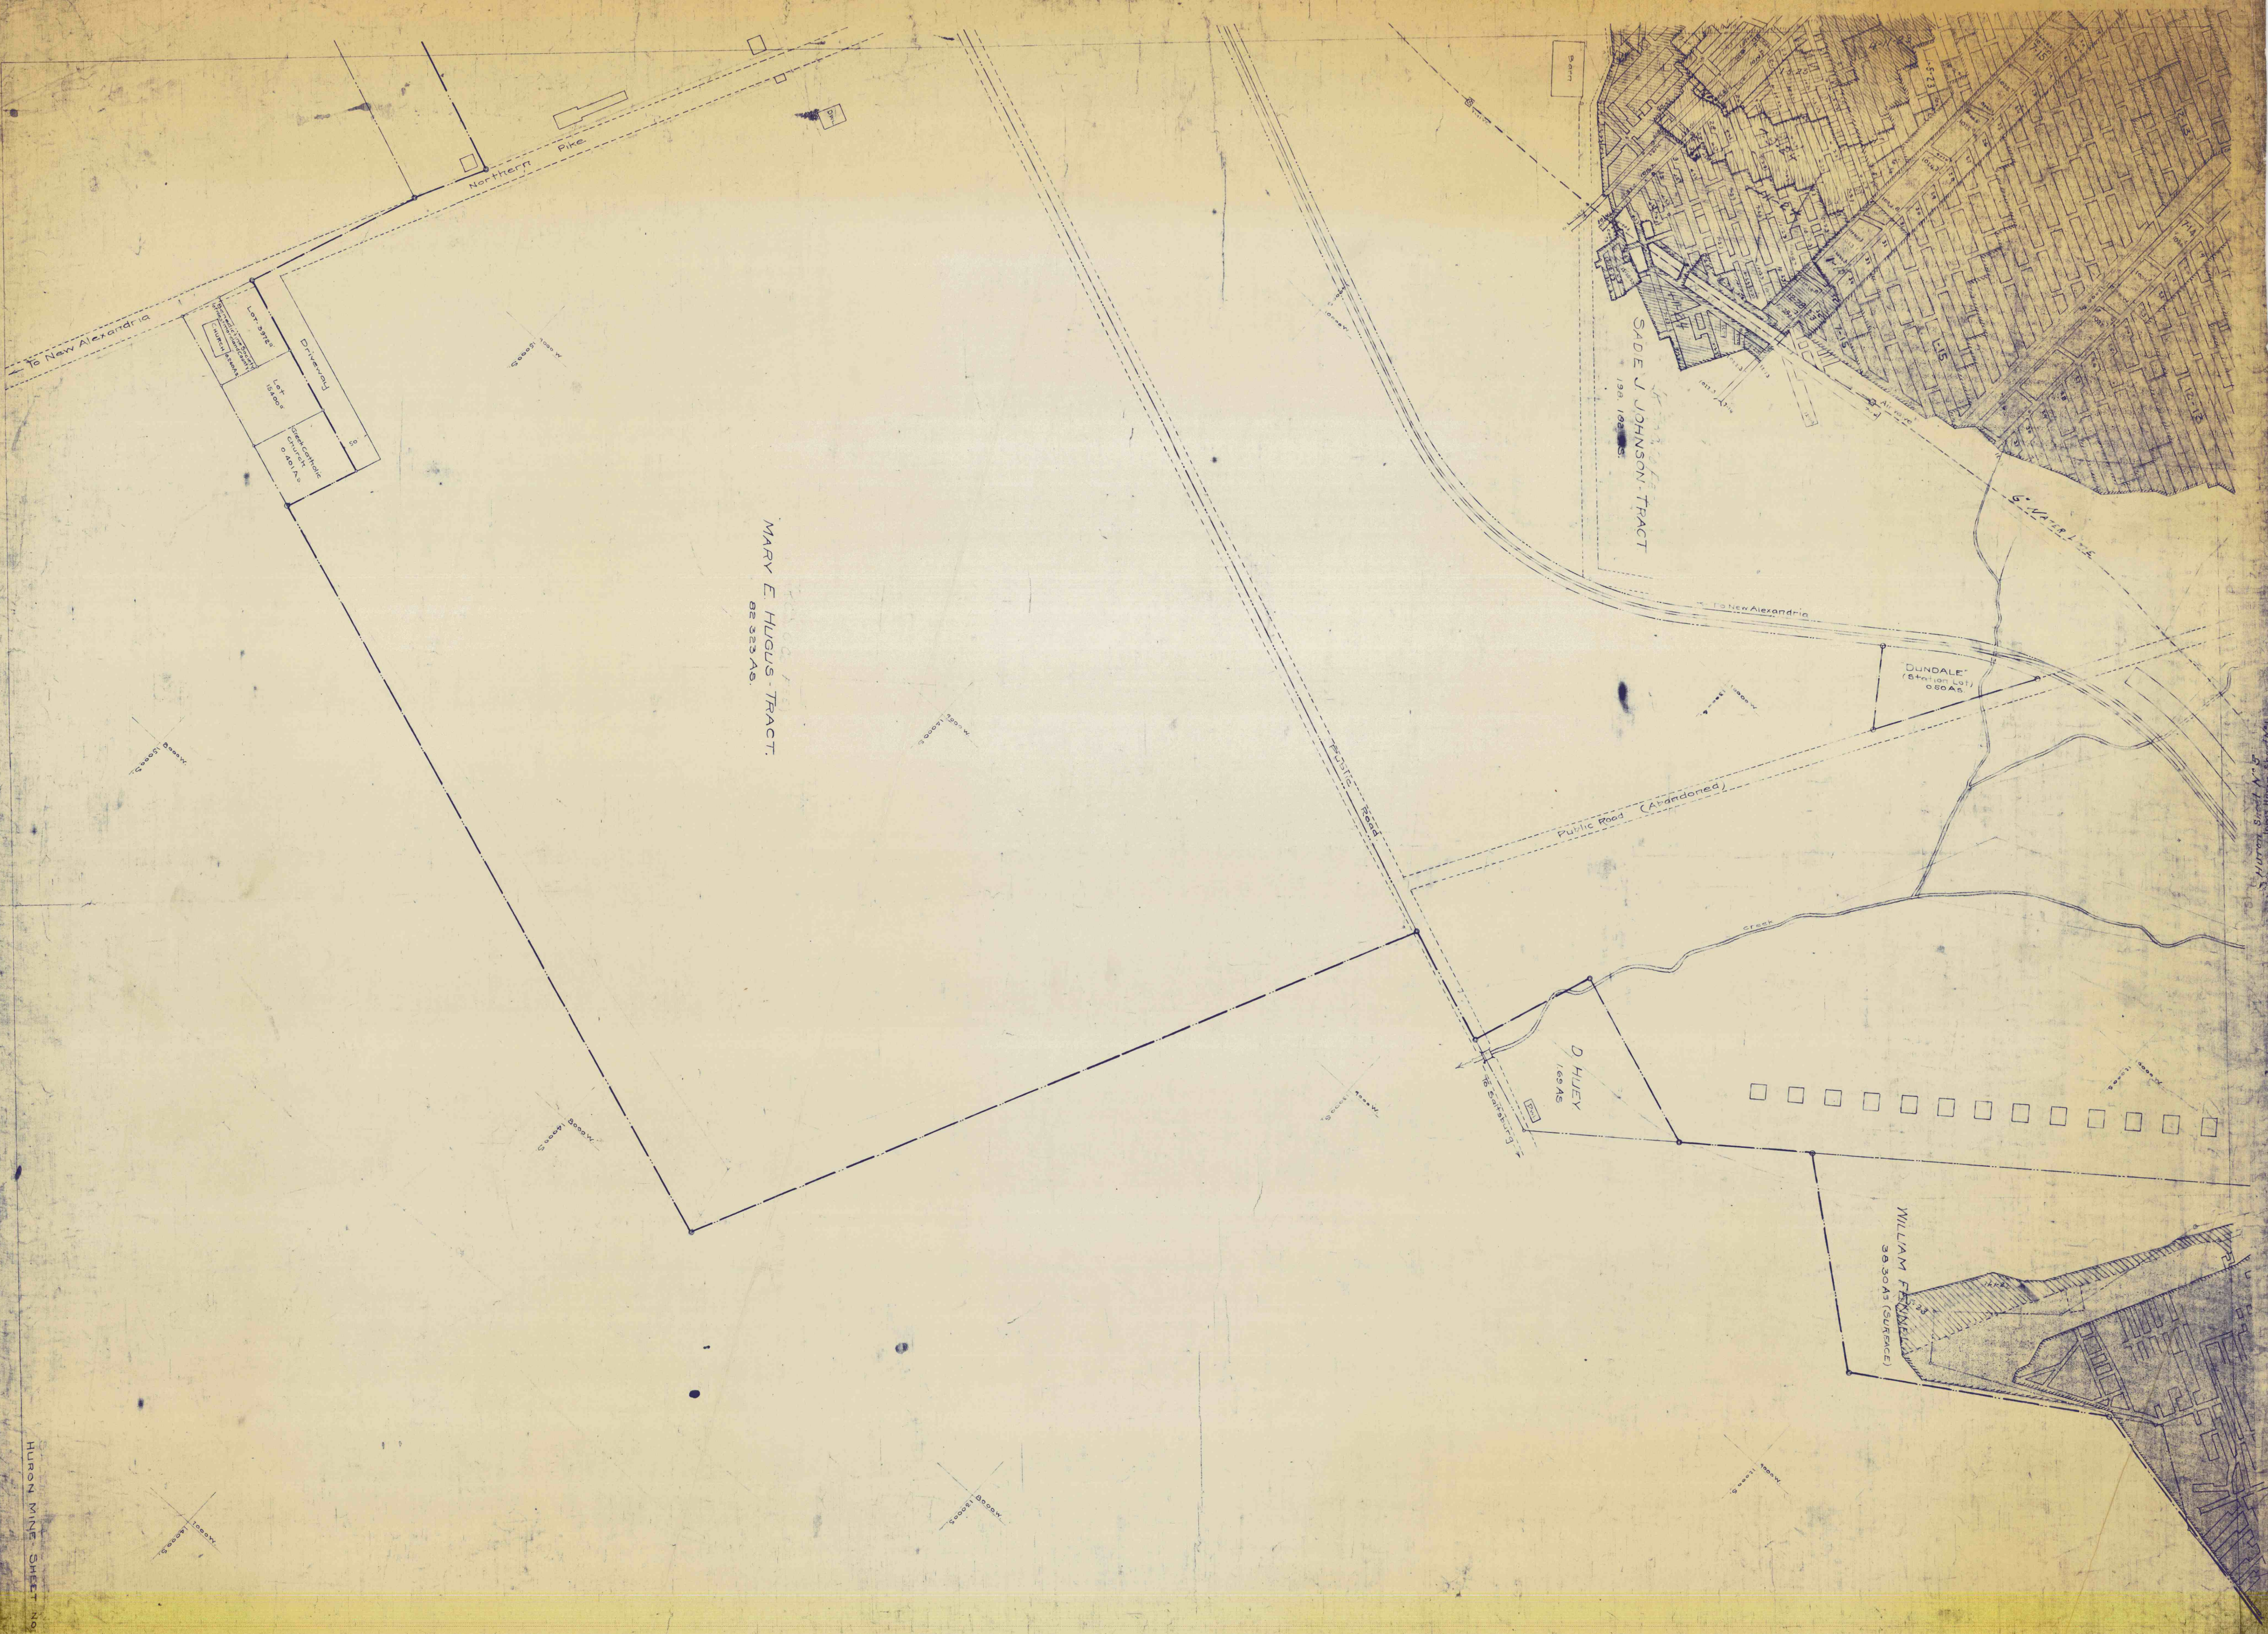

HURON MINE SHEET No. 5