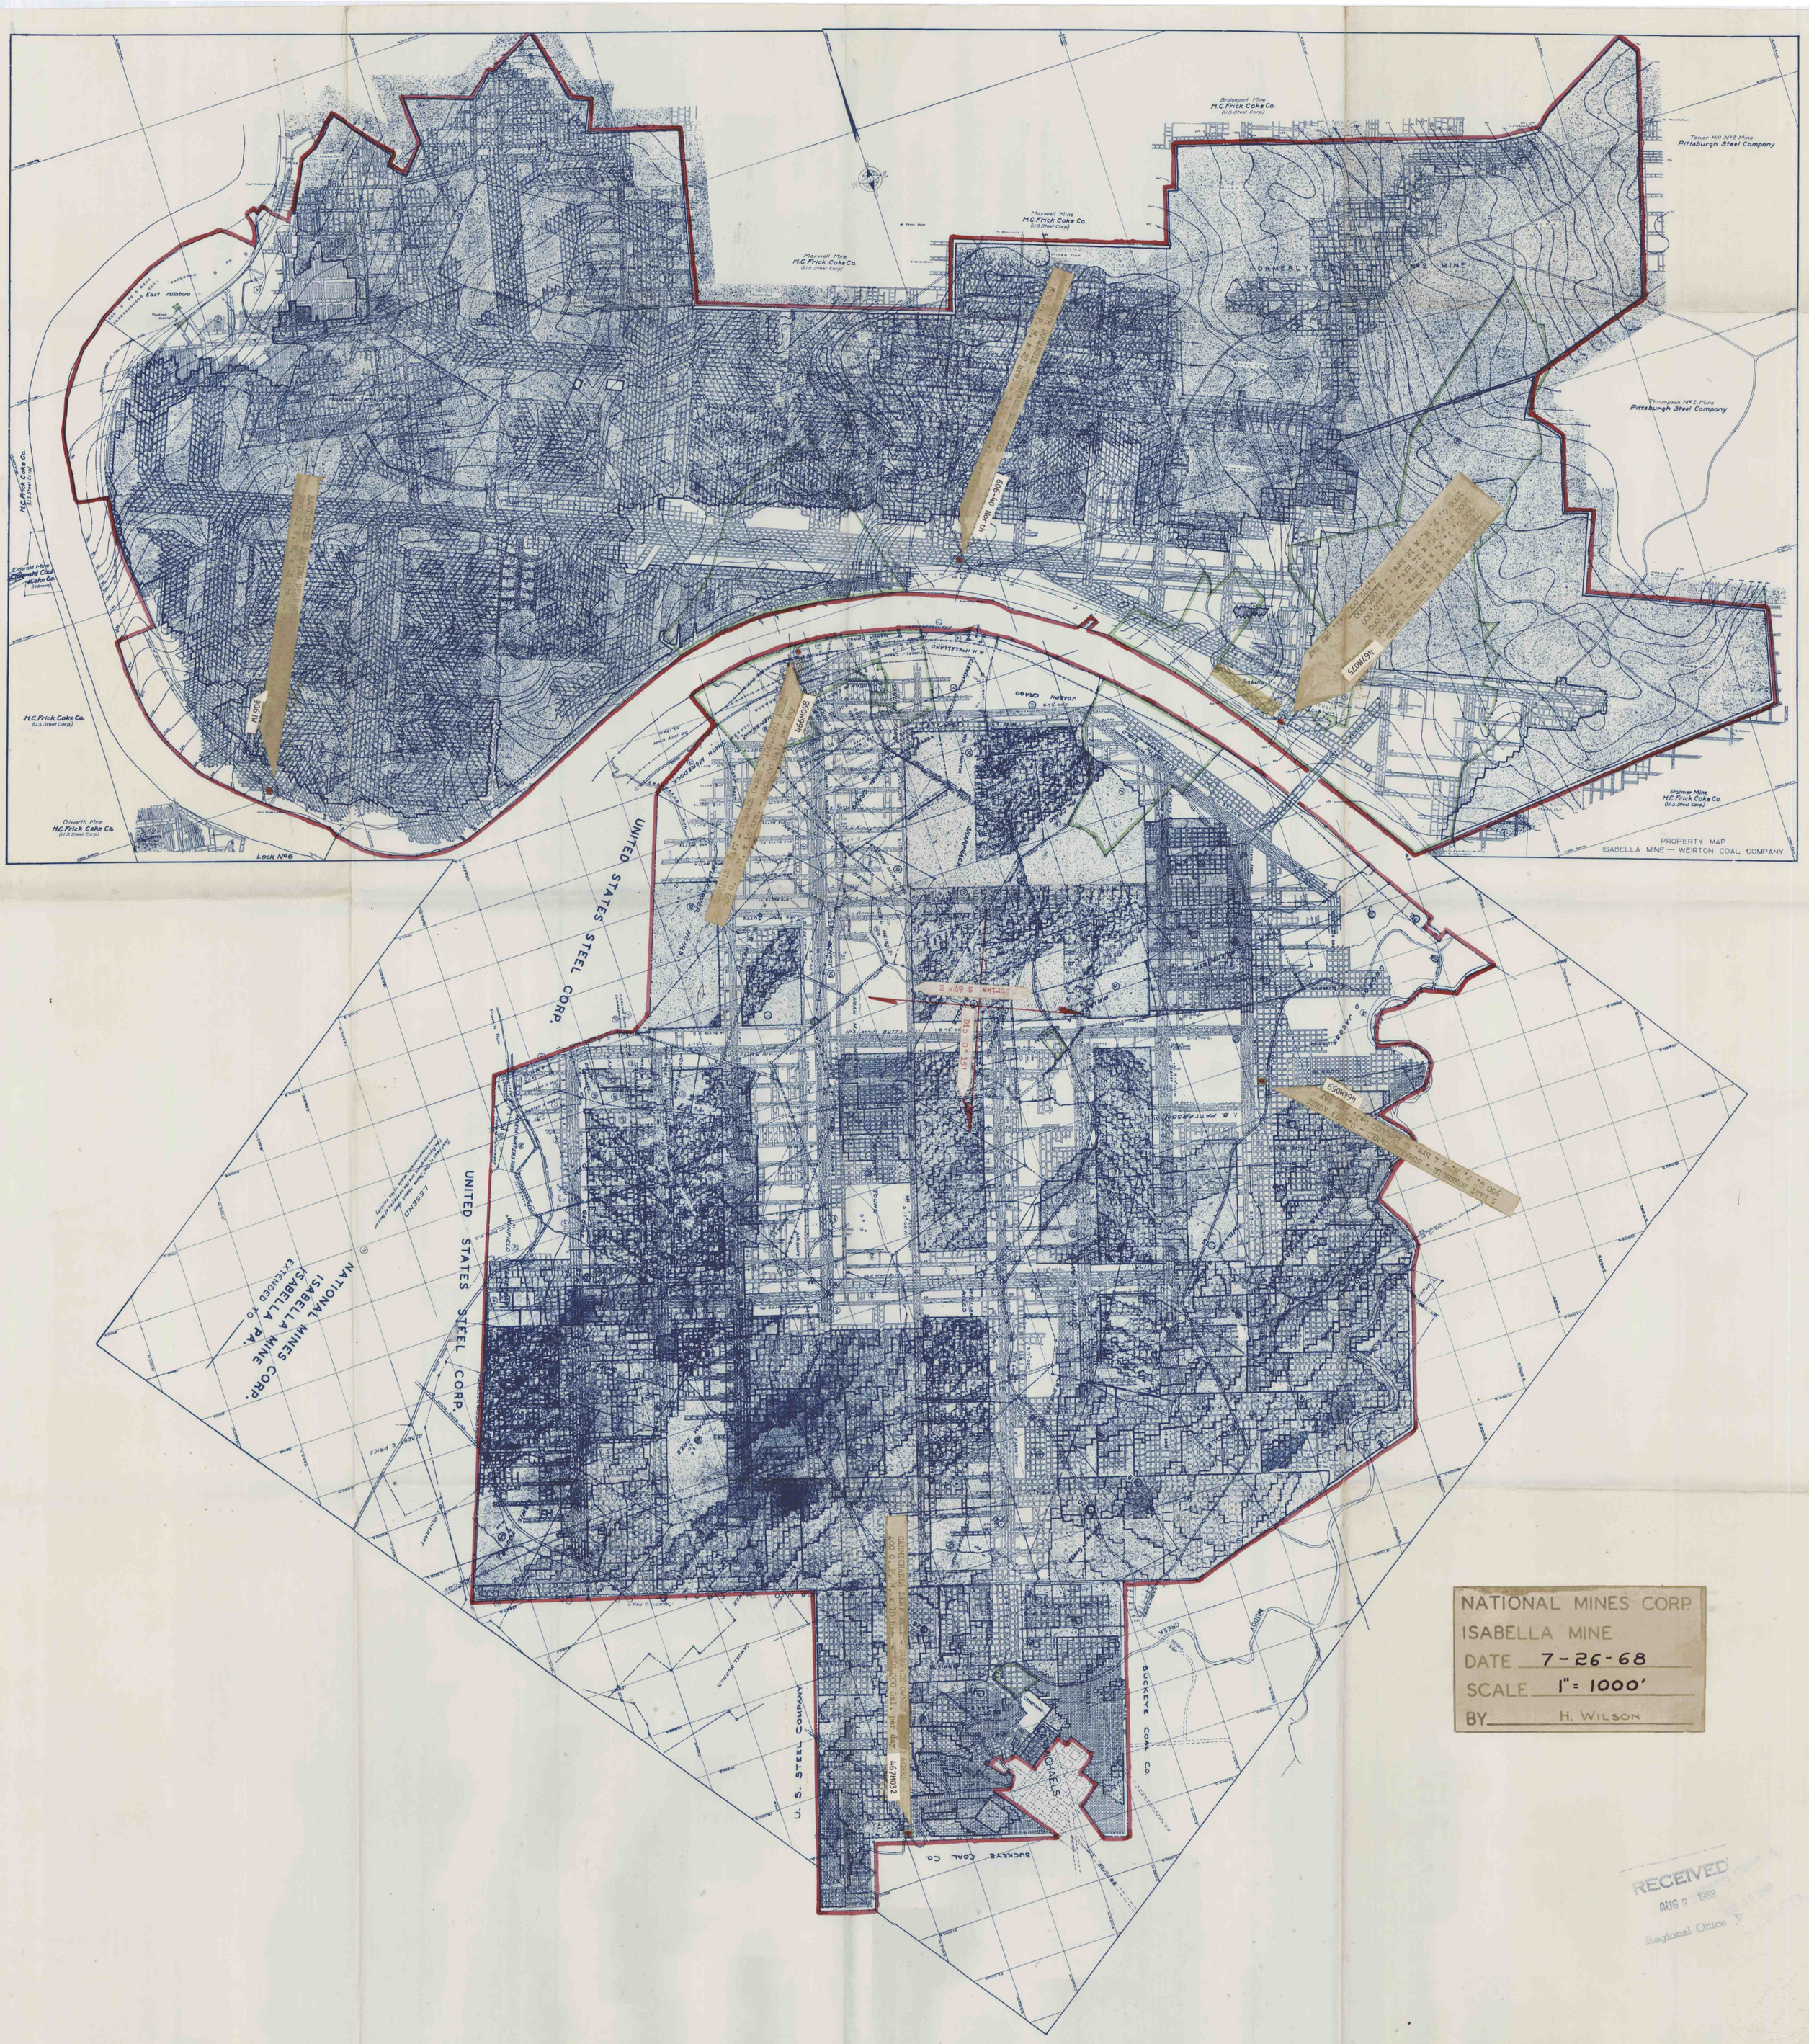
PROPERTY MAP
ISABELLA MINE — WEIRTON COAL COMPANY
Bridgeport Mine
H.C. Frick Coke Co.
(U.S. Steel Corp.)
Tower Hill No 2 Mine
Pittsburgh Steel Company
Maxwell Mine
H.C. Frick Coke Co.
(U.S. Steel Corp.)
FORMERLY
NO 2 MINE
Thompson No 2 Mine
Pittsburgh Steel Company
East Millsboro
H.C. Frick Coke Co.
(U.S. Steel Corp.)
Emerald Mine
Emerald Coal & Coke Co.
(Fishmen)
H.C. Frick Coke Co.
(U.S. Steel Corp.)
Dilworth Mine
H.C. Frick Coke Co.
(U.S. Steel Corp.)
Lock No 8
Palmer Mine
H.C. Frick Coke Co.
(U.S. Steel Corp.)
UNITED STATES STEEL CORP.
UNITED STATES STEEL CORP.
NATIONAL MINES CORP.
ISABELLA MINE
EXTENDED TO
LEGEND
U. S. STEEL COMPANY
BUCKEYE COAL CO.
BUCKEYE COAL CO.
MICHAELS
Strike S 67° E
Pitch 0° to 15°
Isabella
JOHN CRAIG
NATIONAL MINES CORP.
ISABELLA MINE
DATE 7-26-68
SCALE 1" = 1000'
BY H. WILSON
RECEIVED
AUG 9 1968
Regional Office