



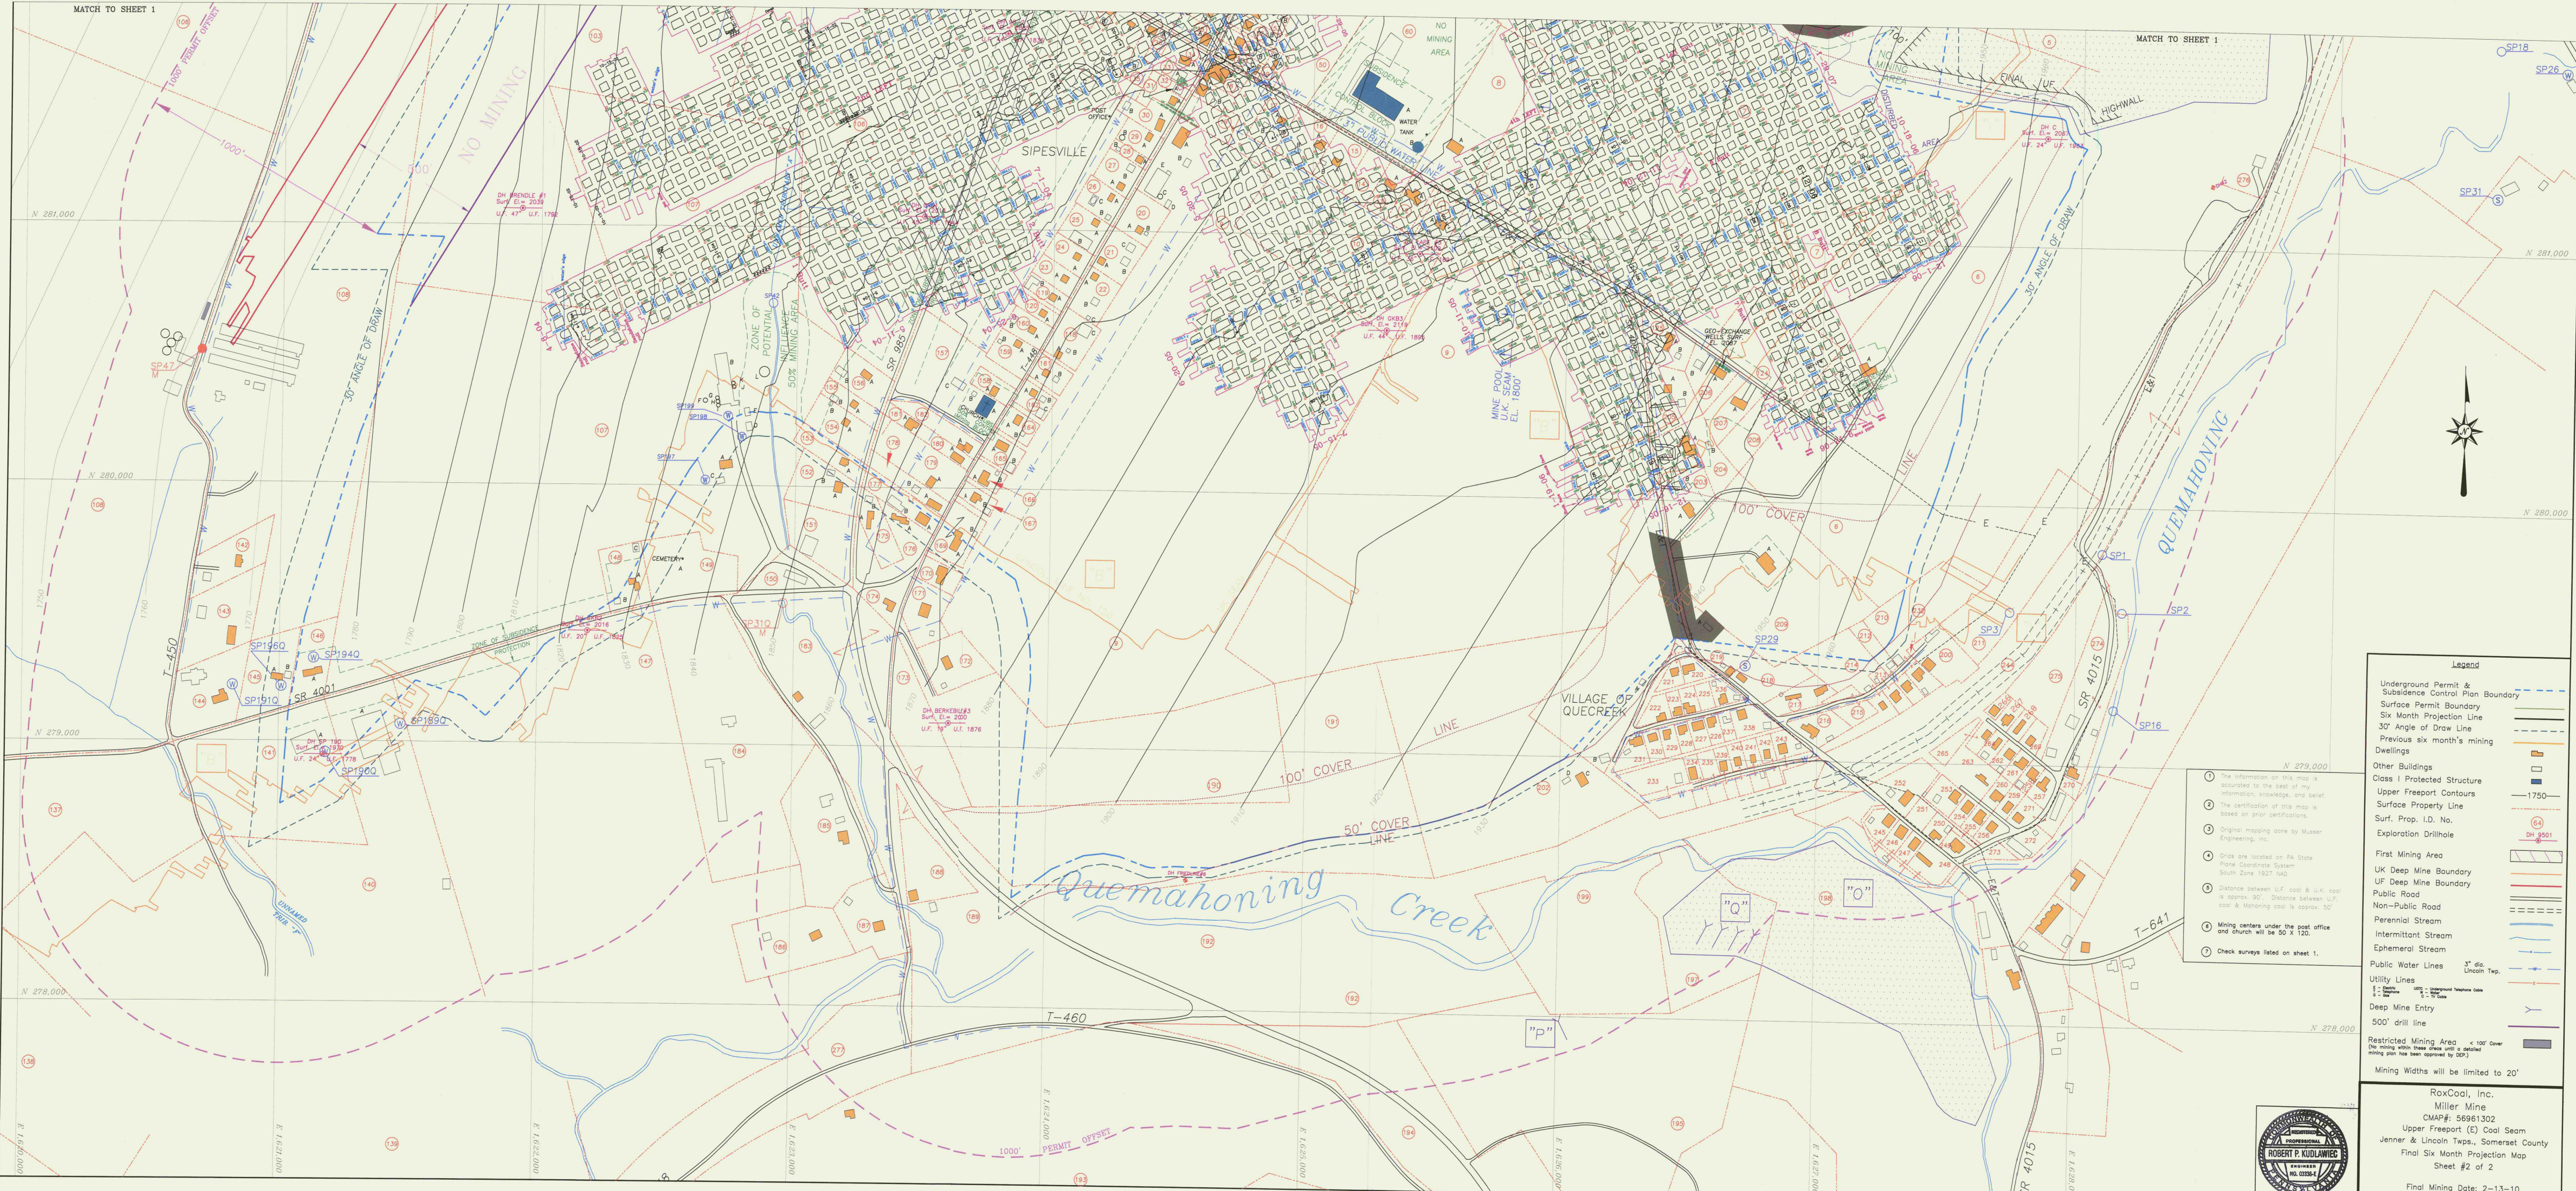

- 1 The information on this map is accurate to the best of my information, knowledge, and belief.
2 The certification of this map is based on prior certifications.
3 Original mapping done by Musser Engineering, Inc.
4 Grids are located on PA State Plane Coordinate System South Zone 1927 NAD.
5 Distance between U.F. coal & U.K. coal is approx. 90'. Distance between U.F. coal & Mahoning coal is approx. 50'.
6 Mining centers under the post office and church will be 50' X 120'.
7 Check surveys listed on sheet 1.

Legend

- Underground Permit & Subsidence Control Plan Boundary
- Surface Permit Boundary
- Six Month Projection Line
- 30° Angle of Draw Line
- Previous six month's mining Dwellings
- Other Buildings
- Class I Protected Structure
- Upper Freeport Contours
- Surface Property Line
- Surf. Prop. I.D. No.
- Exploration Drillhole
- First Mining Area
- UK Deep Mine Boundary
- UF Deep Mine Boundary
- Public Road
- Non-Public Road
- Perennial Stream
- Intermittent Stream
- Ephemeral Stream
- Public Water Lines
- Utility Lines
- Deep Mine Entry
- 500' drill line
- Restricted Mining Area
- Mining Widths will be limited to 20'

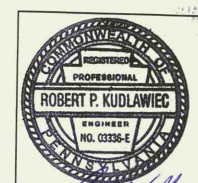

RoxCoal, Inc.
Miller Mine
CMAP#: 56961302
Upper Freeport (E) Coal Seam
Jenner & Lincoln Twp., Somerset County
Final Six Month Projection Map
Sheet #2 of 2
Final Mining Date: 2-13-10
Survey Date: 2-15-10
Scale: 1" = 200'

RECEIVED
AUG 17 2010