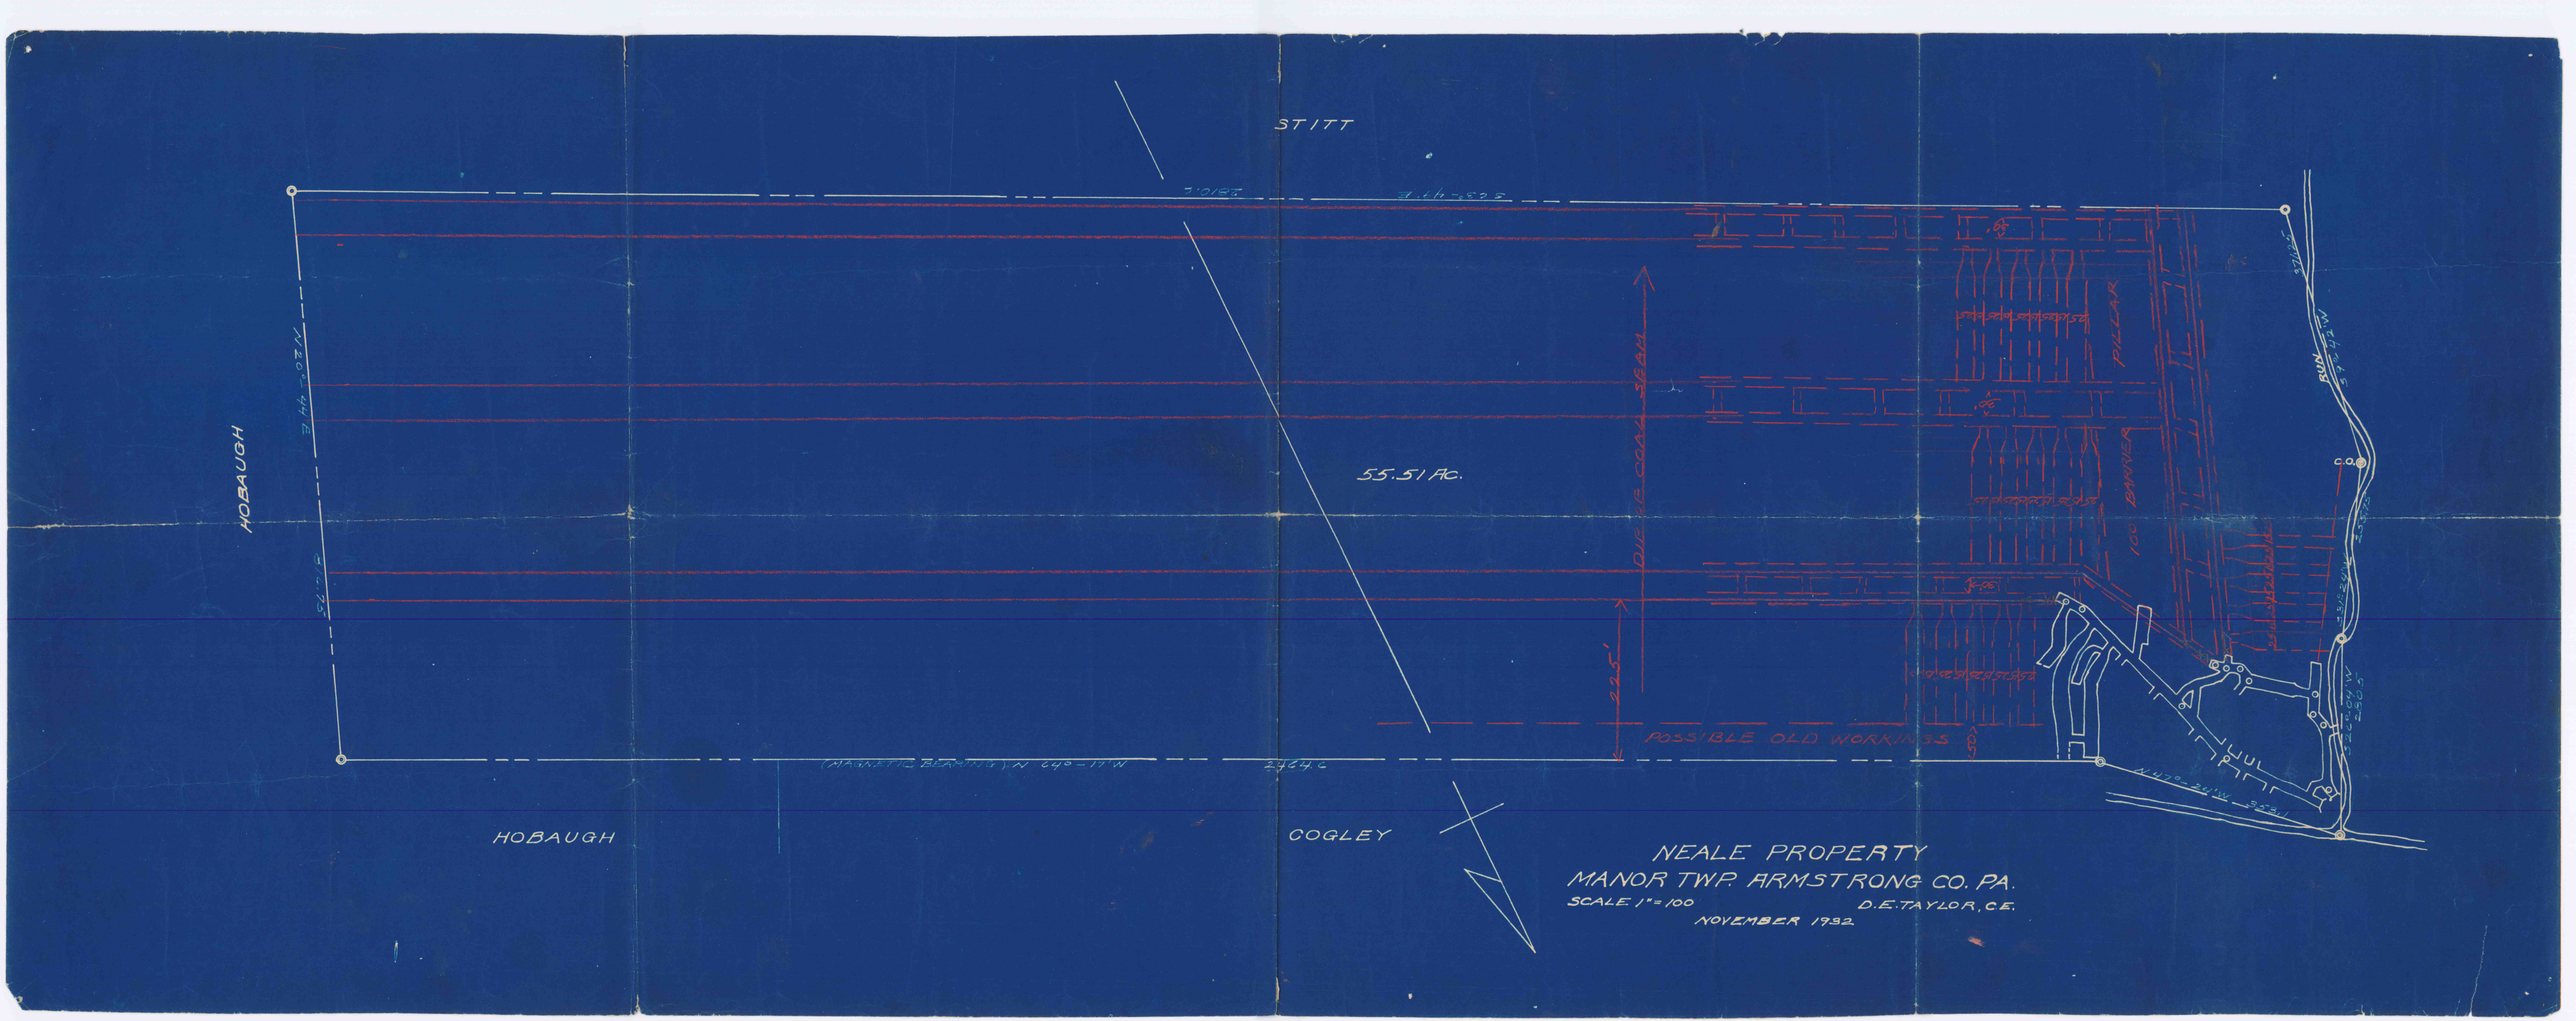
STITT
HOBAUGH
55.51 Ac.
DIVIDE COAL SEAM
PILLAR
10' BARRIER
POSSIBLE OLD WORKINGS
ROAD
HOBAUGH
COGLEY
NEALE PROPERTY
MANOR TWP. ARMSTRONG CO. PA.
SCALE 1" = 100
D.E. TAYLOR, C.E.
NOVEMBER 1932