


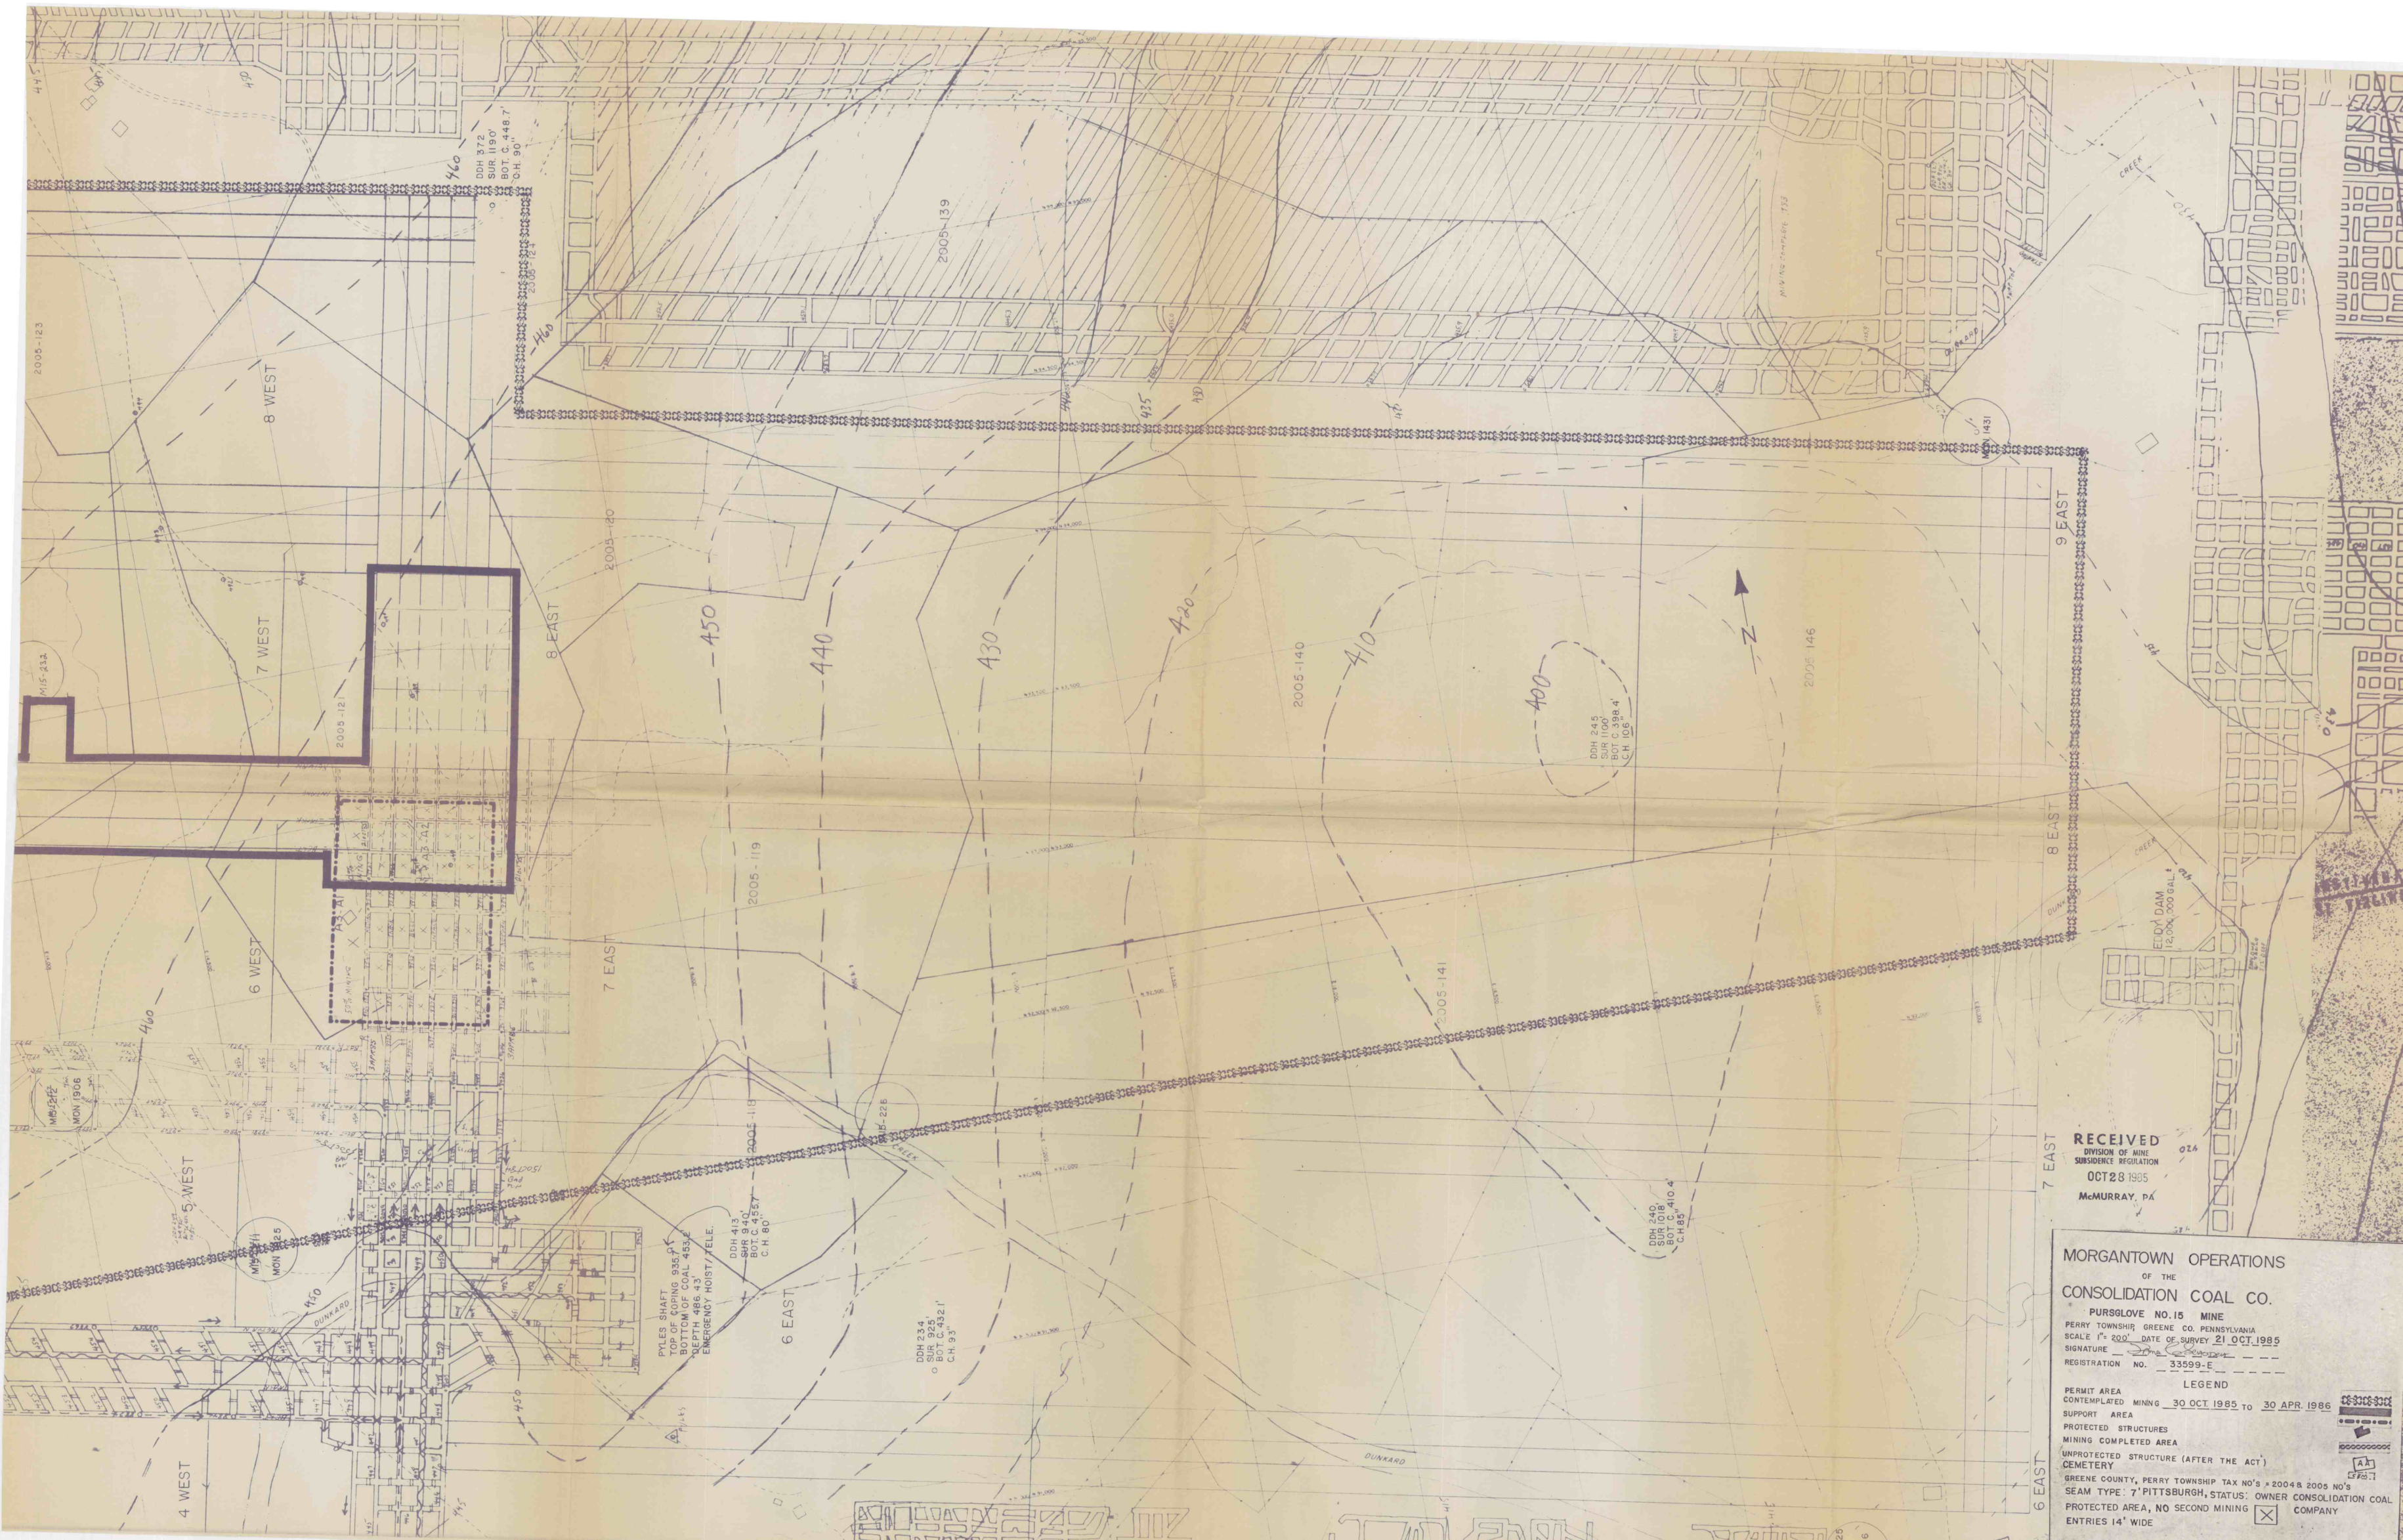

RECEIVED
DIVISION OF MINE
SUBSIDENCE REGULATION
OCT 28 1985
McMURRAY, PA

MORGANTOWN OPERATIONS
OF THE
CONSOLIDATION COAL CO.
PURSGLOVE NO. 15 MINE
PERRY TOWNSHIP, GREENE CO. PENNSYLVANIA
SCALE 1" = 200' DATE OF SURVEY 21 OCT 1985
SIGNATURE _____
REGISTRATION NO. 33599-E

LEGEND
PERMIT AREA
CONTEMPLATED MINING 30 OCT 1985 TO 30 APR 1986
SUPPORT AREA
PROTECTED STRUCTURES
MINING COMPLETED AREA
UNPROTECTED STRUCTURE (AFTER THE ACT)
CEMETERY

GREENE COUNTY, PERRY TOWNSHIP TAX NO'S = 2004 & 2005 NO'S
SEAM TYPE: 7' PITTSBURGH, STATUS: OWNER CONSOLIDATION COAL
PROTECTED AREA, NO SECOND MINING ☒ COMPANY
ENTRIES 14' WIDE