


MATCH TO SHEET 2

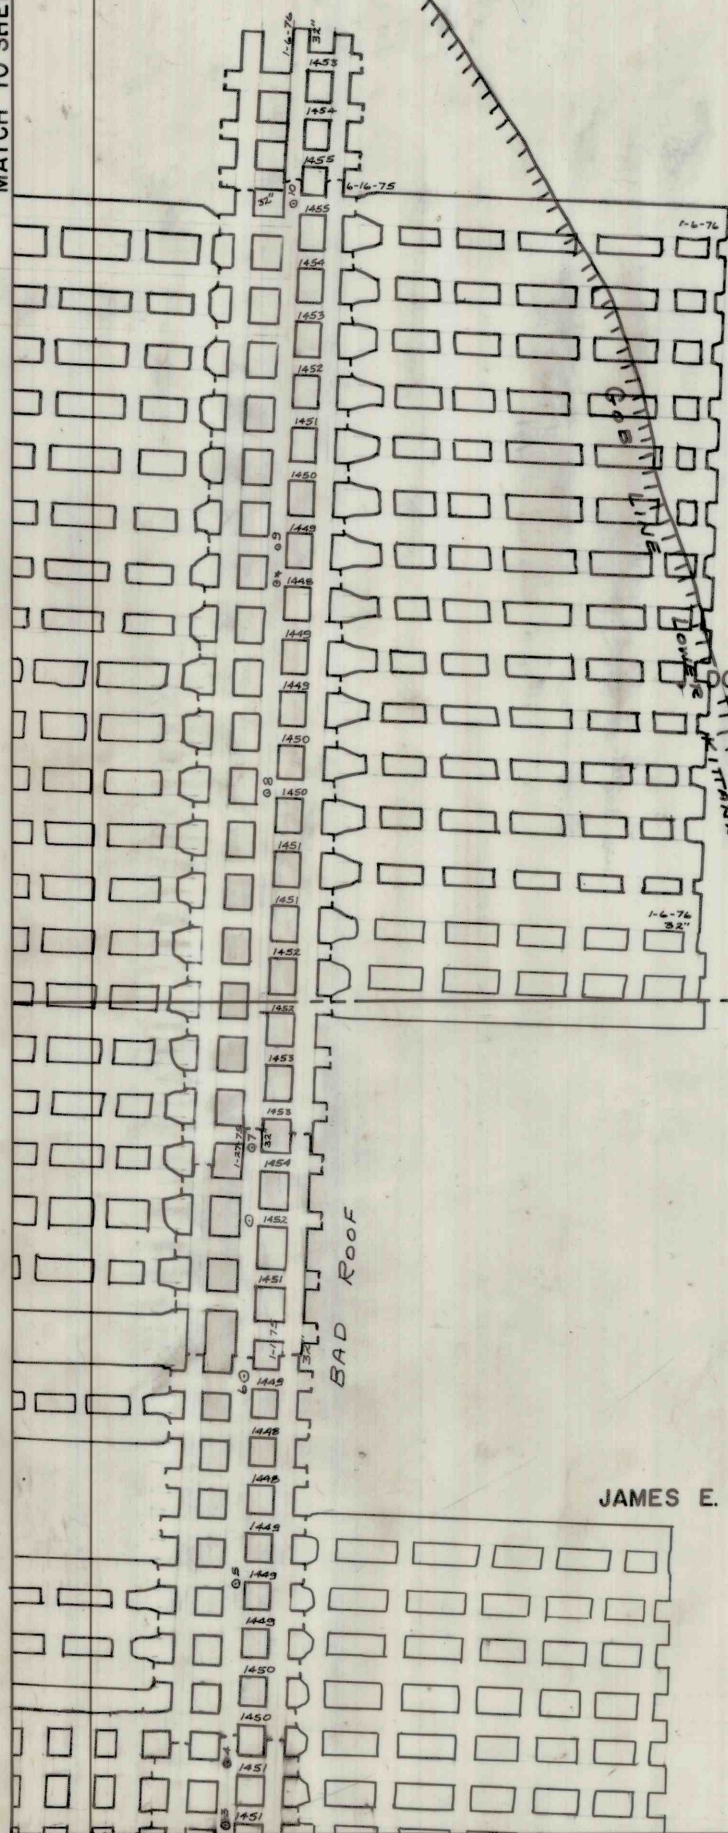

DOVERSPIKE BROS. INC.

JAMES E. MARTZ

R.R. YOUNG

R.R. YOUNG

RINGGOLD MINE
DOVERSPIKE BROS. COAL CO.
1"=100'
MINING COMPLETED AS SHOWN 11-30-76



SHEET 4

MATCH TO SHEET 3