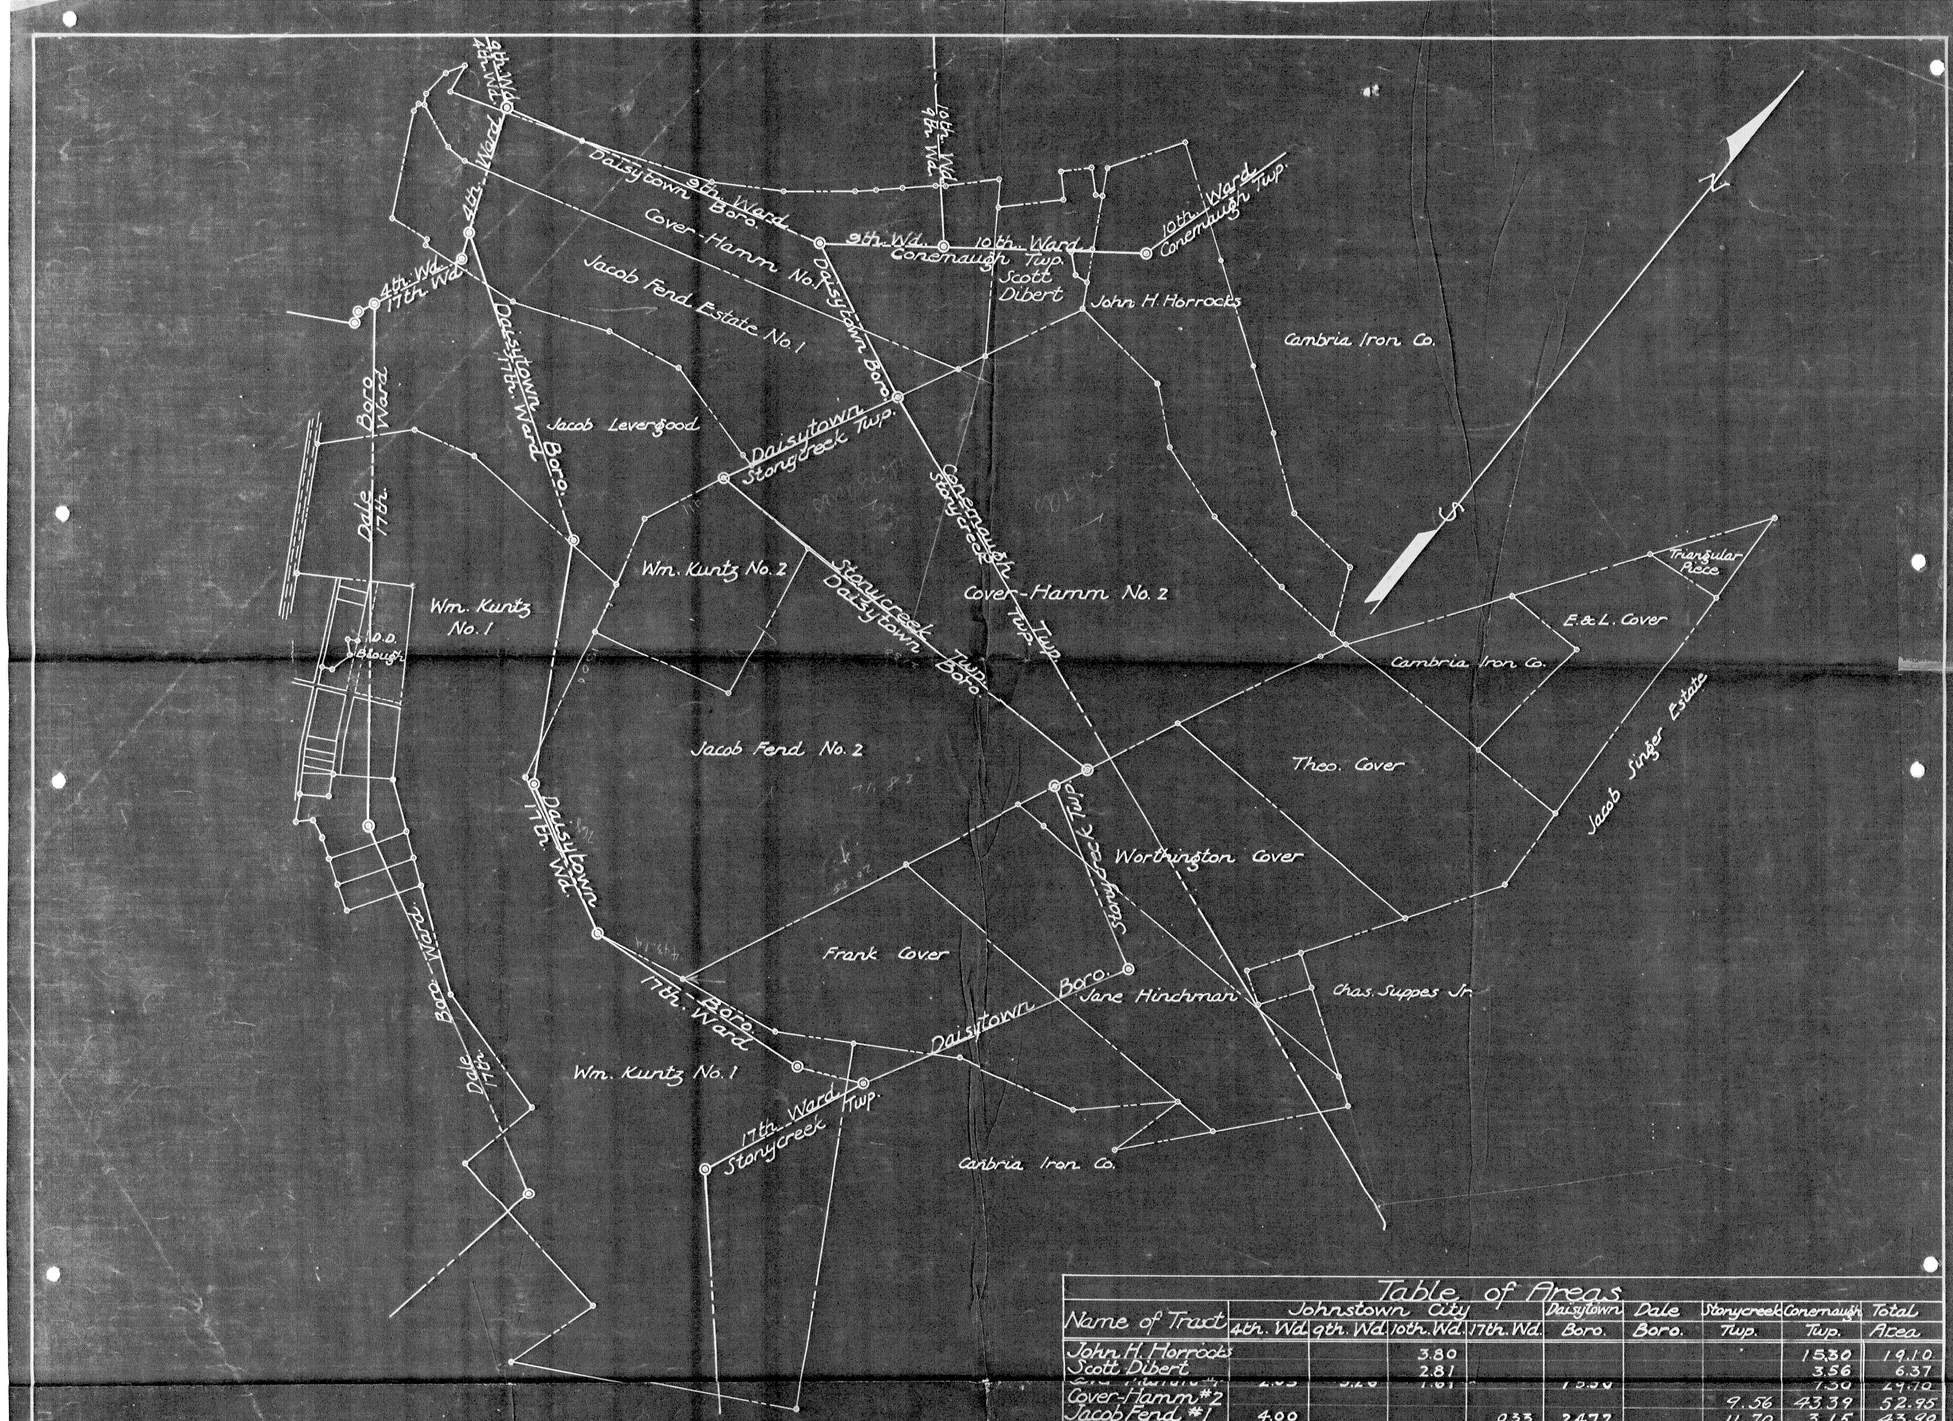


Citizens Coal Company

showing

"B" or Miller Seam Property

Situate in

City of Johnstown, Daisytown and Dale Boroughs, Conemaugh and Stonycreek Townships, Cambria County Penna.

Scale 1" = 400' S.E. Dickey and Co. Apr. 19, 1916.

Civil and Mining Engineers
Johnstown, Penna.

DEEP MINE SAFETY 400
0 200 400 800 Feet

#541
6-25-99
CG

Table of Areas

Name of Tract	Johnstown City 4th. Wd.	9th. Wd.	10th. Wd.	17th. Wd.	Daisytown Boro.	Dale Boro.	Stonycreek Twp.	Conemaugh Twp.	Total Area
John H. Horrocks			3.80					15.30	19.10
Scott Dibert			2.81					3.56	6.37
[illegible]	2.03	5.26	1.81		15.30			7.30	29.70
Cover-Hamm #2							9.56	43.39	52.95
Jacob Fend #1	4.00			0.33	24.72		11.70	3.15	43.90
Jacob Fend #2				0.39	58.48				58.87
Wm. Kuntz #1				82.41	3.79	5.05	13.75		105.00
Wm. Kuntz #2					12.96				12.96
D.D. Blough				2.19		0.91			3.10
E. & L. Cover								13.70	13.70
Triangular Piece								1.80	1.80
Theo. Cover								24.77	24.77
Worthington Cover					1.30		6.45	17.02	24.77
Frank Cover					18.03		6.80		24.83
Jane Hinchman					10.31		13.01	1.40	24.72
Grand Totals	6.03	5.26	8.22	85.32	143.09	5.96	61.27	131.39	446.54

Area of Coal Remaining Jan. 1, 1920

John H. Horrocks			2.00					3.74	5.74
Scott Dibert			2.60					2.76	5.36
Cover-Hamm #1	0.80	4.70	1.69		3.00			3.80	13.99
Cover-Hamm #2							6.10	7.93	14.03
Jacob Fend #1	3.00				11.23		0.45	1.09	15.77
Jacob Fend #2				0.39	35.52				35.91
Wm. Kuntz #1				66.47	1.70	2.20	16.50		86.89
Wm. Kuntz #2					6.76				6.76
D.D. Blough				0.50		0.40			0.90
E. & L. Cover								0.06	0.06
Triangular Piece								0.00	0.00
Theo. Cover								9.44	9.44
Worthington Cover					0.24		2.92	10.61	13.77
Frank Cover					14.31		6.55		20.86
Jane Hinchman					3.73		10.39	1.00	15.12
Grand Totals	3.80	4.70	6.29	67.36	76.49	2.60	42.91	40.37	244.54

7-A-114