


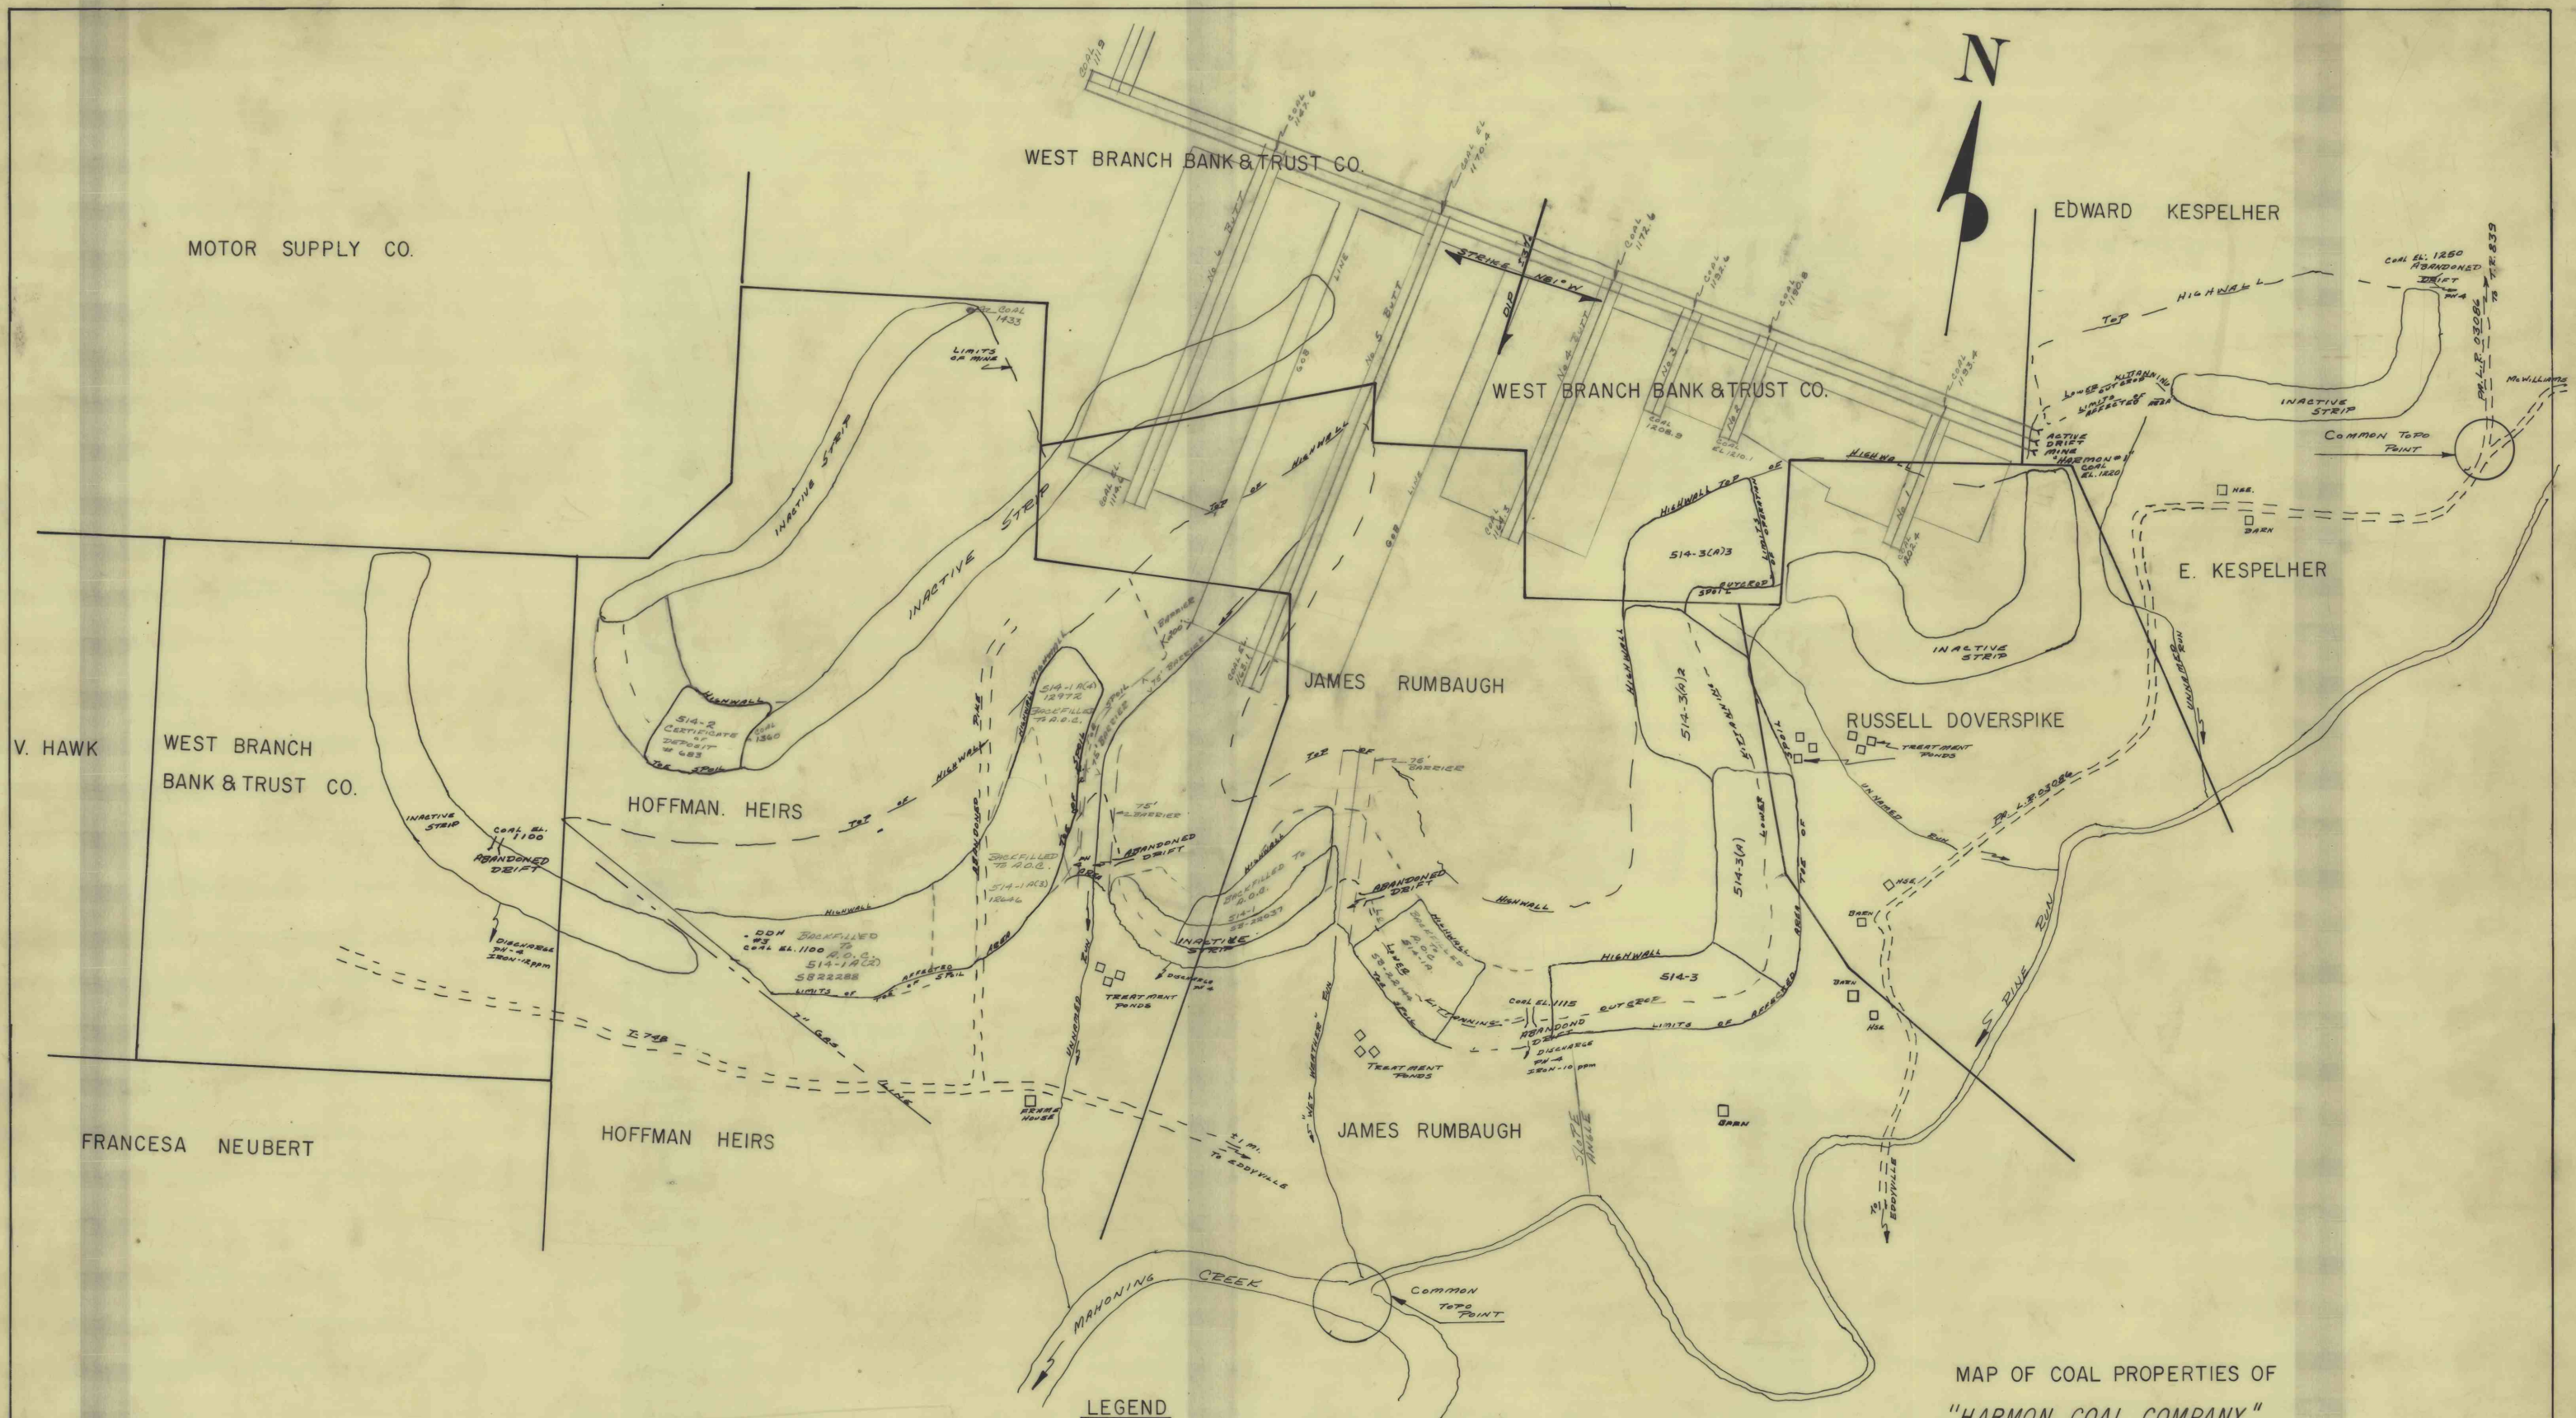

MAP OF COAL PROPERTIES OF
"HARMON COAL COMPANY"
REDBANK TWP, ARMSTRONG CO.
PENNSYLVANIA

scale: 1"=400'
date: 12/27/68

W. N. Green