


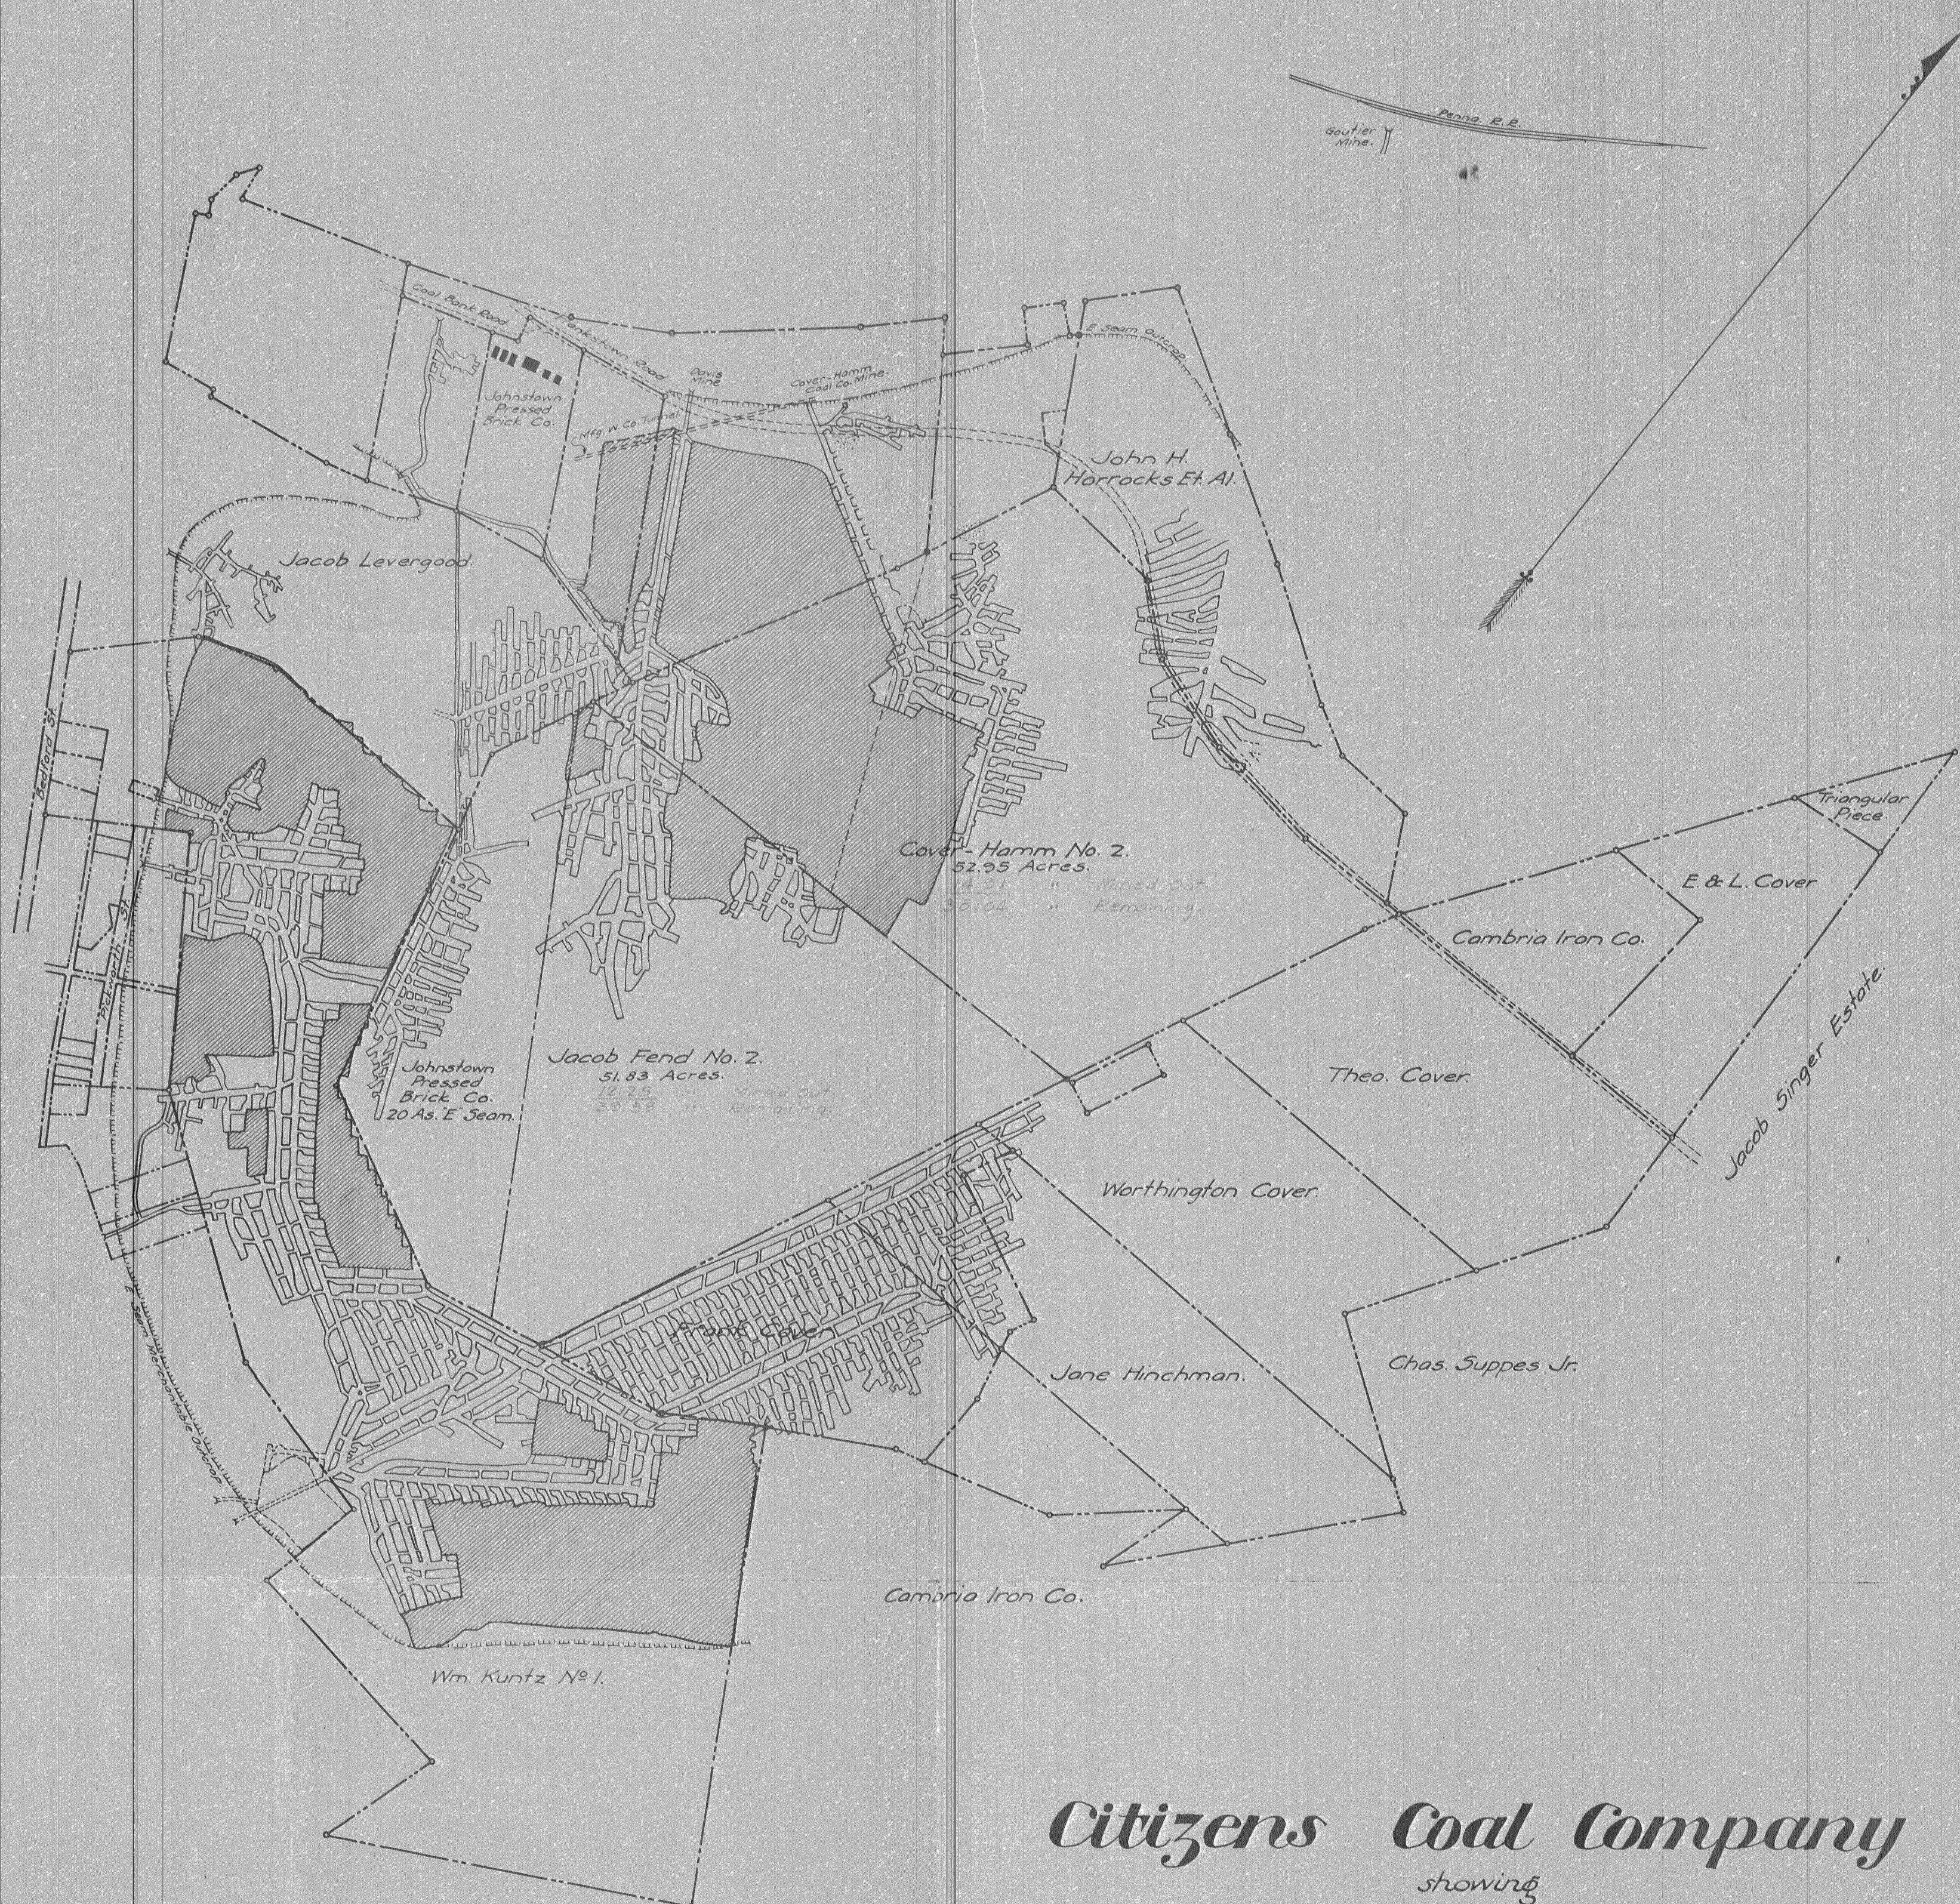

Citizens Coal Company

showing

"E" or Lemon Seam Property

Situate in

City of Johnstown, Daisytown and Dale
Boroughs, Conemaugh and Stonycreek
Townships, Cambria County, Penna.

Scale 1"=400' S.E. Dickey and Co. Dec. 6, 1919.

Civil and Mining Engineers
Johnstown, Penna.