


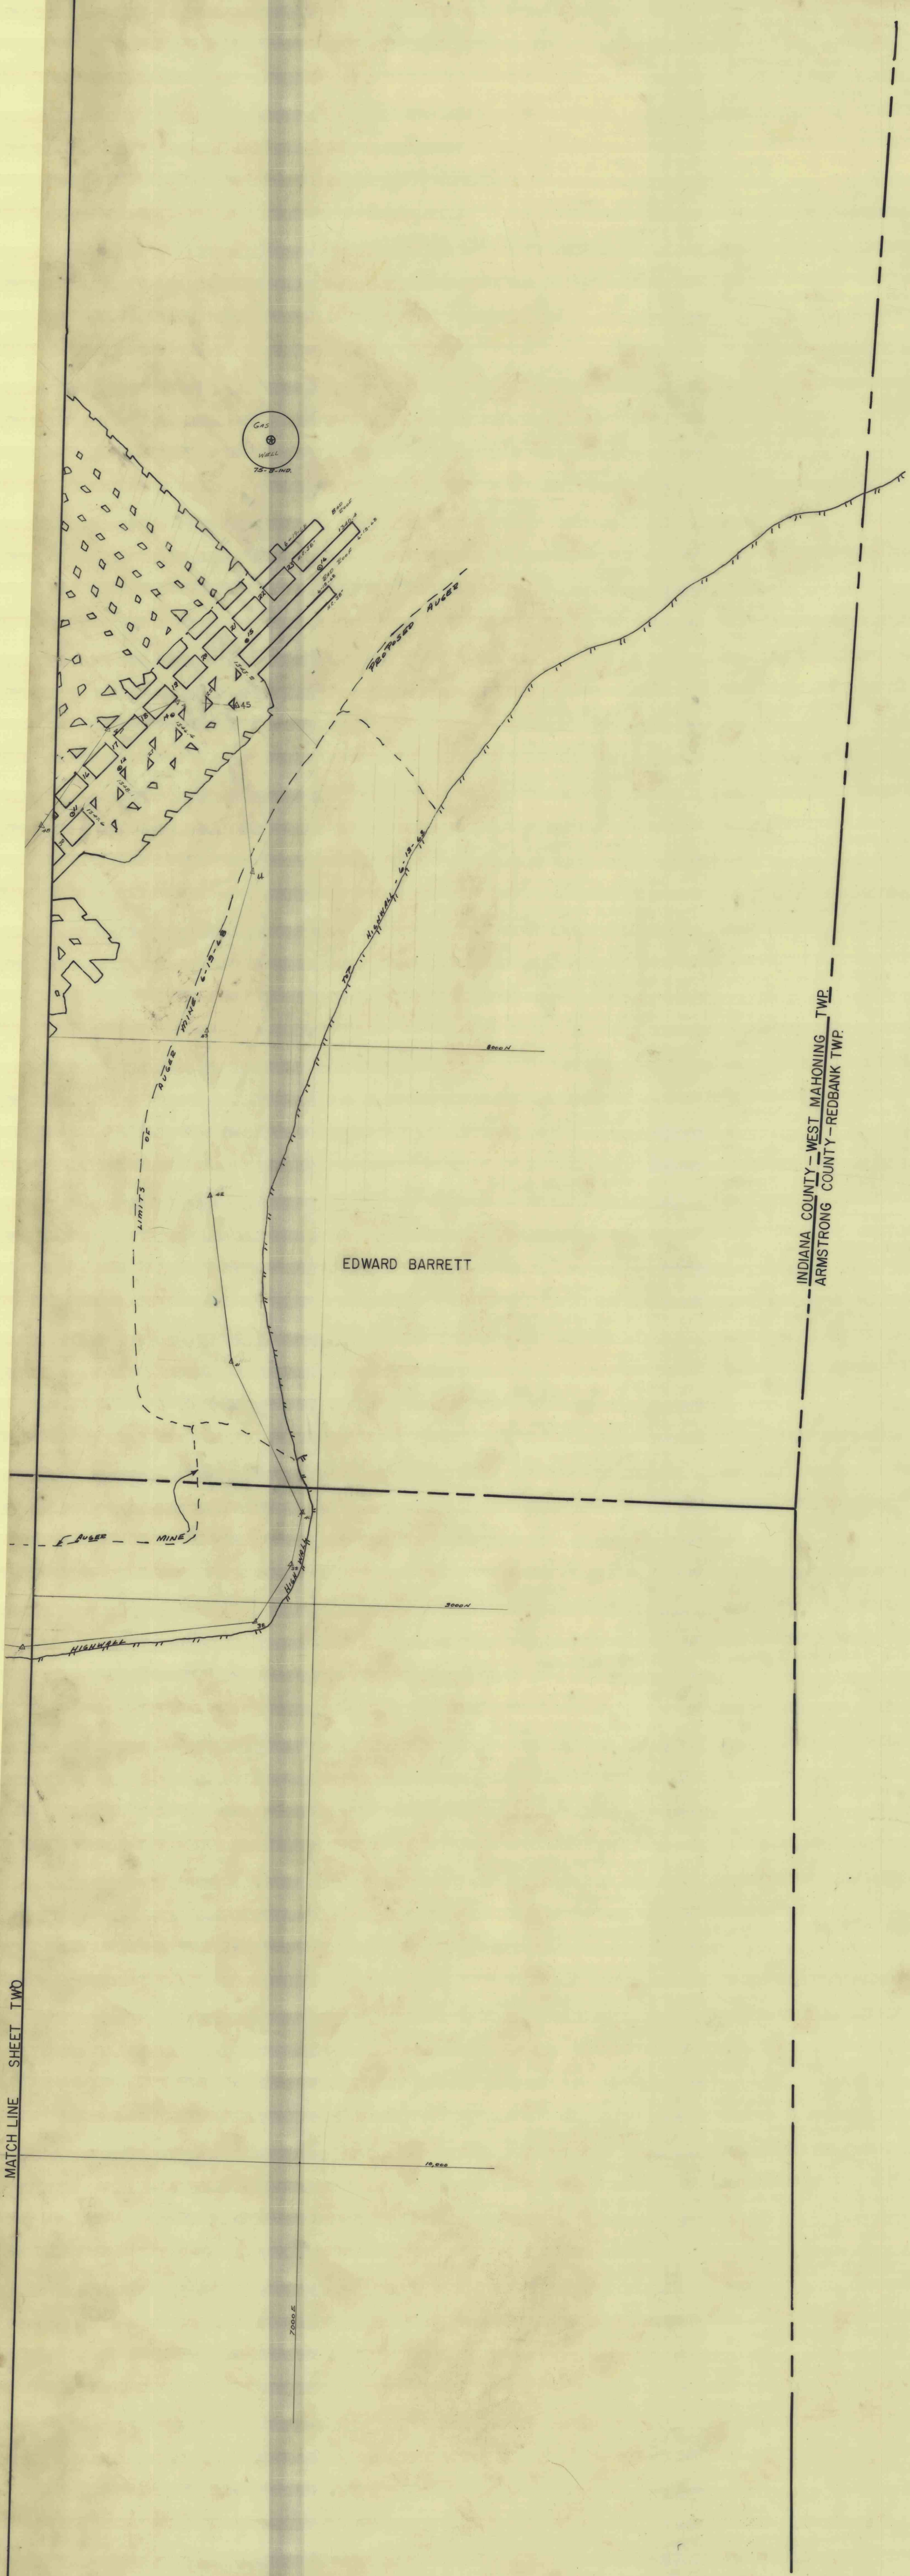

INDIANA COUNTY - WEST MAHONING TWP
ARMSTRONG COUNTY - REDBANK TWP