

11,000 N

10,000 N

PETER TOWNSHIP
WEST MAHONING TOWNSHIP

9,000 N

8,000 N

11,000 N


10,000 N

JEFFERSON COUNTY
INDIANA COUNTY


PETER TOWNSHIP
WEST MAHONING TOWNSHIP

9,000 N

W. A. DRUMMOND

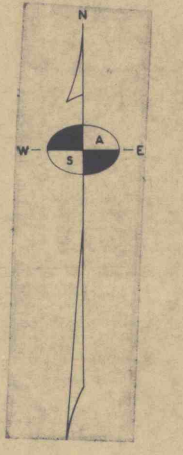

LEGEND
A. AUG 27, 1965
B. SEPT 14, 1965
C. OCT 18, 1965
D. DEC 3, 1965
E. JAN 17, 1966
F. FEB 15, 1966
G. MARCH 22, 1966

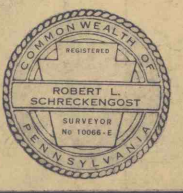

MINE MAP
RINGOLD MINES, INC.
WEST MAHONING TWP., INDIANA COUNTY, PA.
PETER TWP., JEFFERSON COUNTY, PA.
R. B. SHANNON & ASSOCIATES, KITTANNING, PA.
DRAWN BY W. E. S. DATE SEPT 1965
SCALE 1"=1000' FEET DRAWING NO. F-265
SHEET NO. 1