


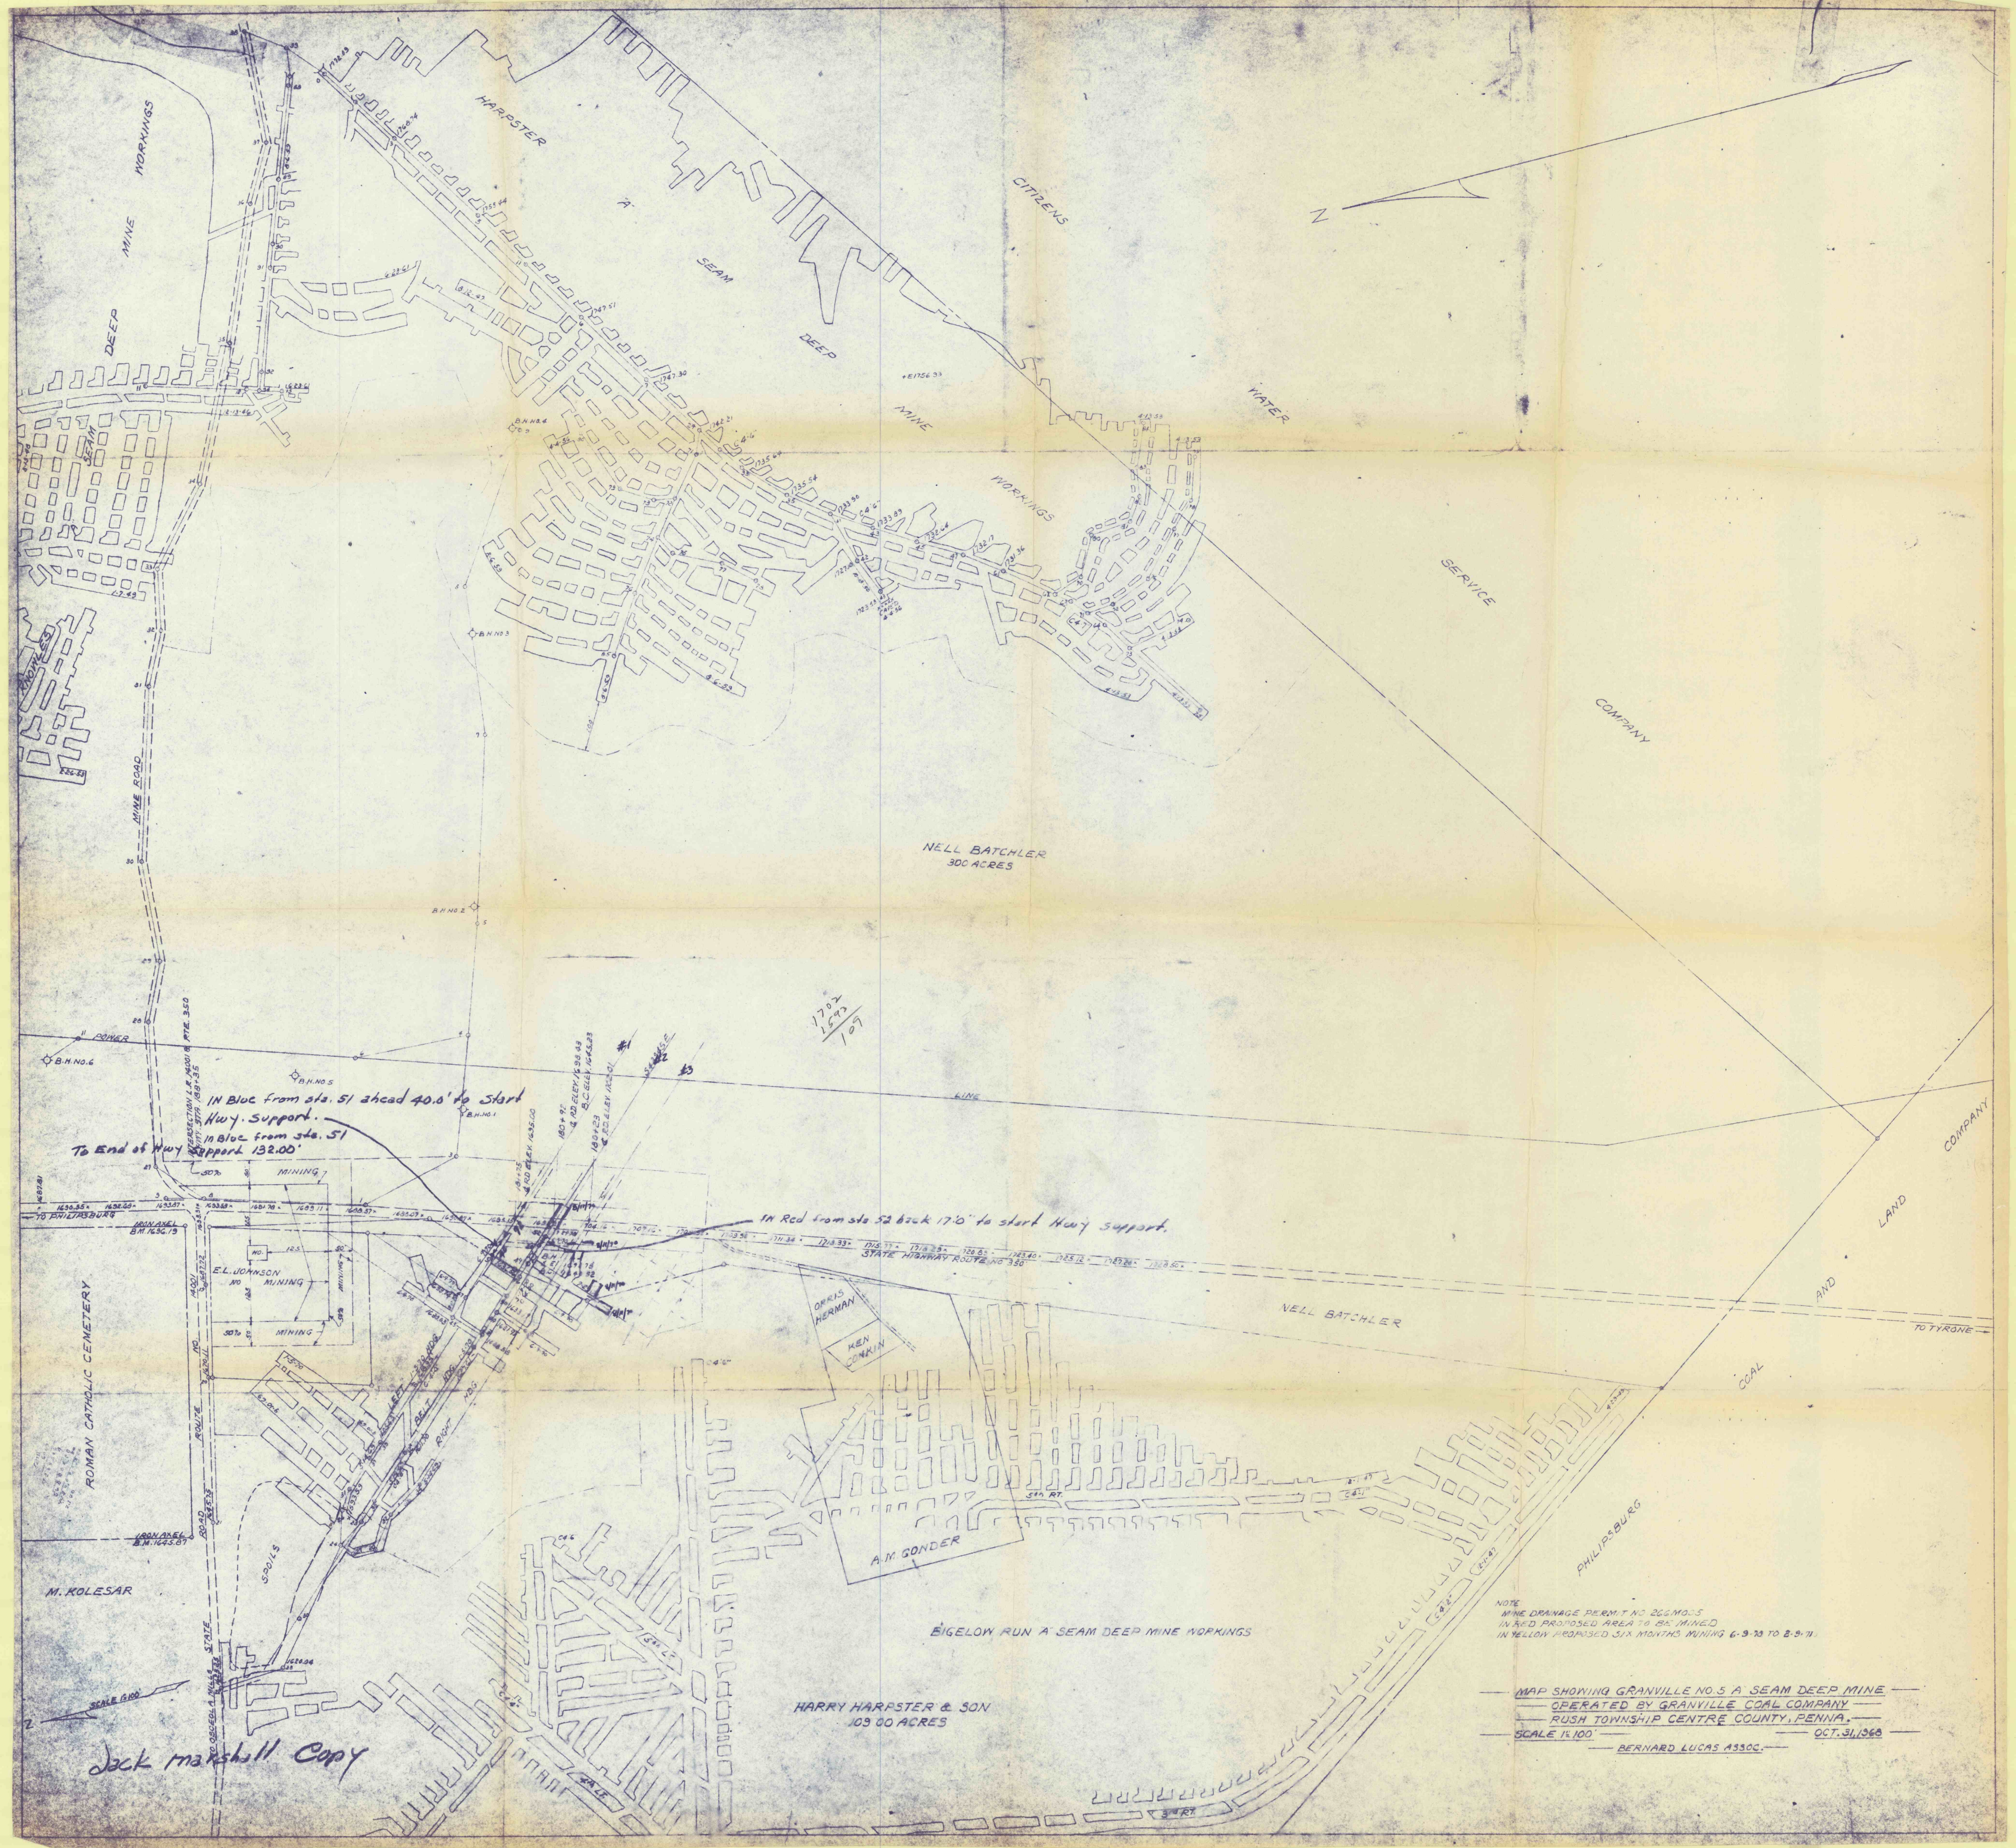

IN Blue from sta. 51 ahead 40.0' to start Hwy. Support.
IN Blue from sta. 51
To End of Hwy Support 132.00'

1704
1592
109

IN Red from sta 52 back 17.0' to start Hwy Support.

NOTE
MINE DRAINAGE PERMIT NO. 206 NO. 5
IN RED PROPOSED AREA TO BE MINED
IN YELLOW PROPOSED SIX MONTHS MINING 6-9-33 TO 8-9-34

MAP SHOWING GRANVILLE NO. 5 A SEAM DEEP MINE
OPERATED BY GRANVILLE COAL COMPANY
RUSH TOWNSHIP CENTRE COUNTY, PENNA.
SCALE 1"=100' OCT. 31, 1934
BERNARD LUCAS ASSOC.

Jack Marshall Copy