


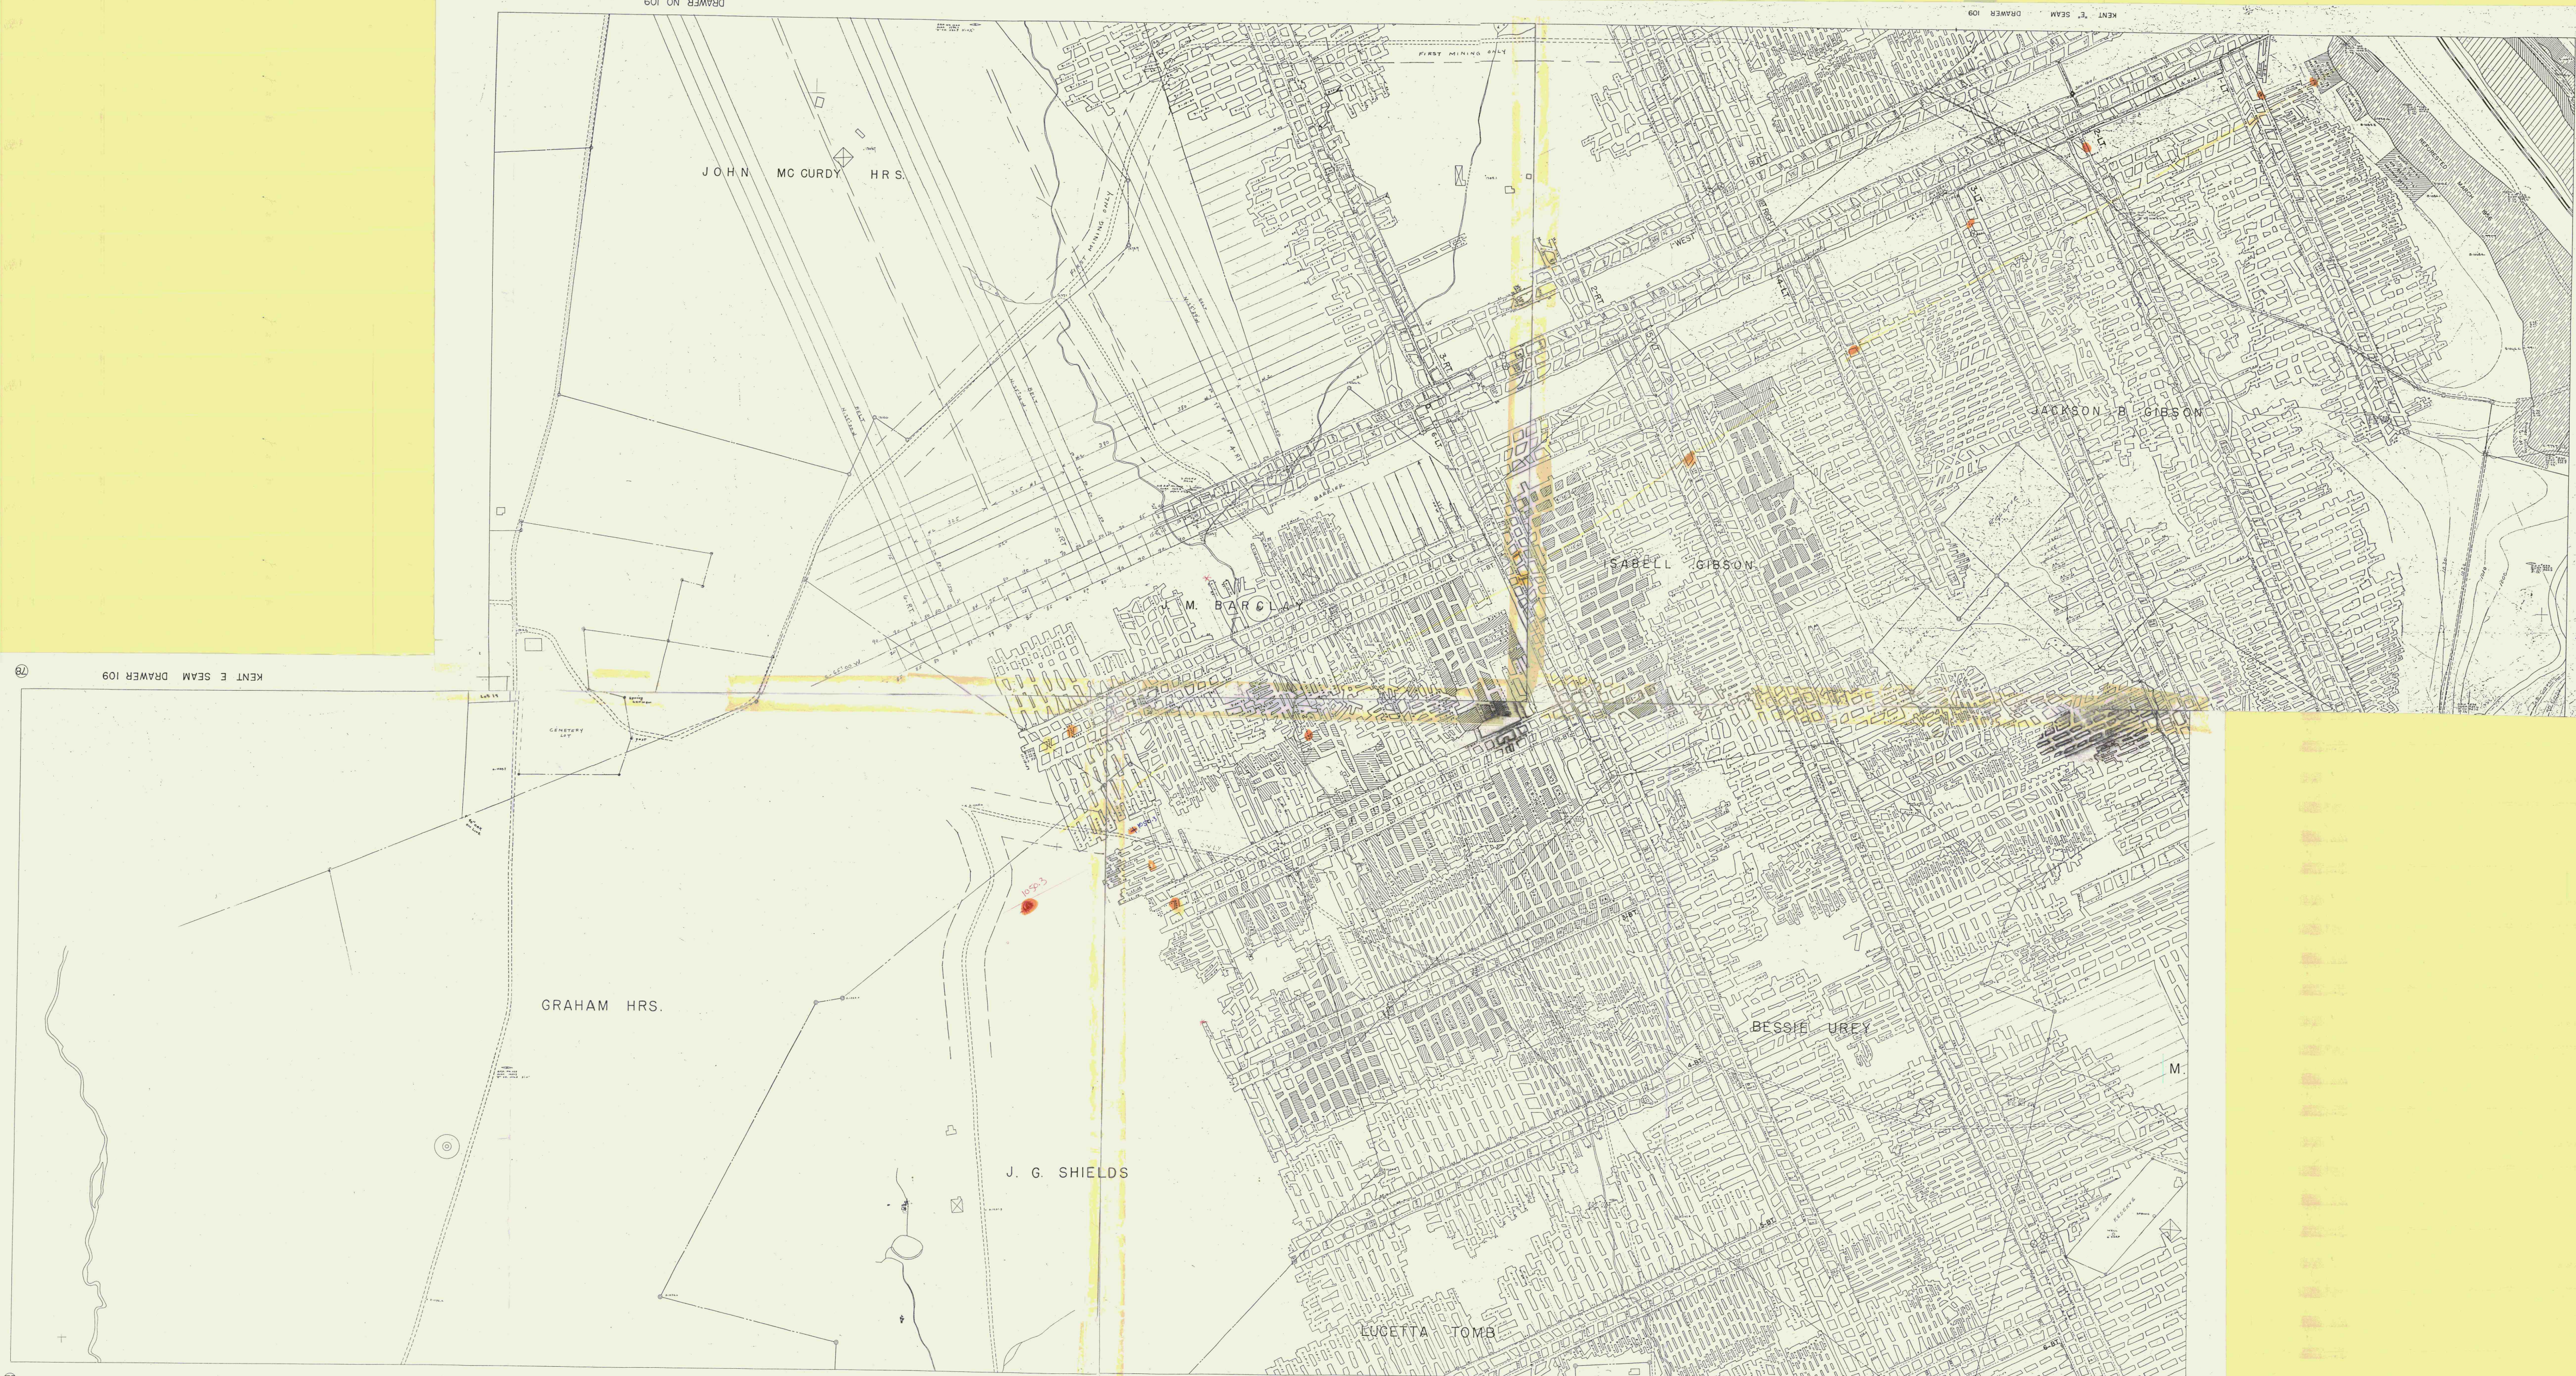

76 KENT E SEAM DRAWER 109

78

KENT E SEAM DRAWER 109 BASEMENT FILE

76

76

KENT E SEAM DRAWER 109 BASEMENT FILE

76

HELVETIA COAL COMPANY
CLARKSBURG, INDIANA COUNTY, PA.
Scale 1" = 200' Date 6-9-25

HELVETIA COAL COMPANY
CLARKSBURG, INDIANA COUNTY, PA.
Scale 1" = 200' Date 6-9-25