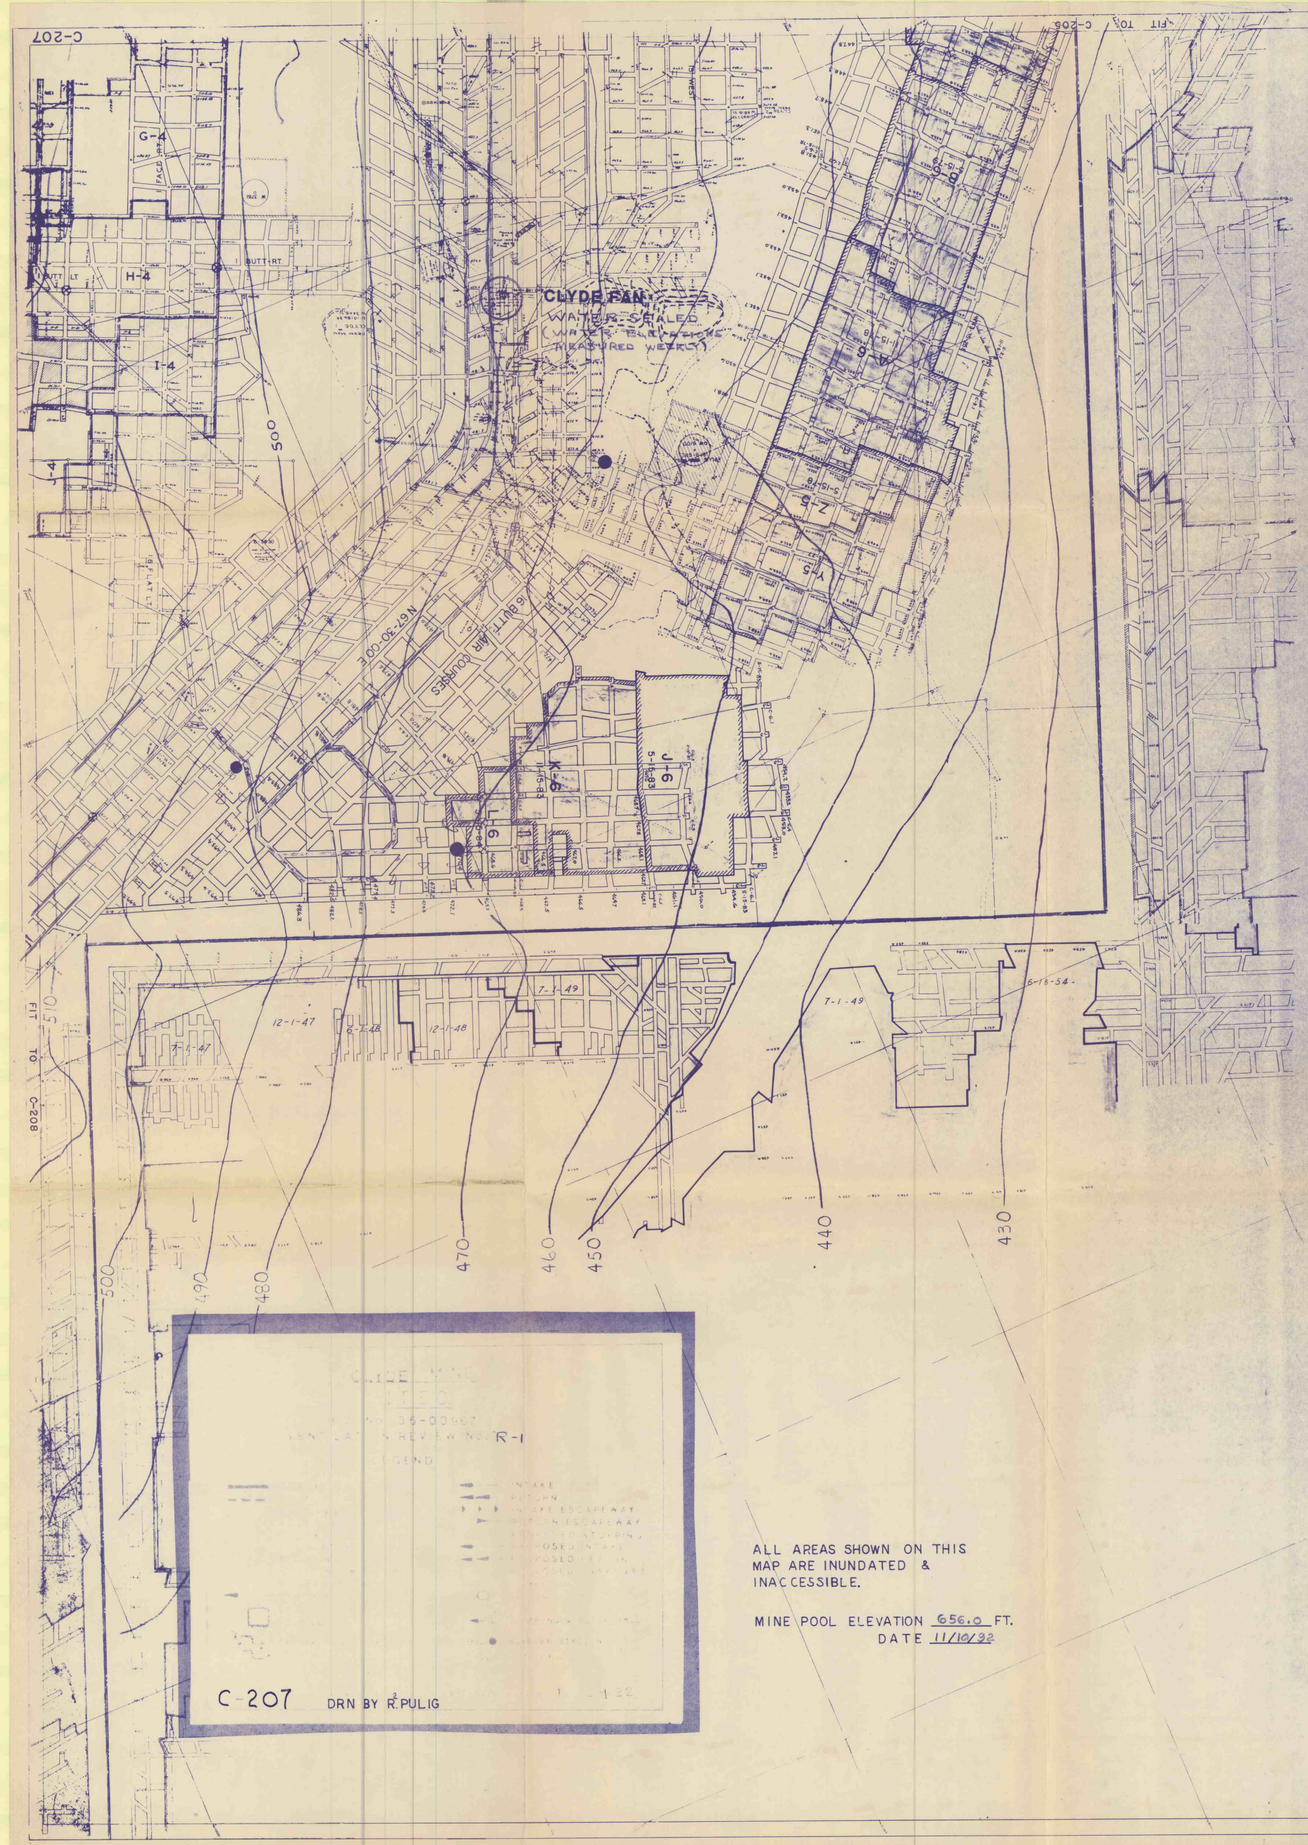

ALL AREAS SHOWN ON THIS MAP ARE INUNDATED & INACCESSIBLE.

MINE POOL ELEVATION 656.0 FT.
