


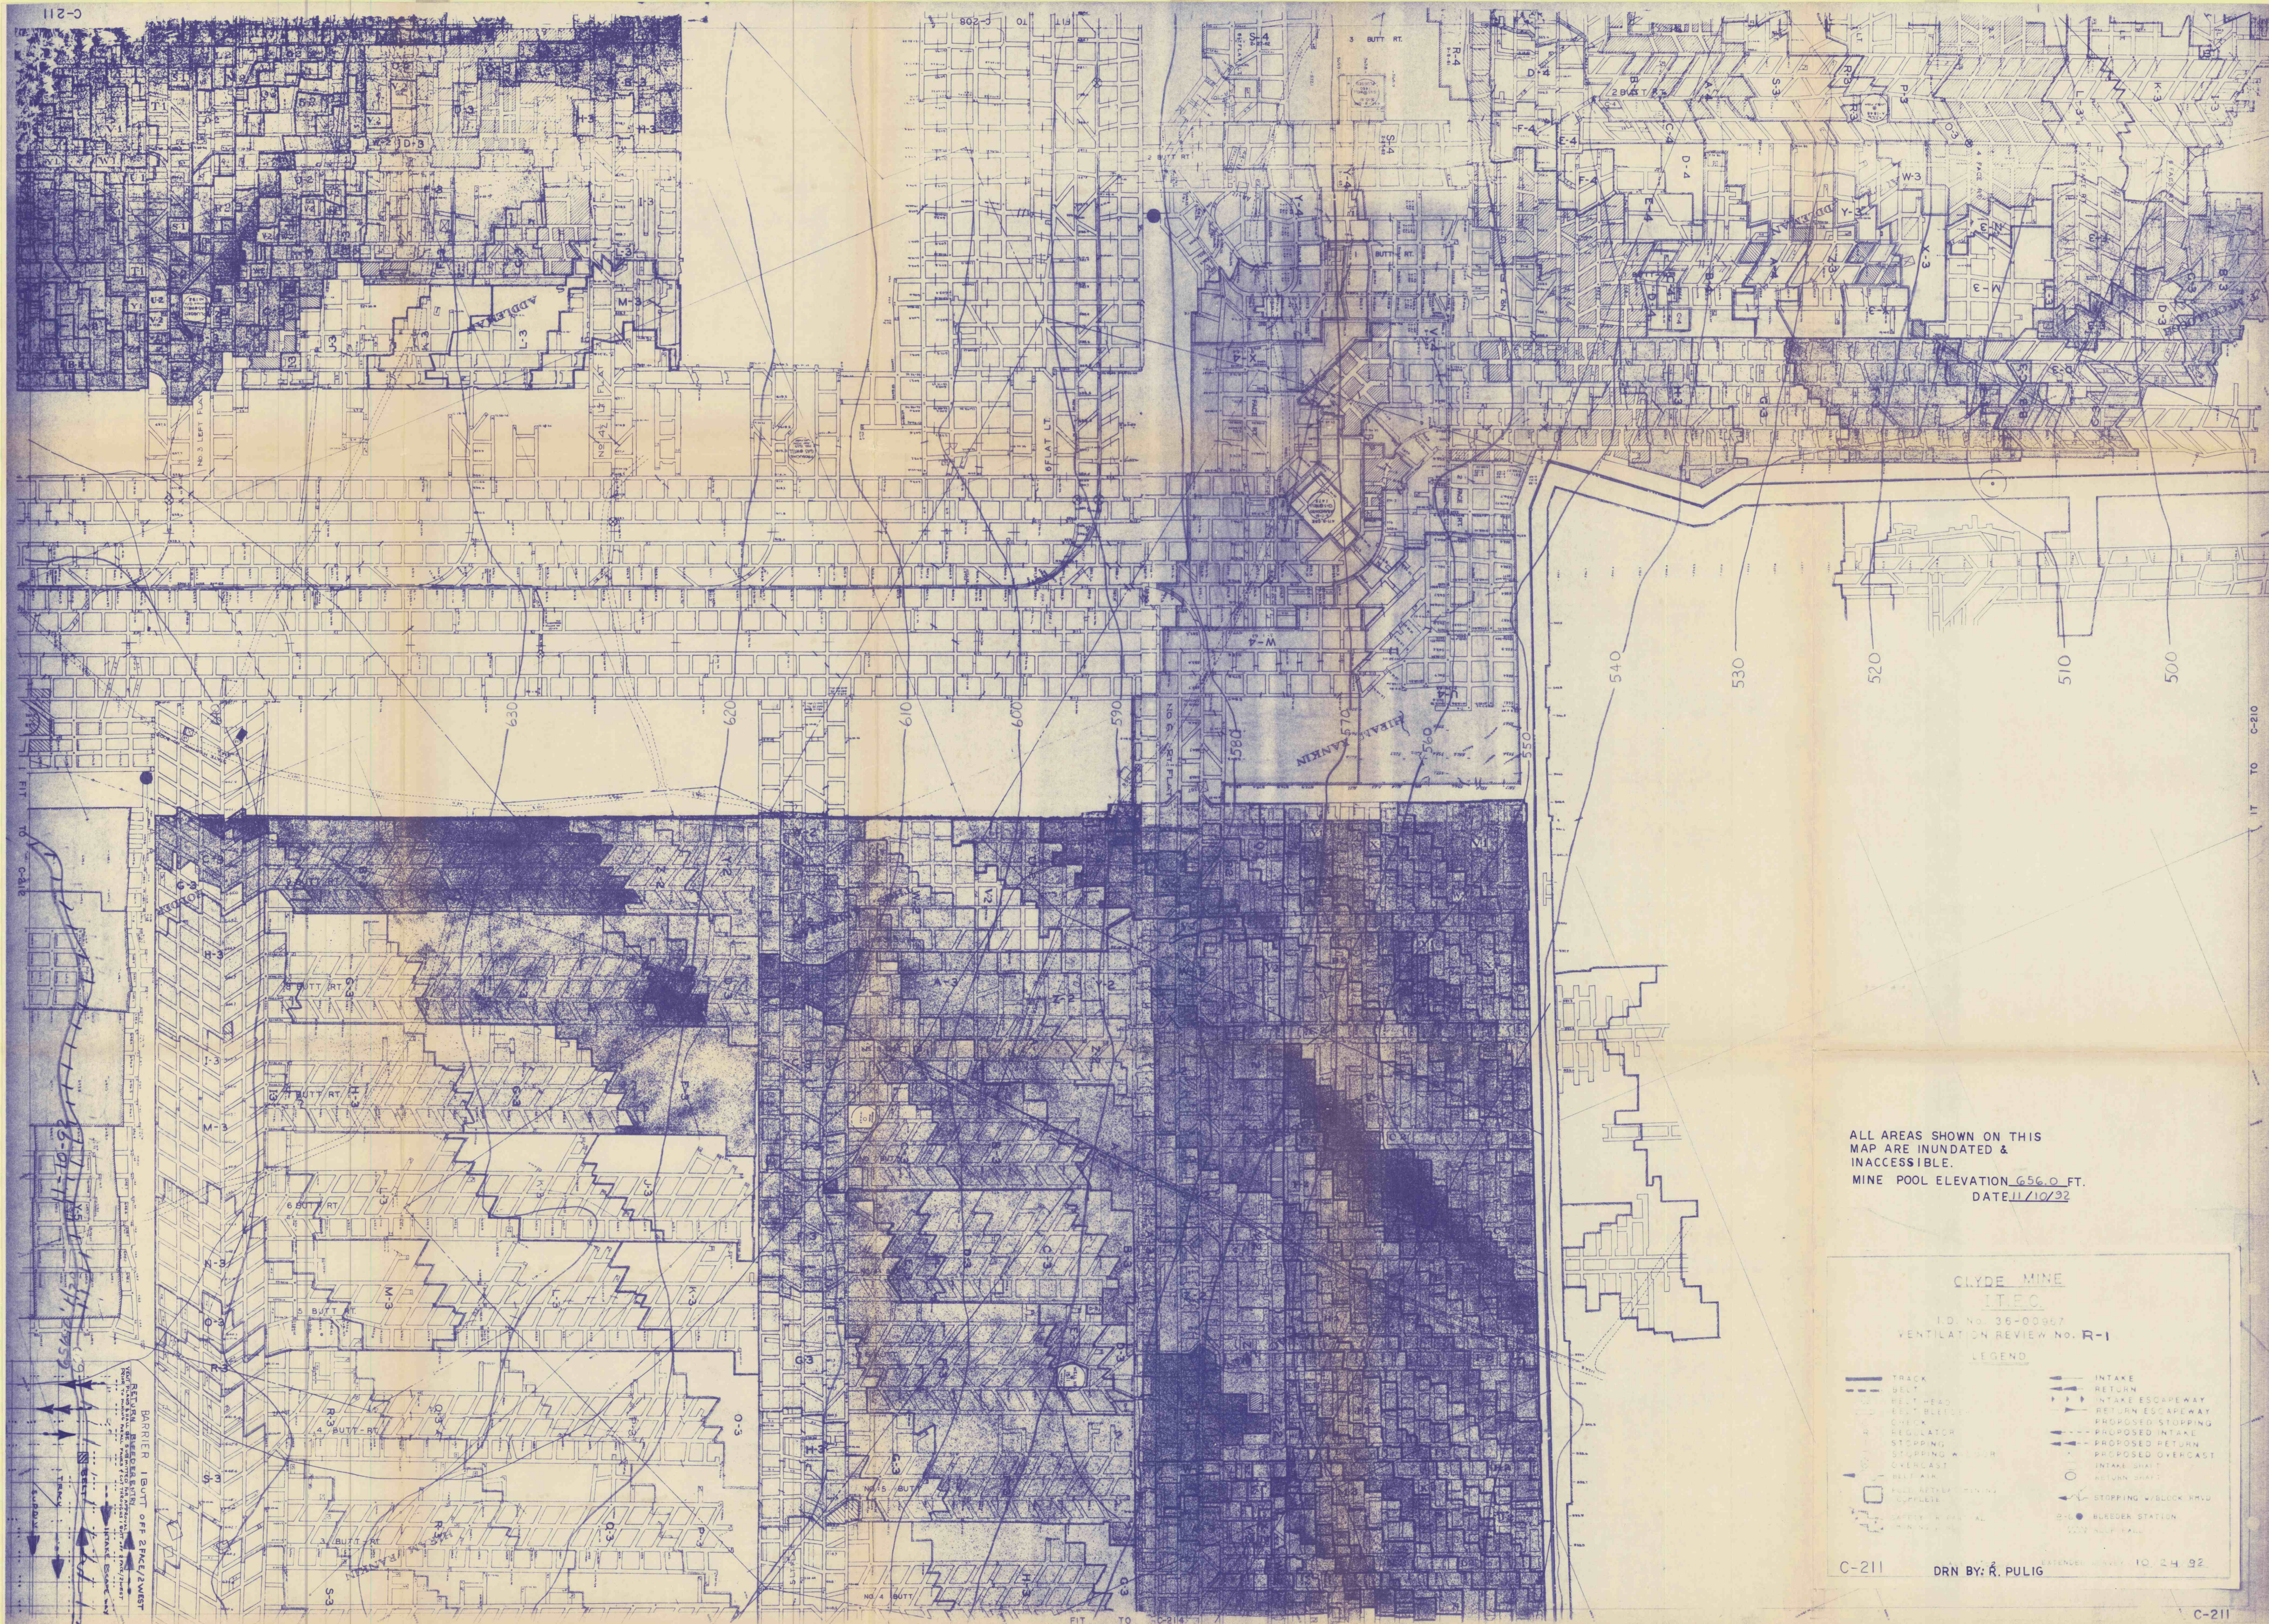

ALL AREAS SHOWN ON THIS
MAP ARE INUNDATED &
INACCESSIBLE.
MINE POOL ELEVATION 656.0 FT.
DATE 11/10/92

CLYDE MINE
I.T.E.C.

I.D. No. 36-00967
VENTILATION REVIEW No. R-1

- | | | | |
|---|----------------------|---|----------------------|
|  | TRACK |  | INTAKE |
|  | BELT |  | RETURN |
|  | BELT HEAD |  | INTAKE ESCAPEWAY |
|  | BELT BLEED |  | RETURN ESCAPEWAY |
|  | CHECK |  | PROPOSED STOPPING |
|  | REGULATOR |  | PROPOSED INTAKE |
|  | STOPPING |  | PROPOSED RETURN |
|  | STOPPING W/BLOCK |  | PROPOSED OVERCAST |
|  | SCHERCAST |  | INTAKE SHAFT |
|  | BELT AIR |  | RETURN SHAFT |
|  | FALLS AFTER TRAINING |  | STOPPING W/BLOCK RWD |
|  | COMPLETE |  | B-C BLEEDER STATION |
|  | SAFETY IN FALL AL |  | W-C R/W FALL |
|  | TRAINING IN FALL | | |

C-211

DRN BY: R. PULIG

EXTENDED SERVICE 10.24.92