HICKORY HILL
MINES
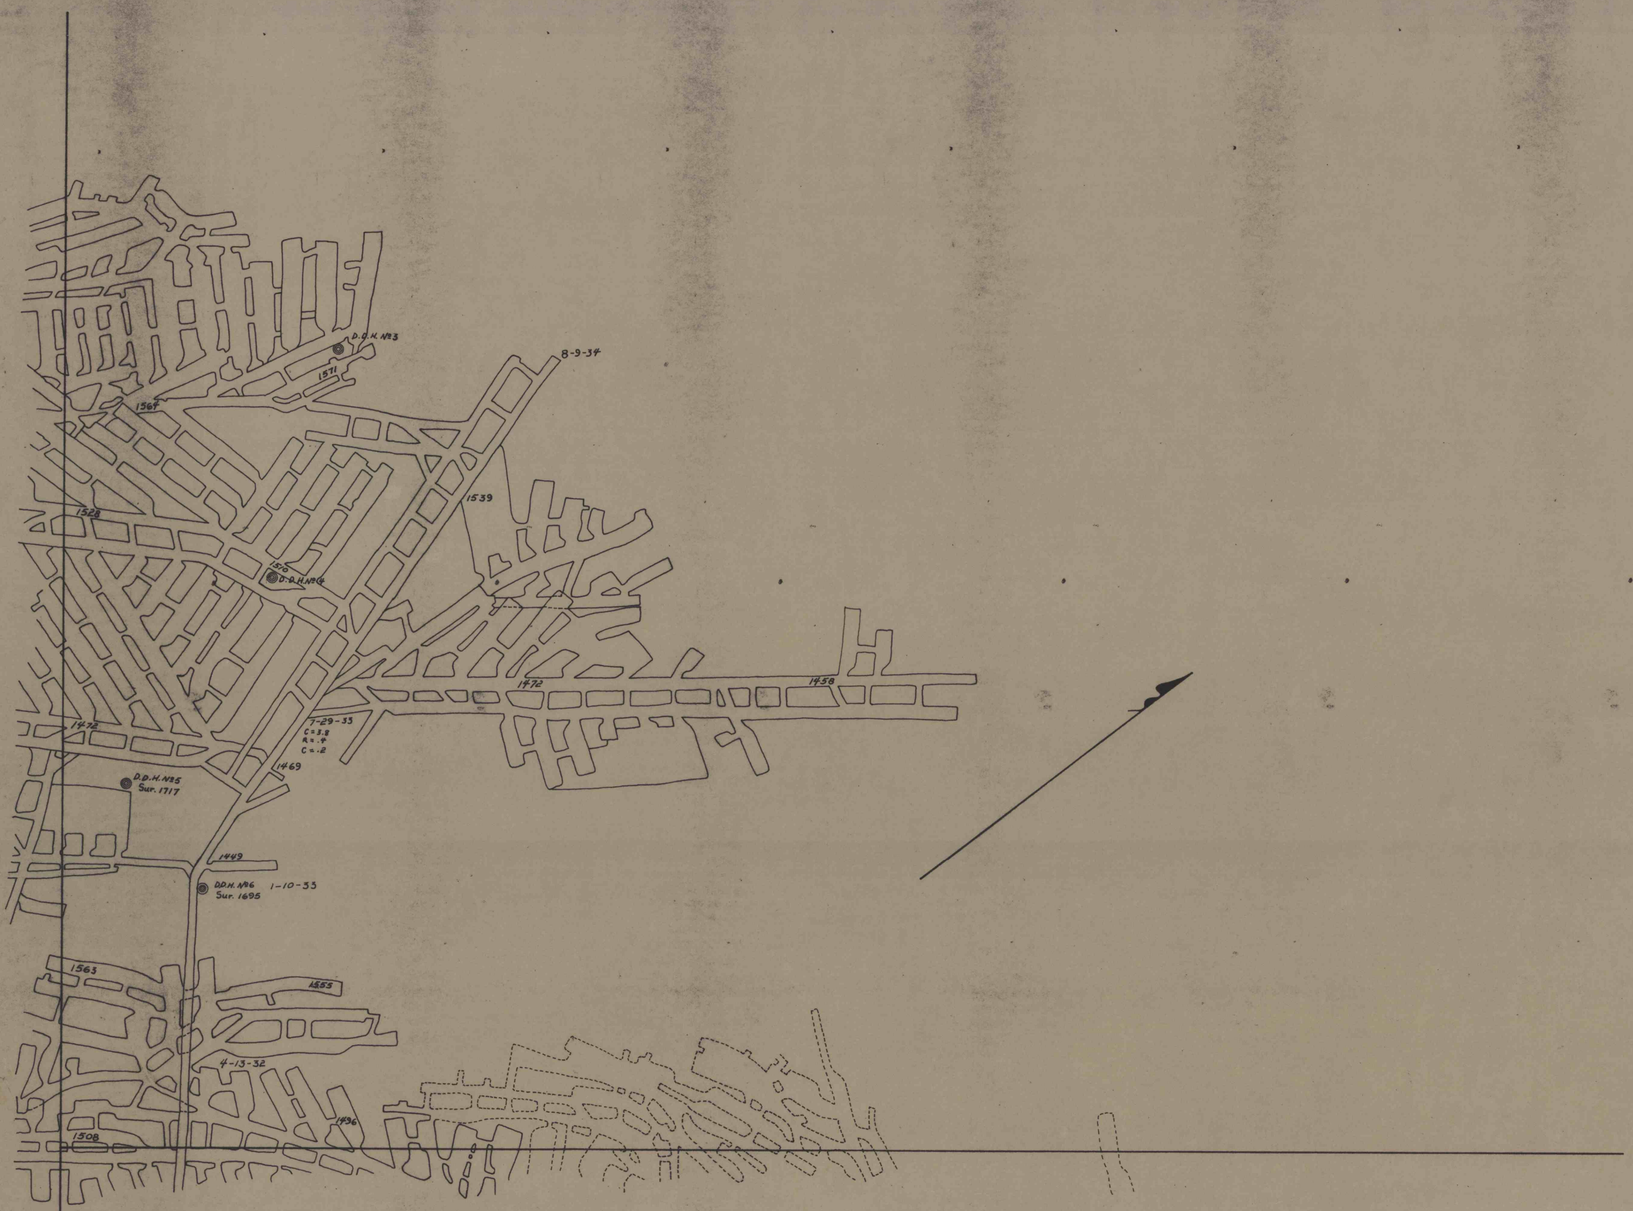
rev. 6-11-40