


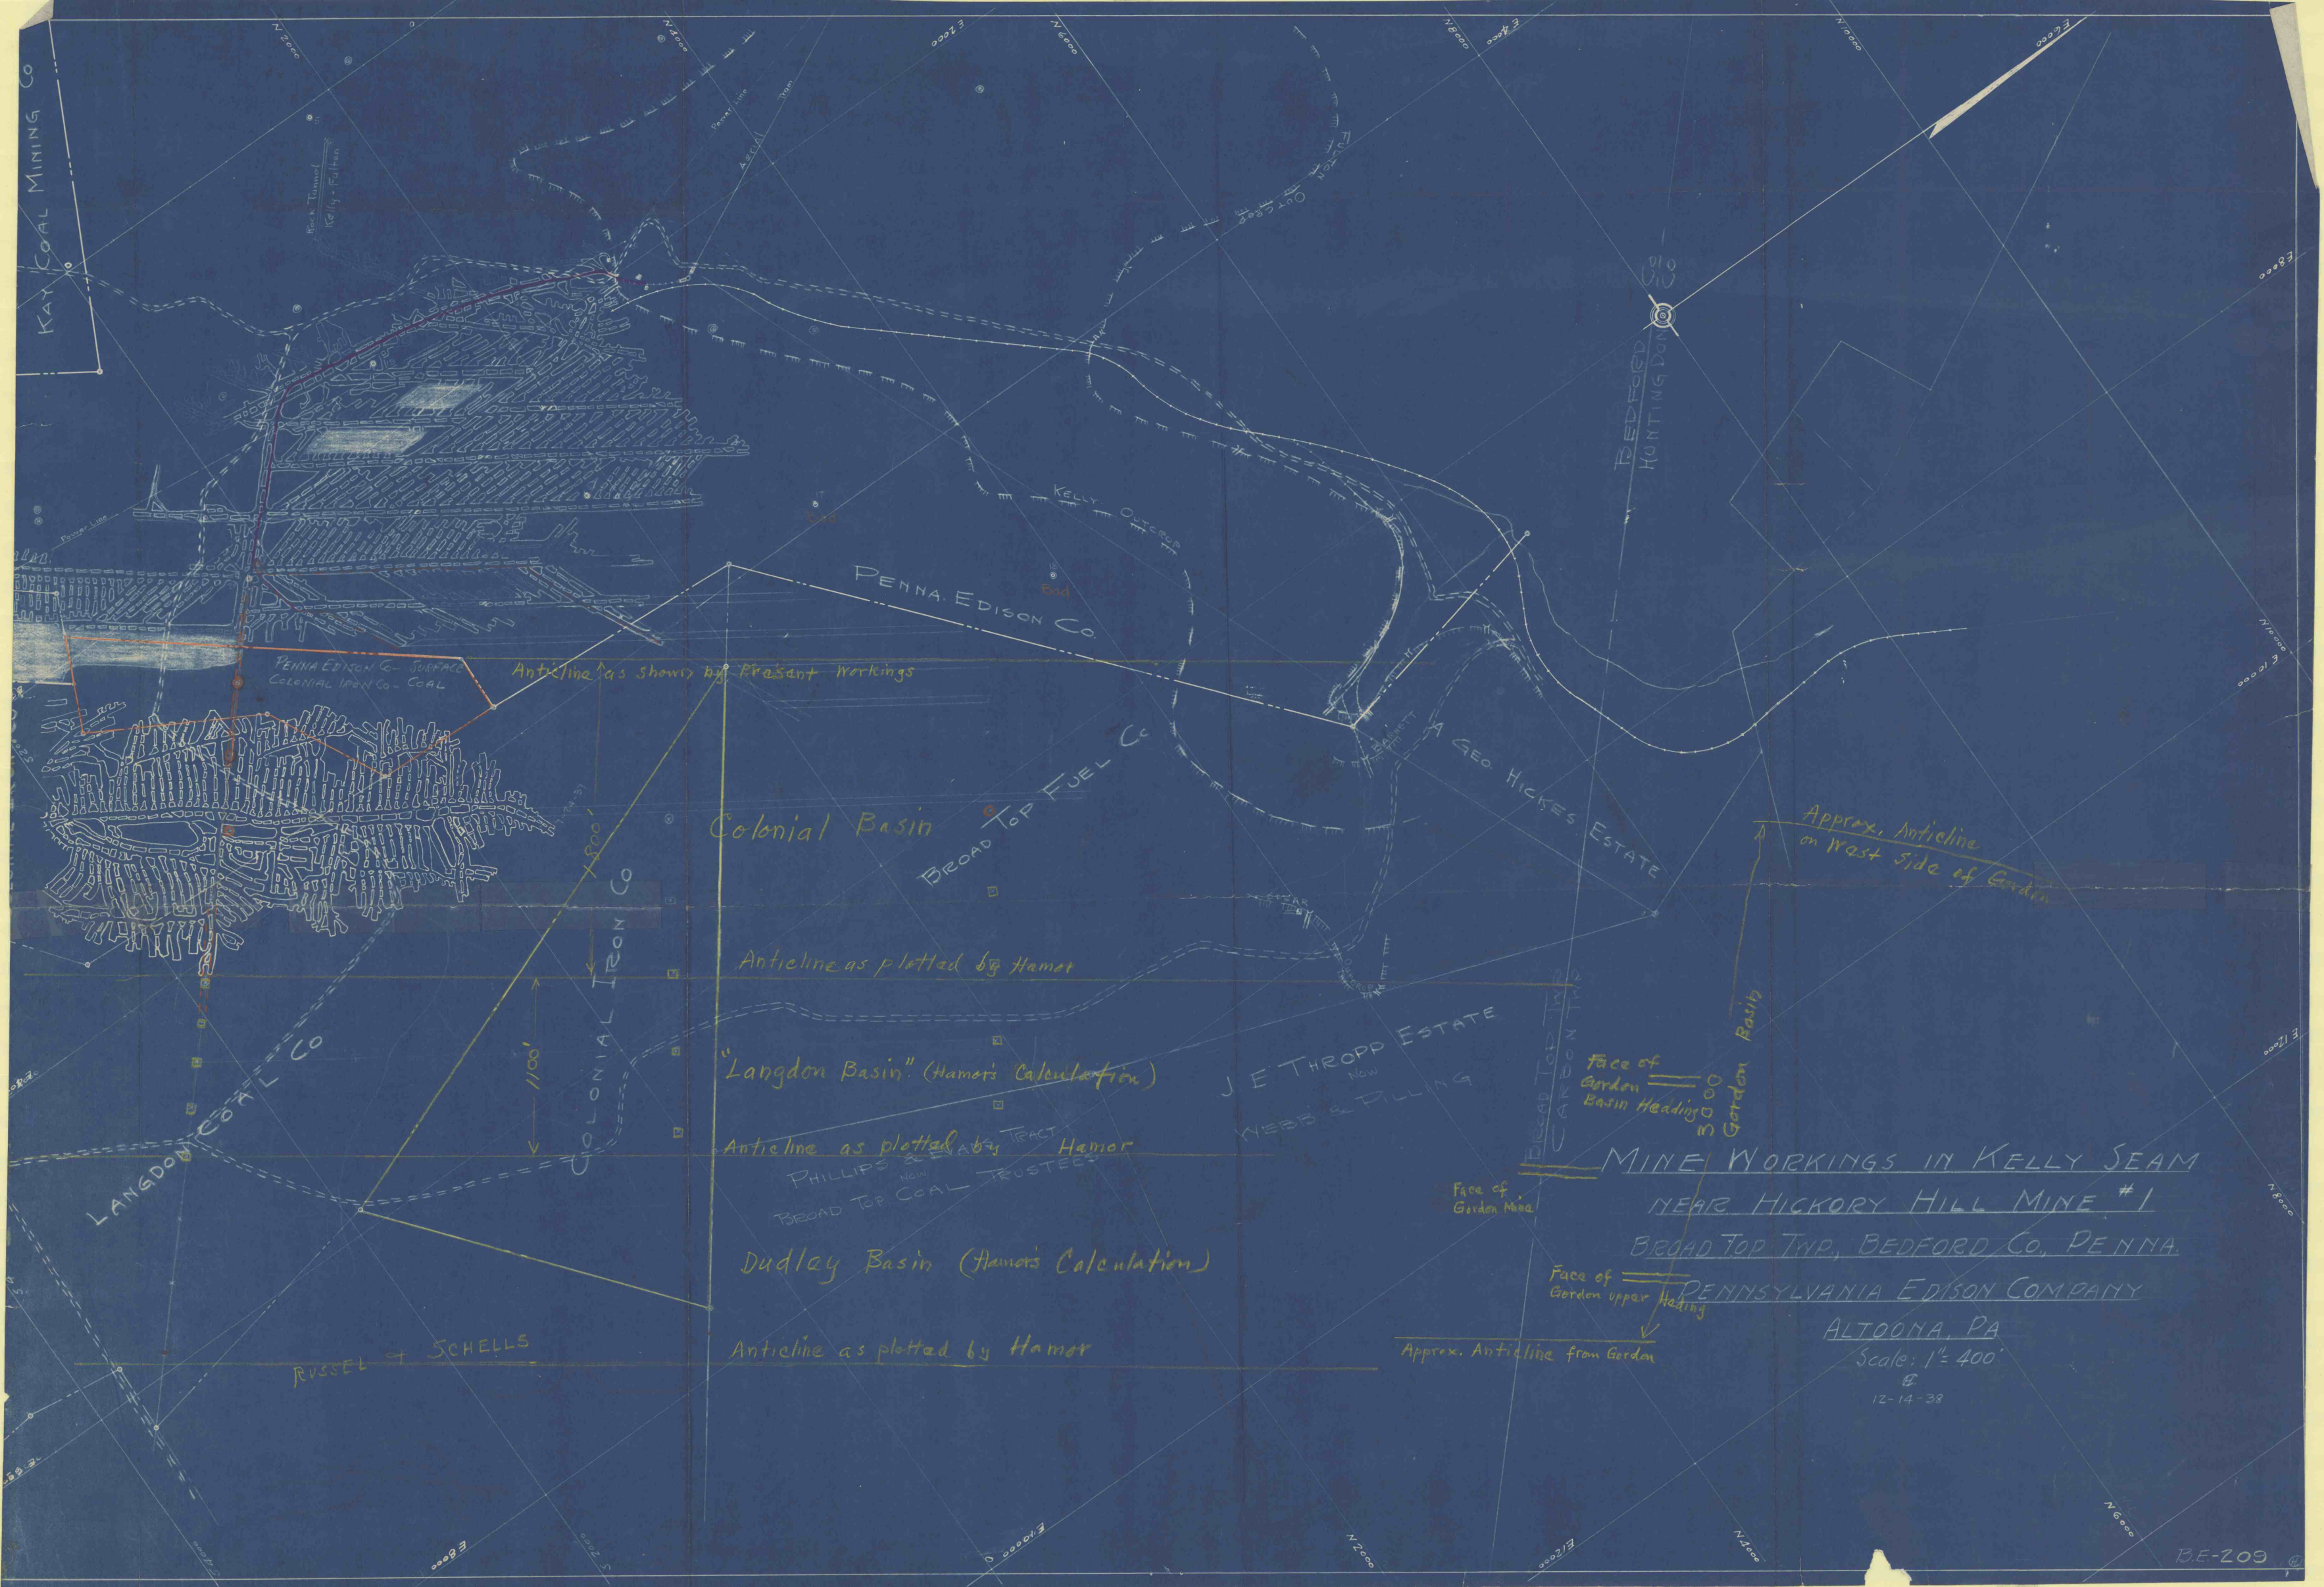

KAY COAL MINING CO

PENNA EDISON CO - SURFACE
COLONIAL IRON CO - COAL

PENNA. EDISON CO.

Colonial Basin

BROAD TOP FUEL CO

BEDFORD
HUNTING DON CO

A GEO. HICKES ESTATE

Approx. Anticline
on West Side of Gordon

Anticline as plotted by Hamor

"Langdon Basin" (Hamor's Calculation)

Anticline as plotted by Hamor

Dudley Basin (Hamor's Calculation)

Anticline as plotted by Hamor

J E THROPP ESTATE
NEBB & PILLING

Face of
Gordon
Basin Heading
in
Gordon
Basin

MINE WORKINGS IN KELLY SEAM

NEAR HICKORY HILL MINE #1

BROAD TOP TWP, BEDFORD CO, PENNA.

PENNSYLVANIA EDISON COMPANY

ALTOONA, PA

Scale: 1" = 400'

12-14-38

Face of
Gordon upper
Heading

Approx. Anticline from Gordon

RUSSEL + SCHELLS