


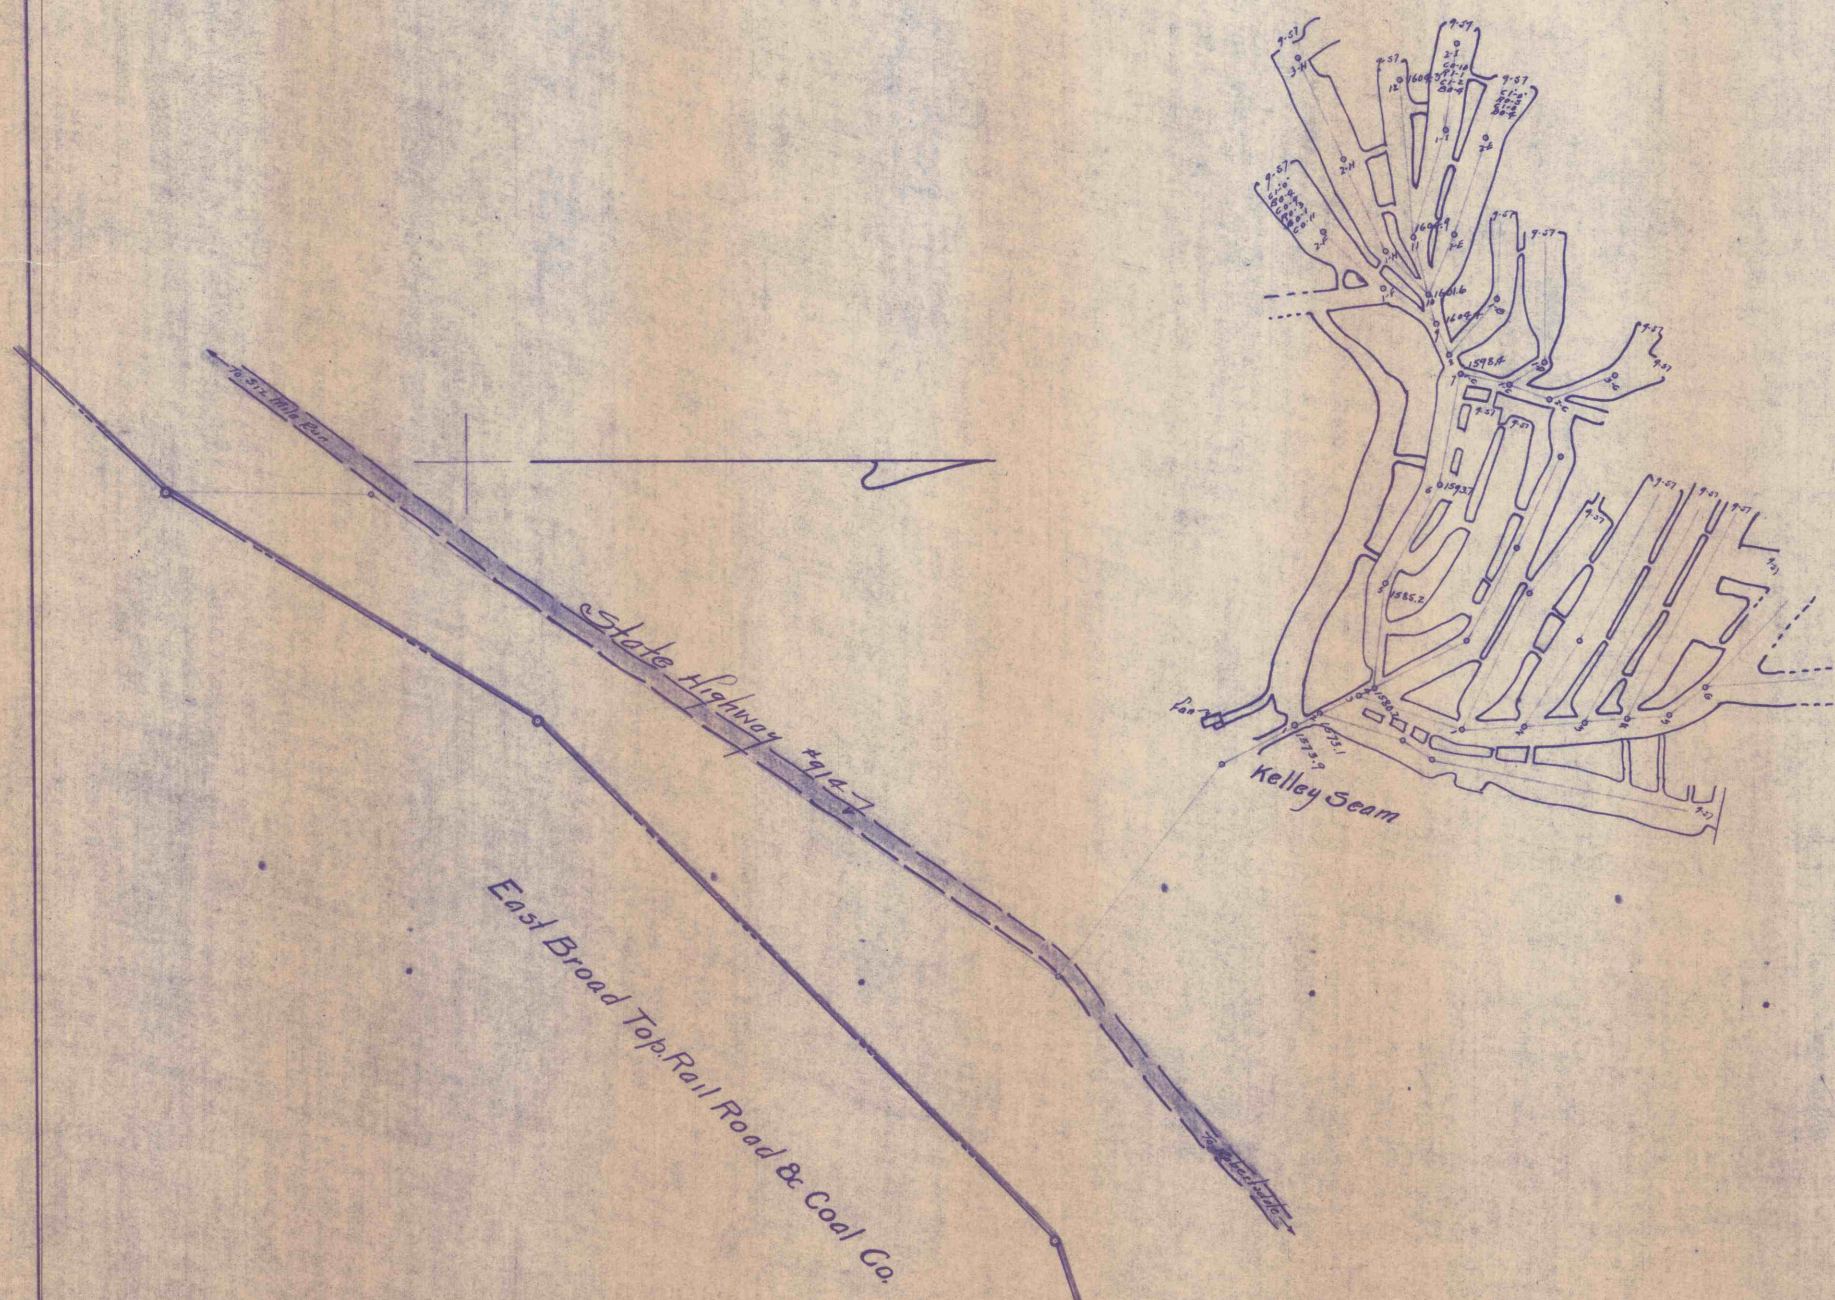

J. B. Harnish Tract

Map Showing Mine Workings on J. B. Harnish Tract Operated By G. Wright Situated in Broad Top Twp Bedford County Pennsylvania, 1"=100' Sept 1937 E. Corrie Egan Robertsdale Pa