


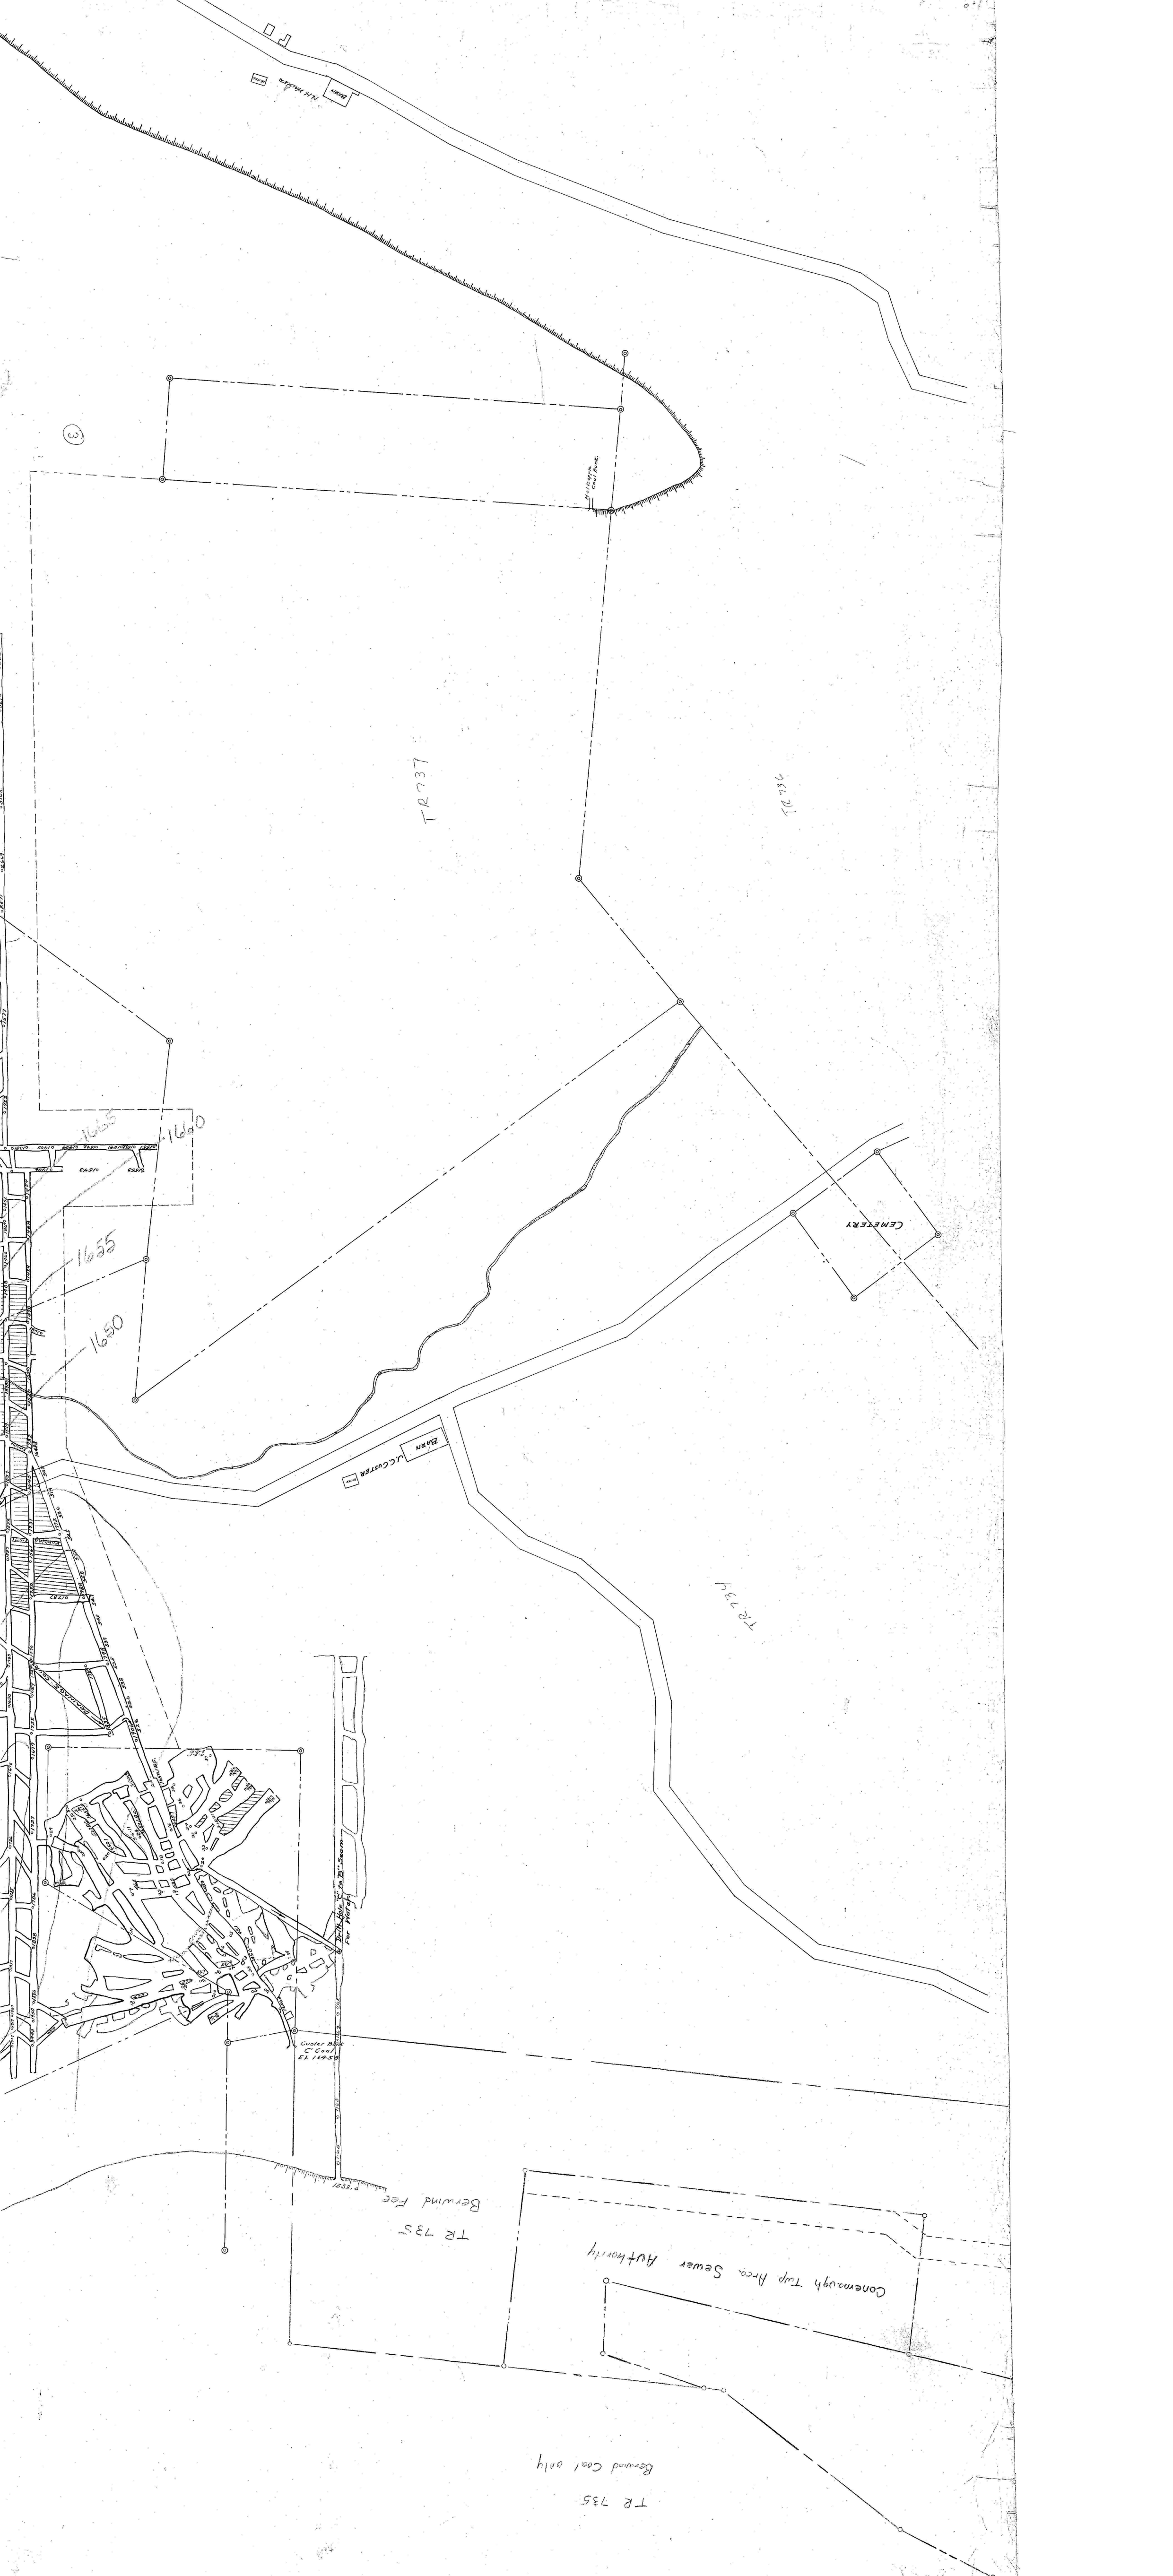

TR 735
Berwind Coal only

Conemaugh Twp Area Sewer Authority

TR 735
Berwind Fac

Cluster B
C' Coal
E1 16950

Cluster B
C' Coal
E1 16950

TR 734

TR 736

TR 737

3

1655

1660

1655

1650