


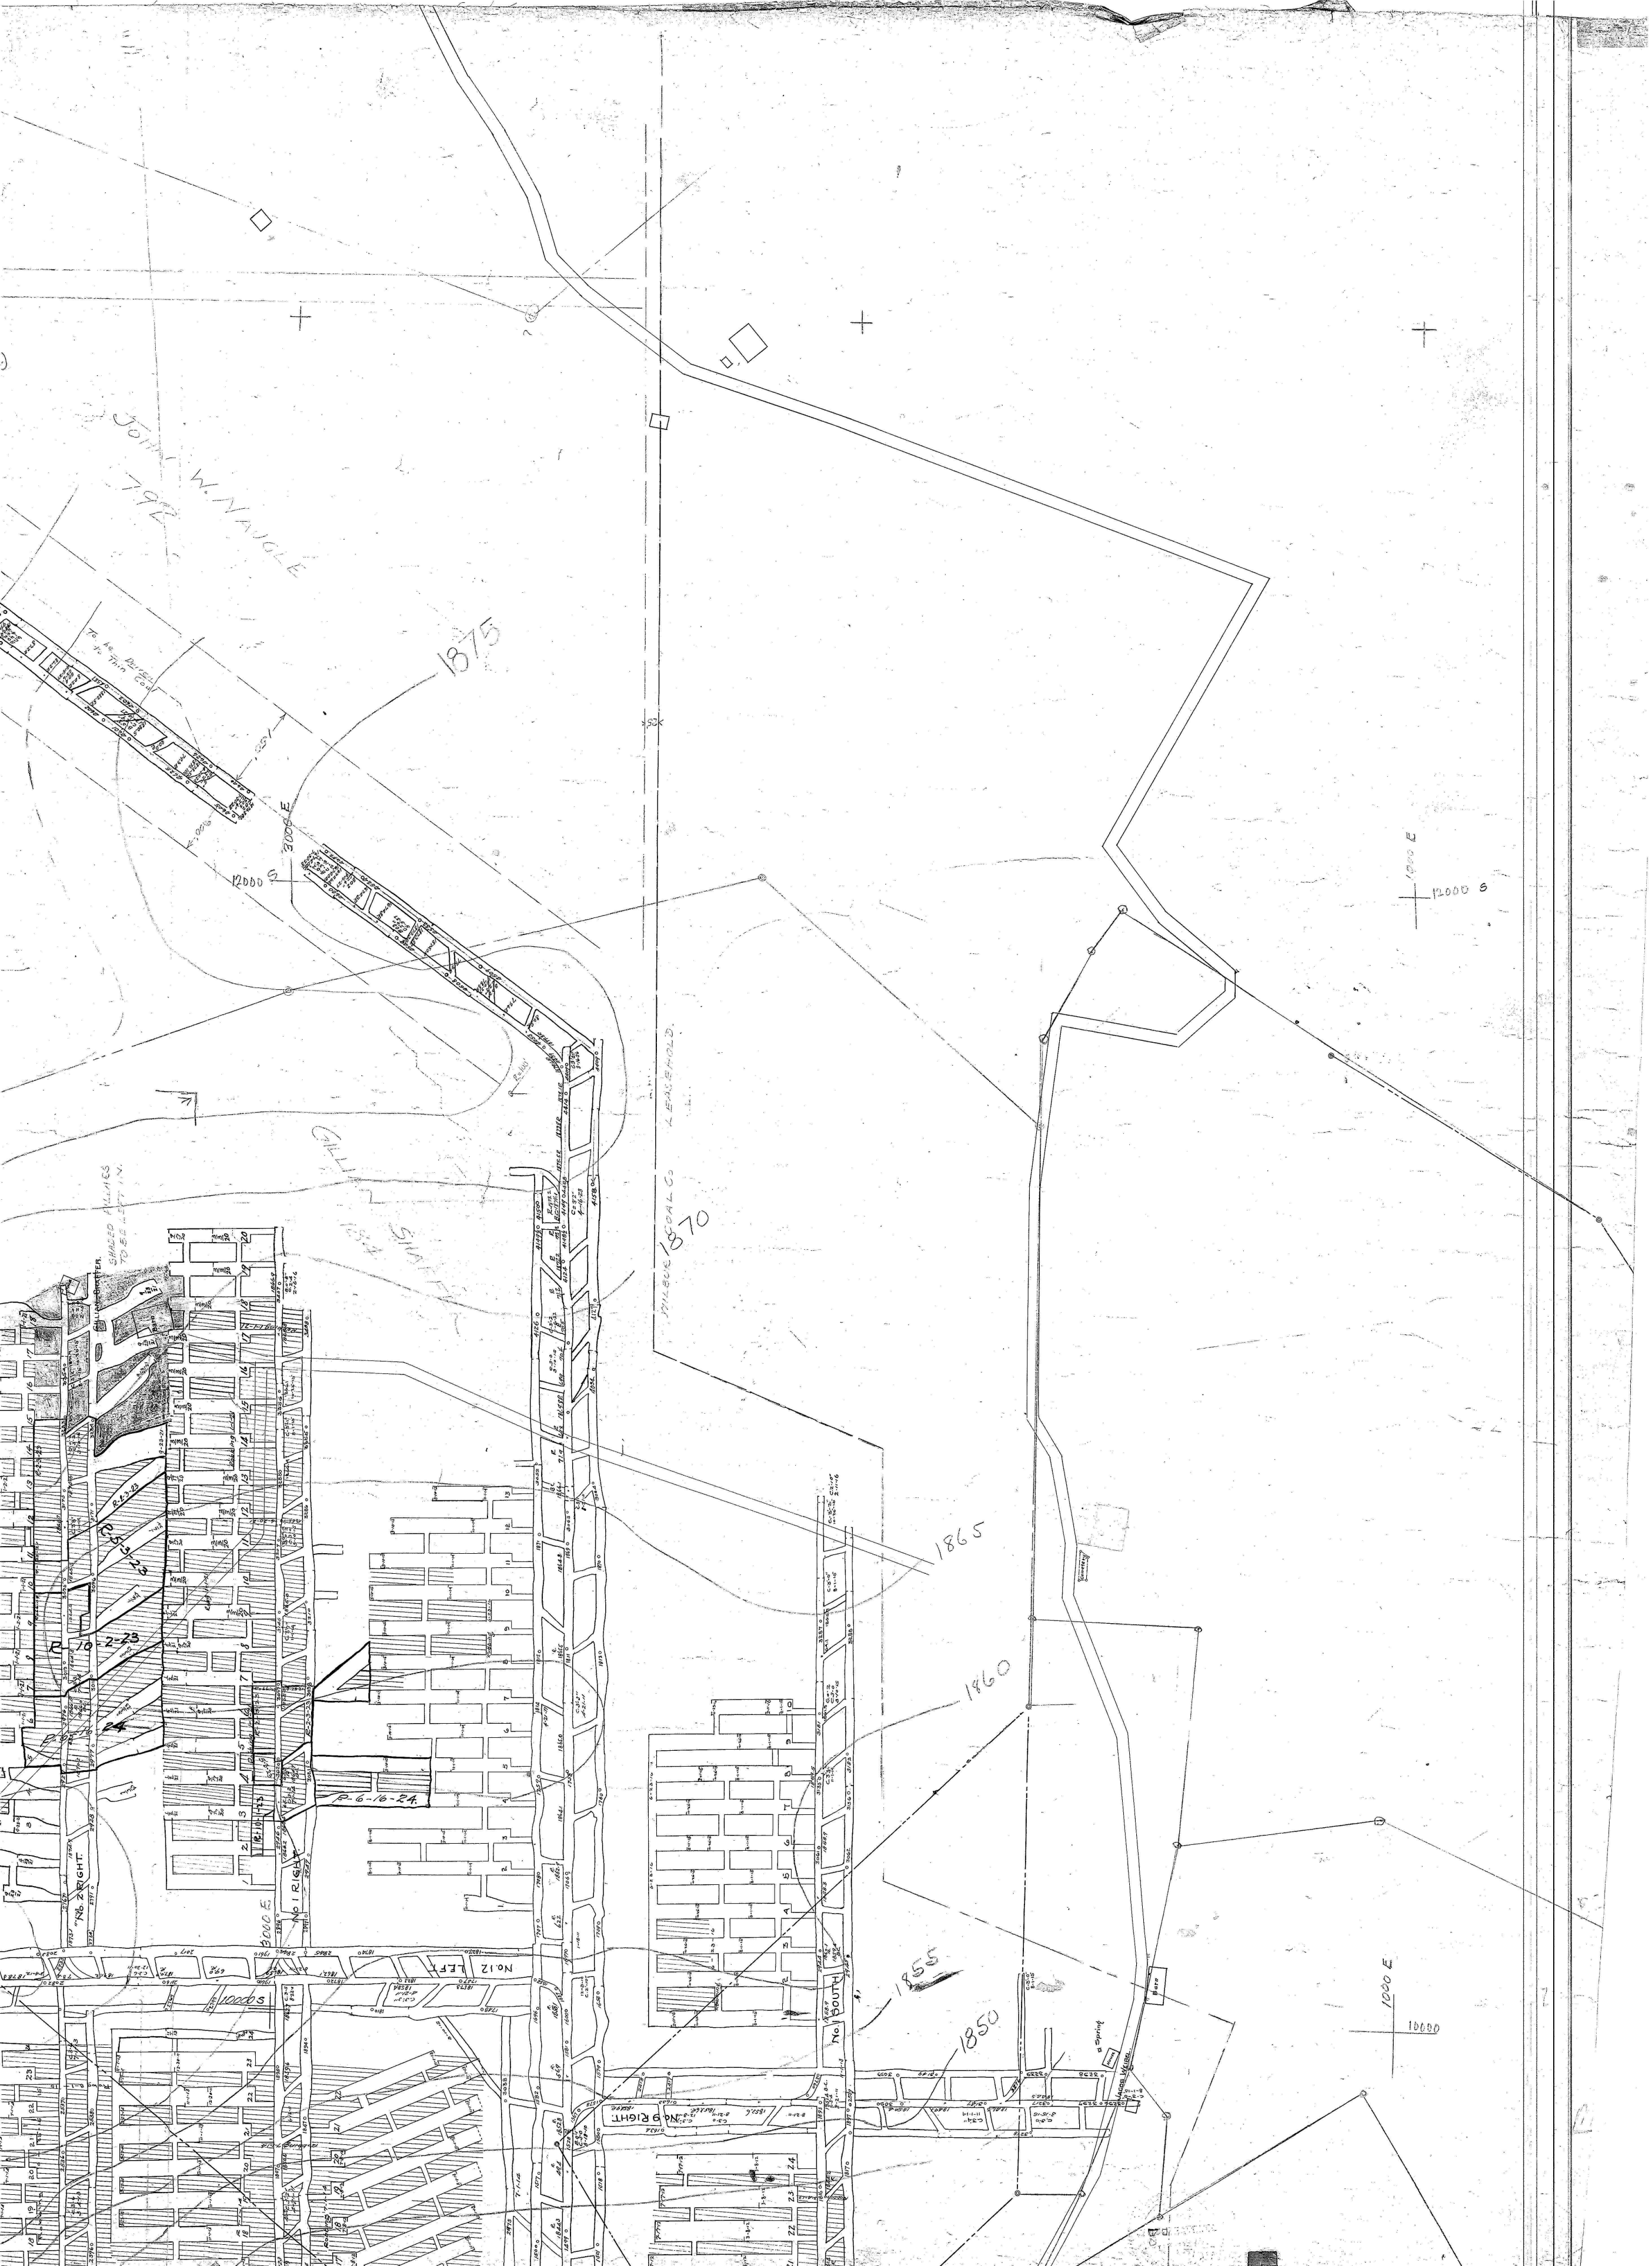

JOHN W. NAUDLE
792

1875

WILSON COAL CO
1870

1865

1860

1855

1850

12000 S

2000 E

10000 S

10000 E

