


MAP
of
CITY COAL CO. OPERATIONS
LATROBE
PENN.
JAN 1900

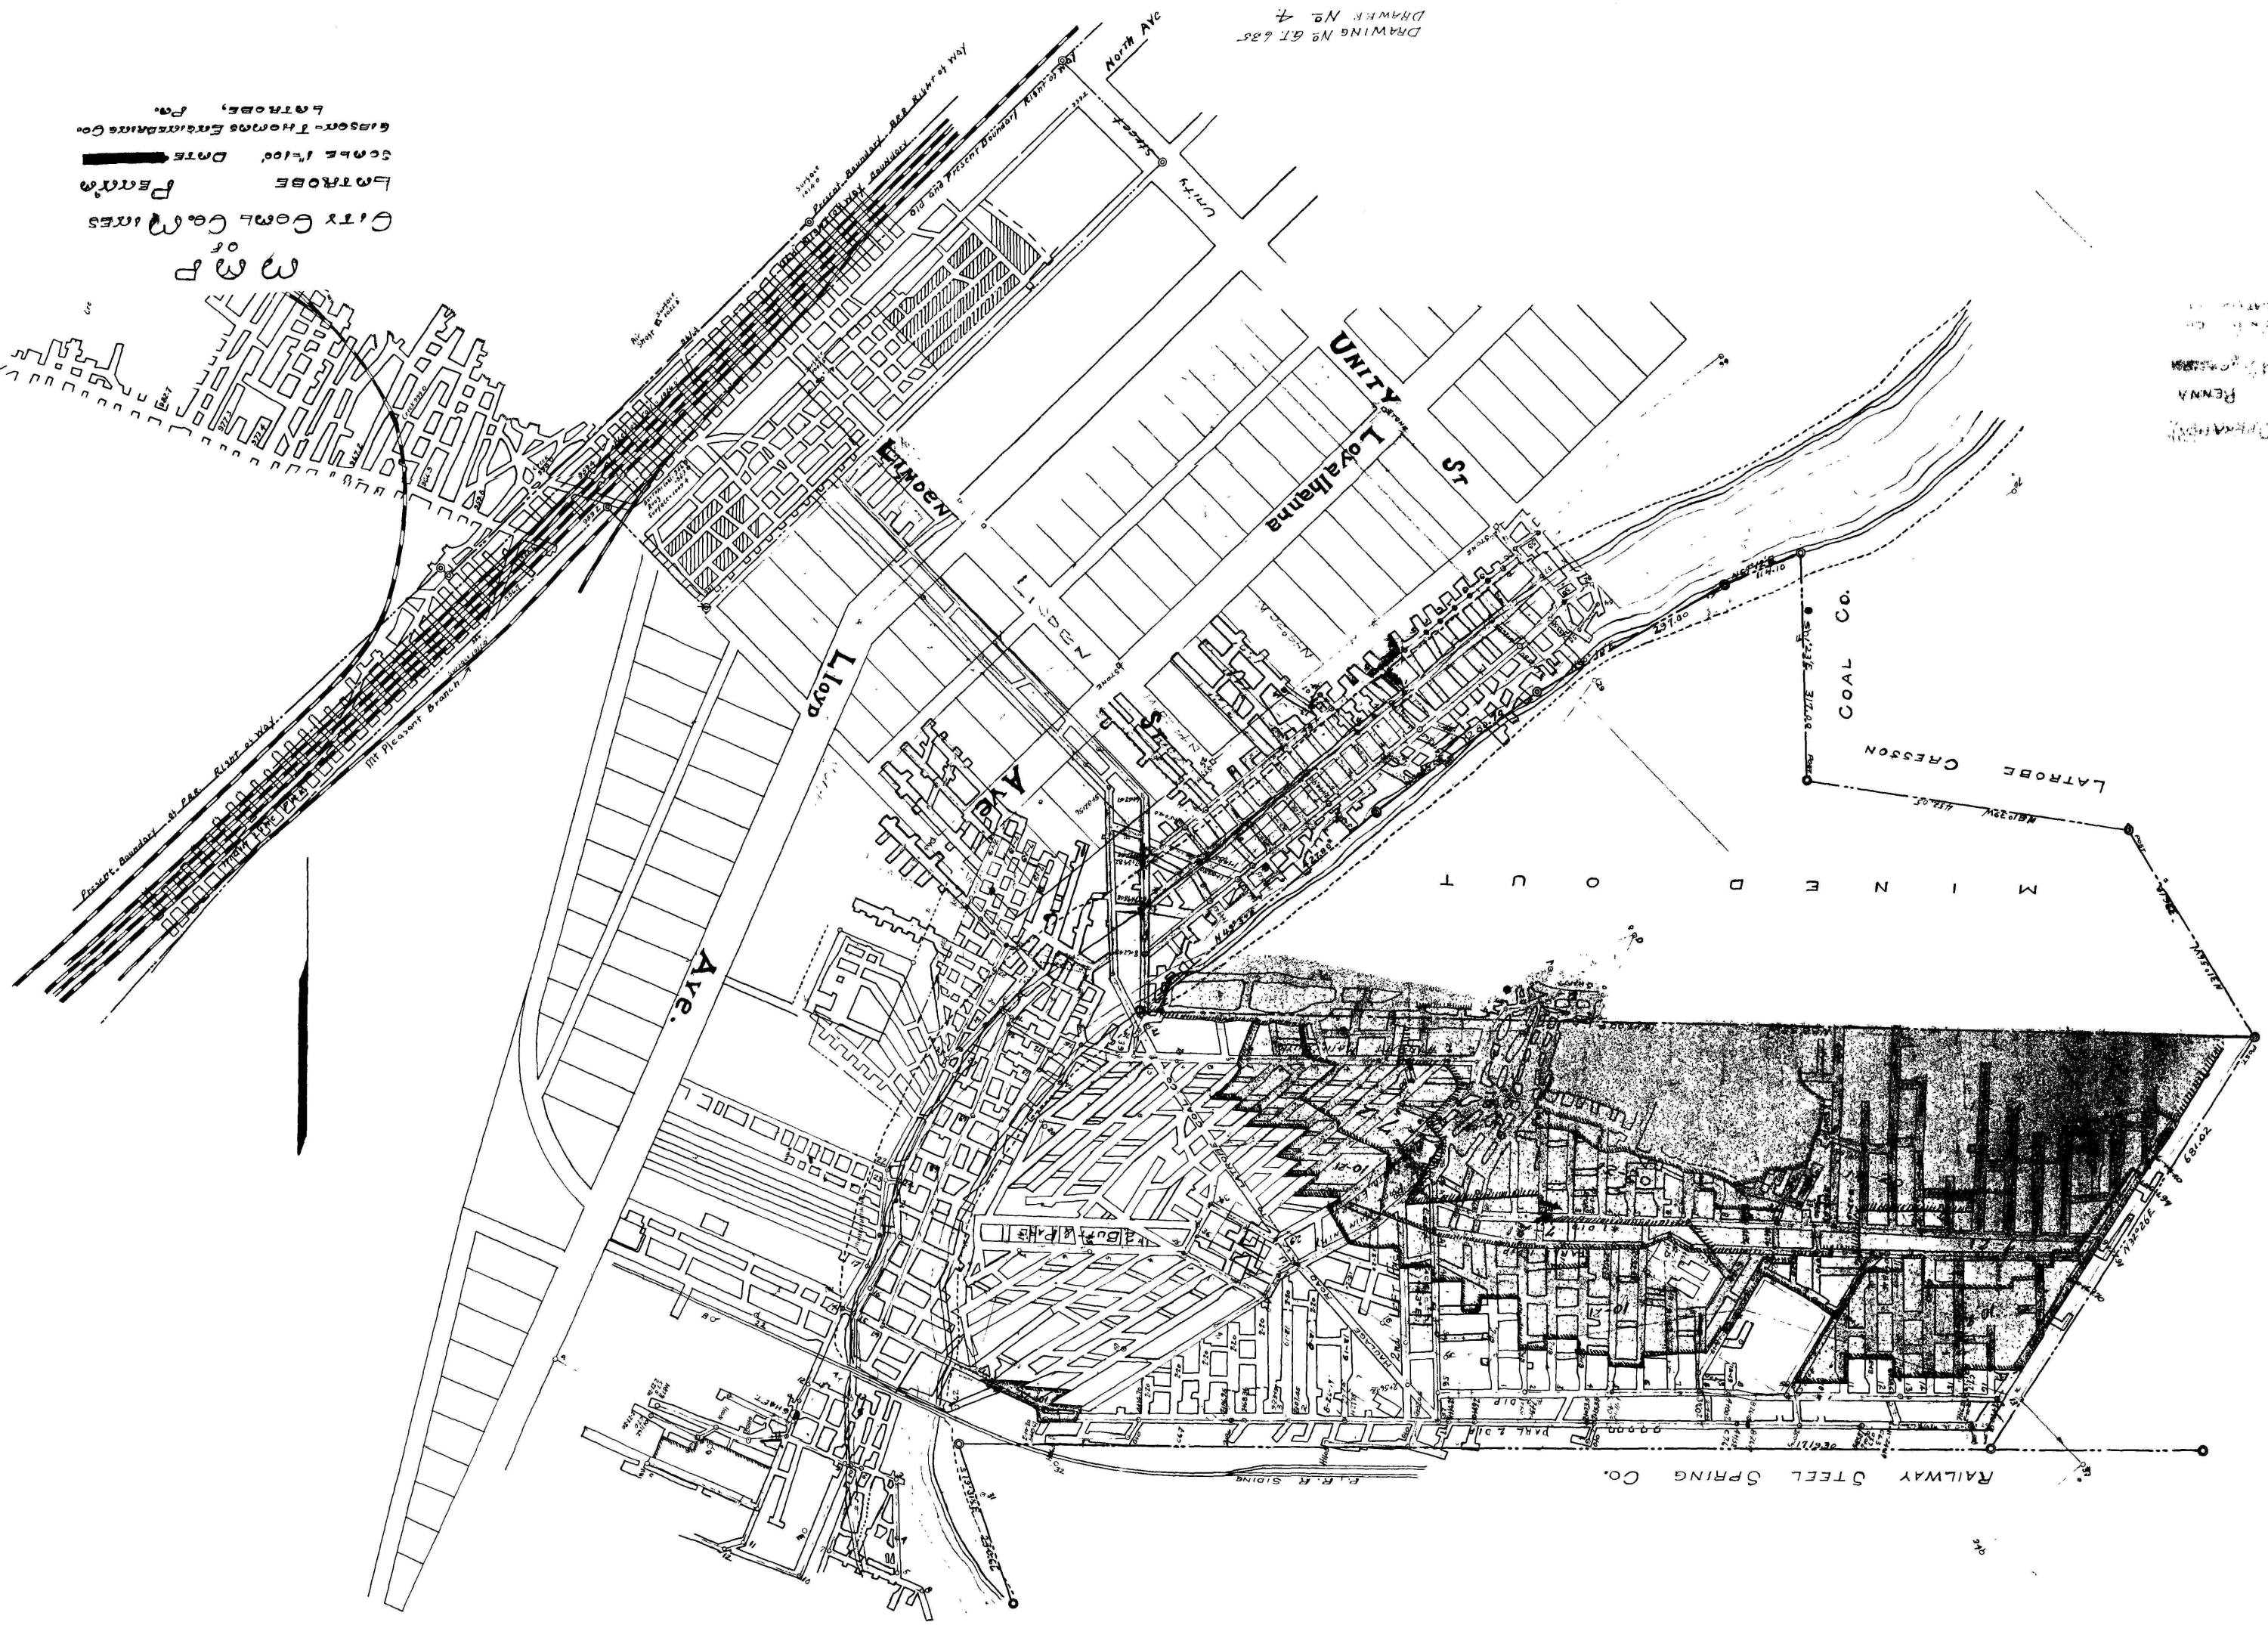


CITY COAL CO. OPERATIONS
LATROBE
PENN.
