




— THE SAXMAN COAL & COKE CO. —
— MINE NO. 2 —

— LINCOLN TWP., SOMERSET CO., PA. —

— SCALE: 1 IN. = 100 FT. —



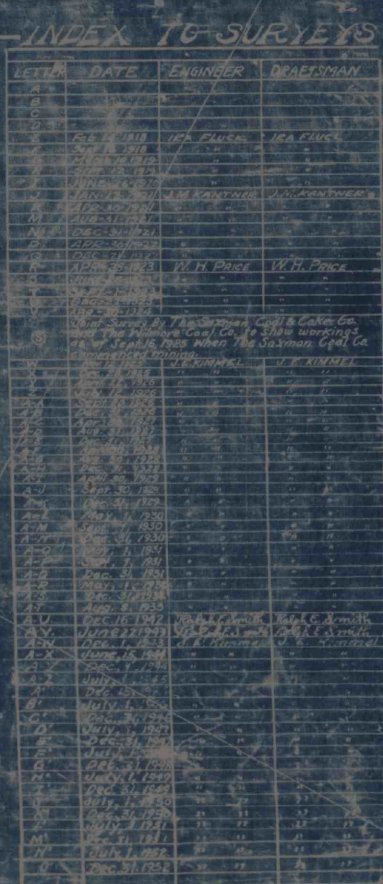

Saxman Coal & Coke Co.
Mine No. 2
Somerset Co., Pa.
1911-1912