


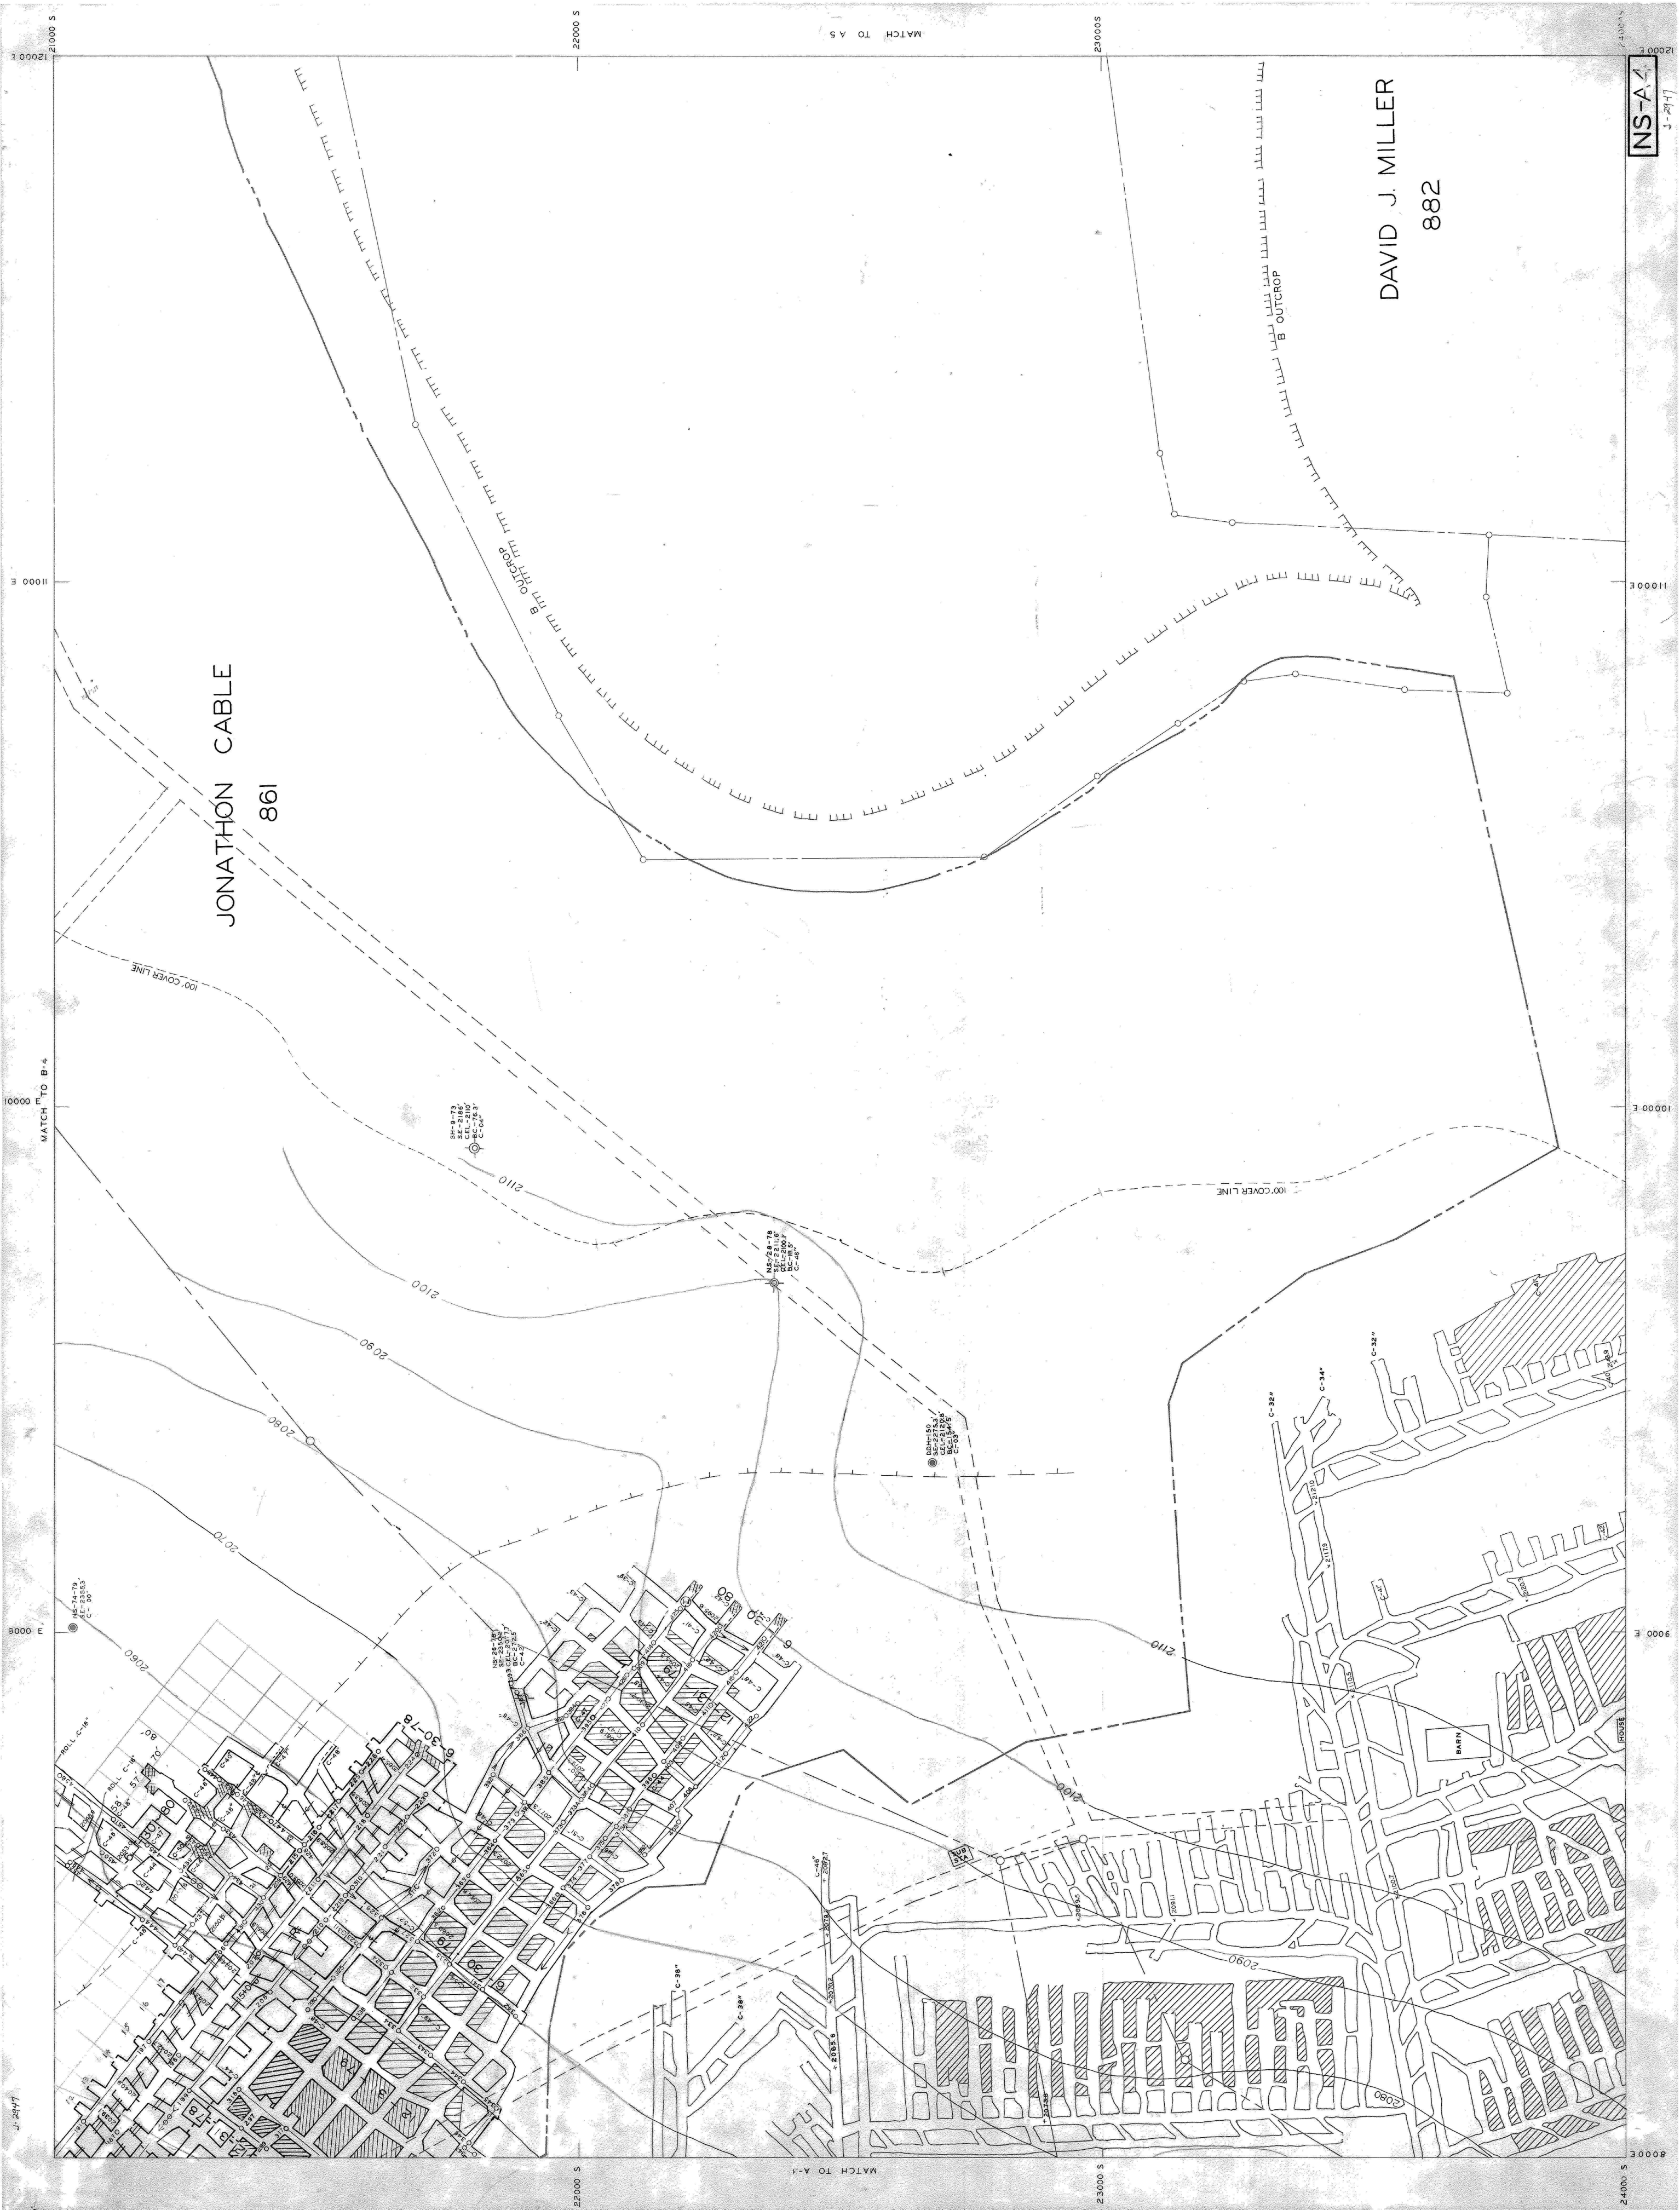

JONATHON CABLE
861

DAVID J. MILLER
882

NS-A-4
J-2447

24000 S
8000 E

MATCH TO A-4

MATCH TO A-5