


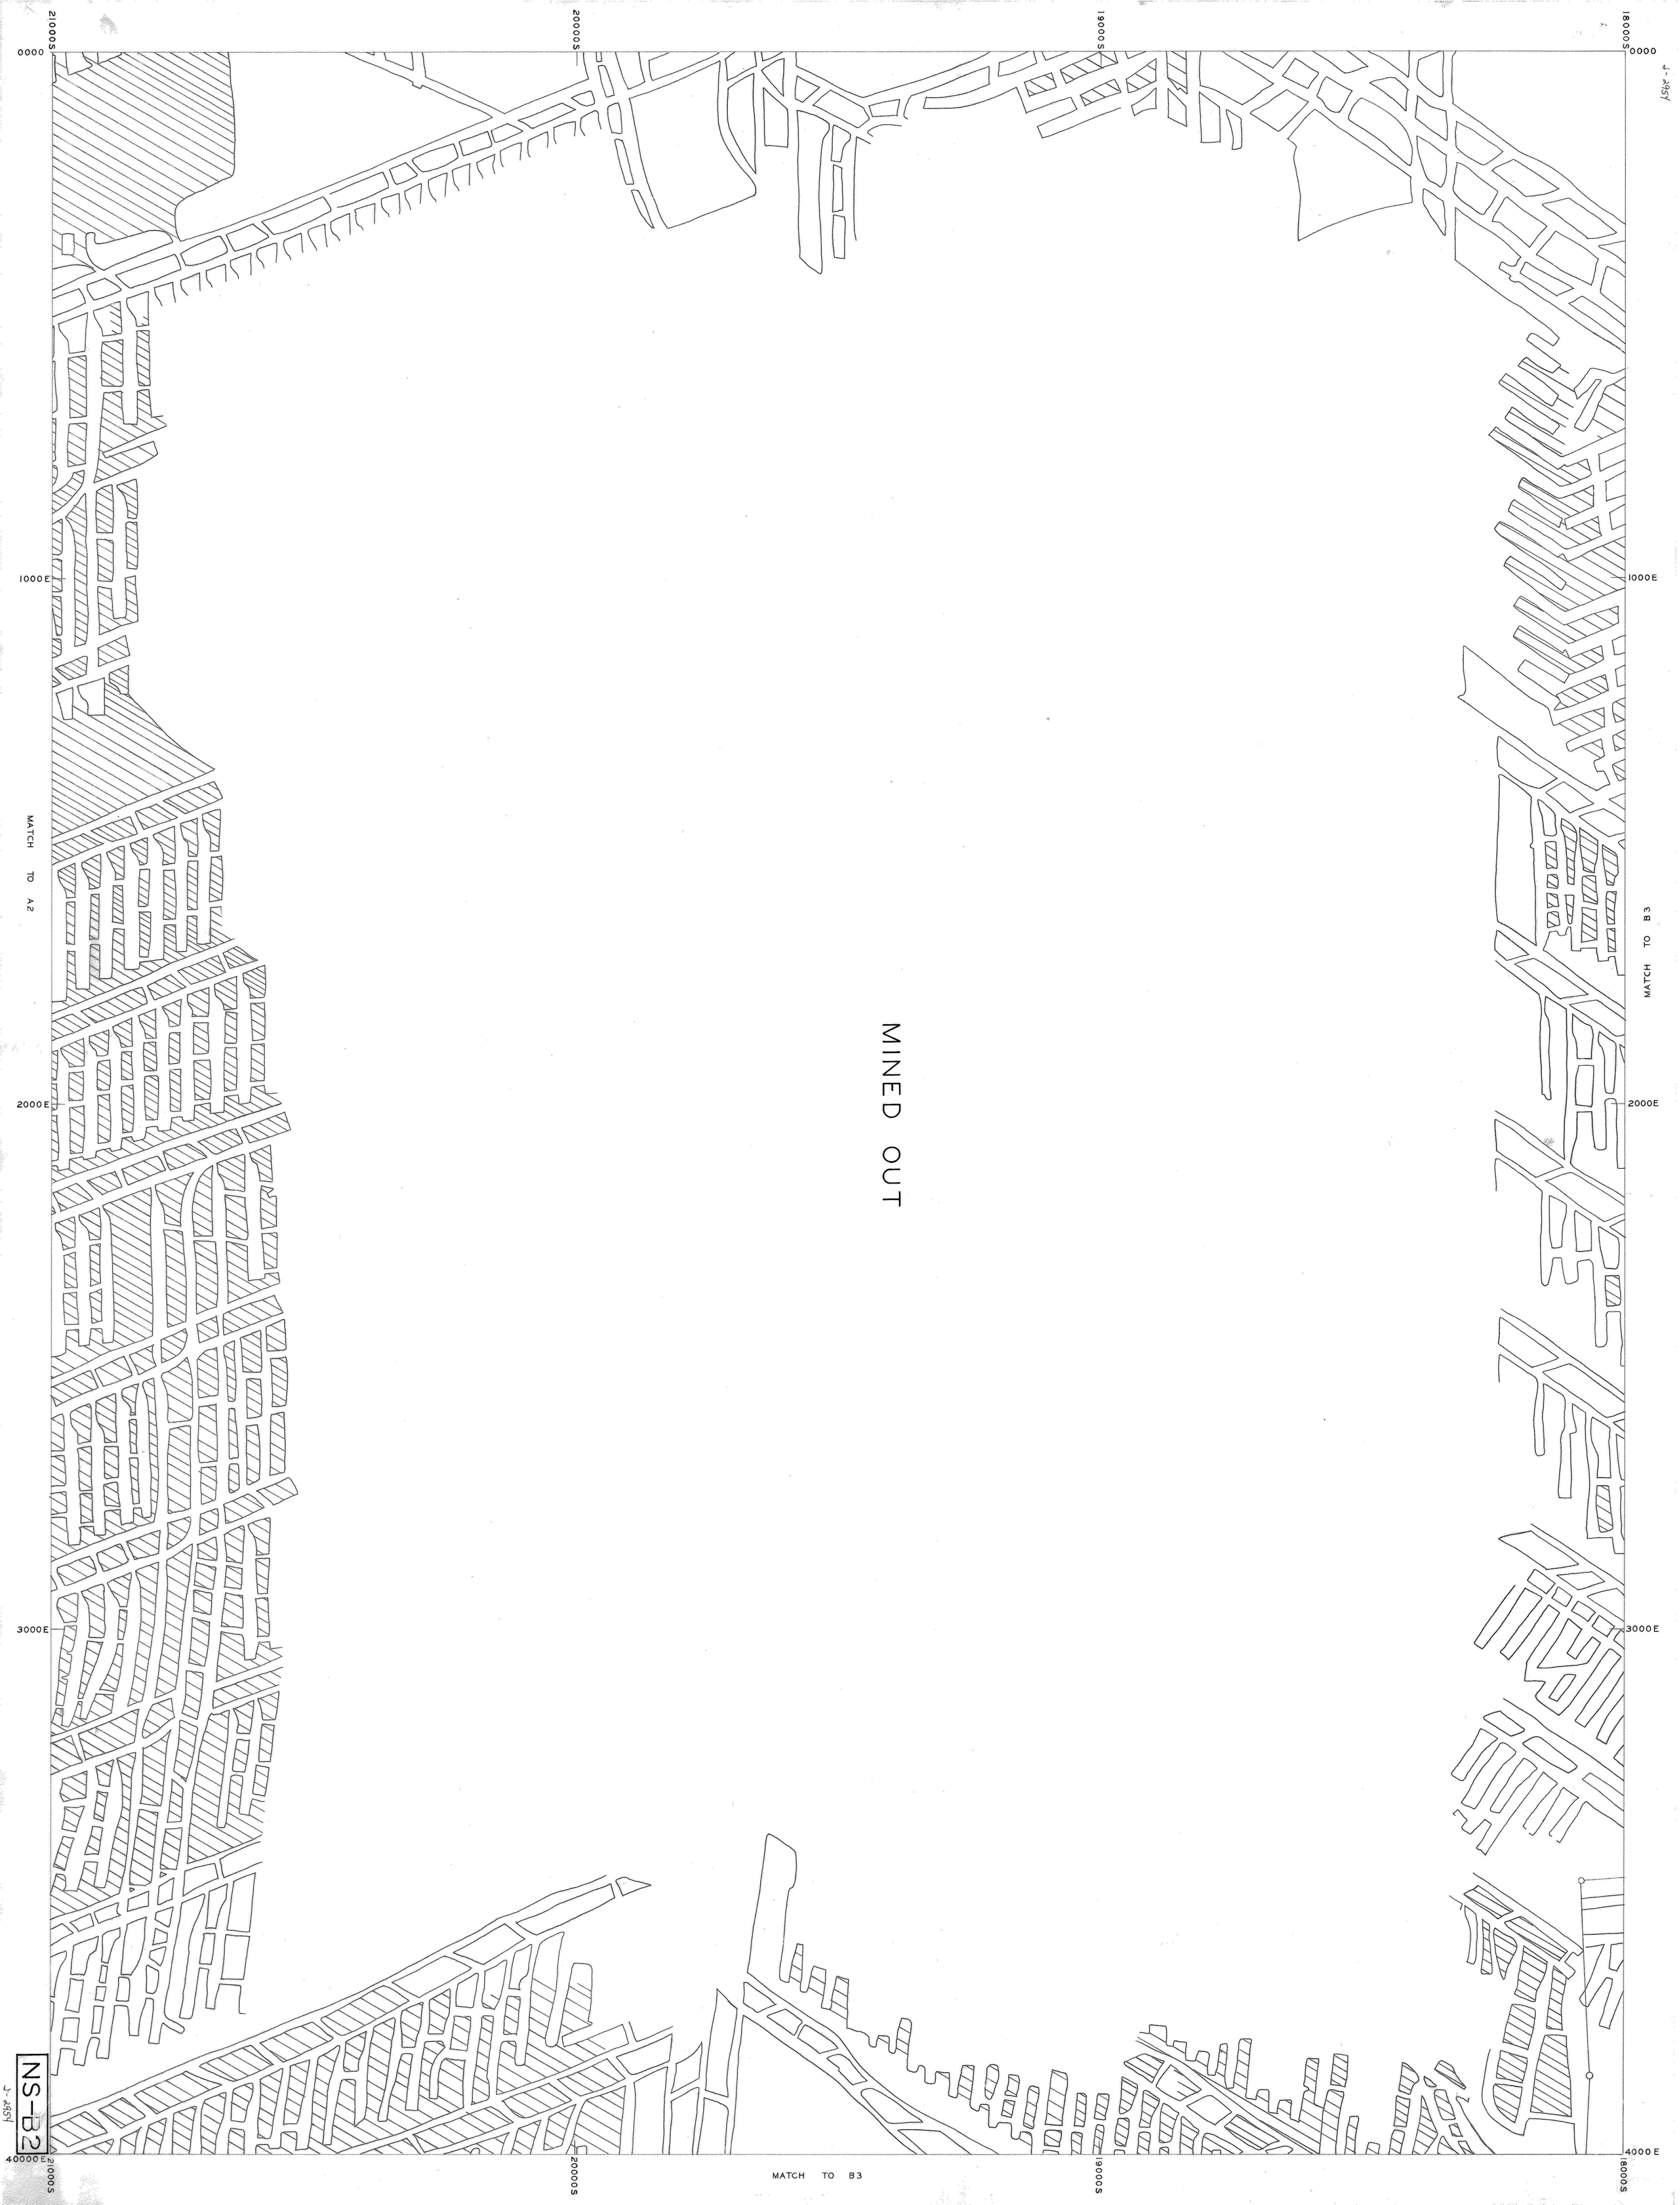

MINED OUT

NS-B2

J-2854

MATCH TO B3

MATCH TO B3

MATCH TO A2