


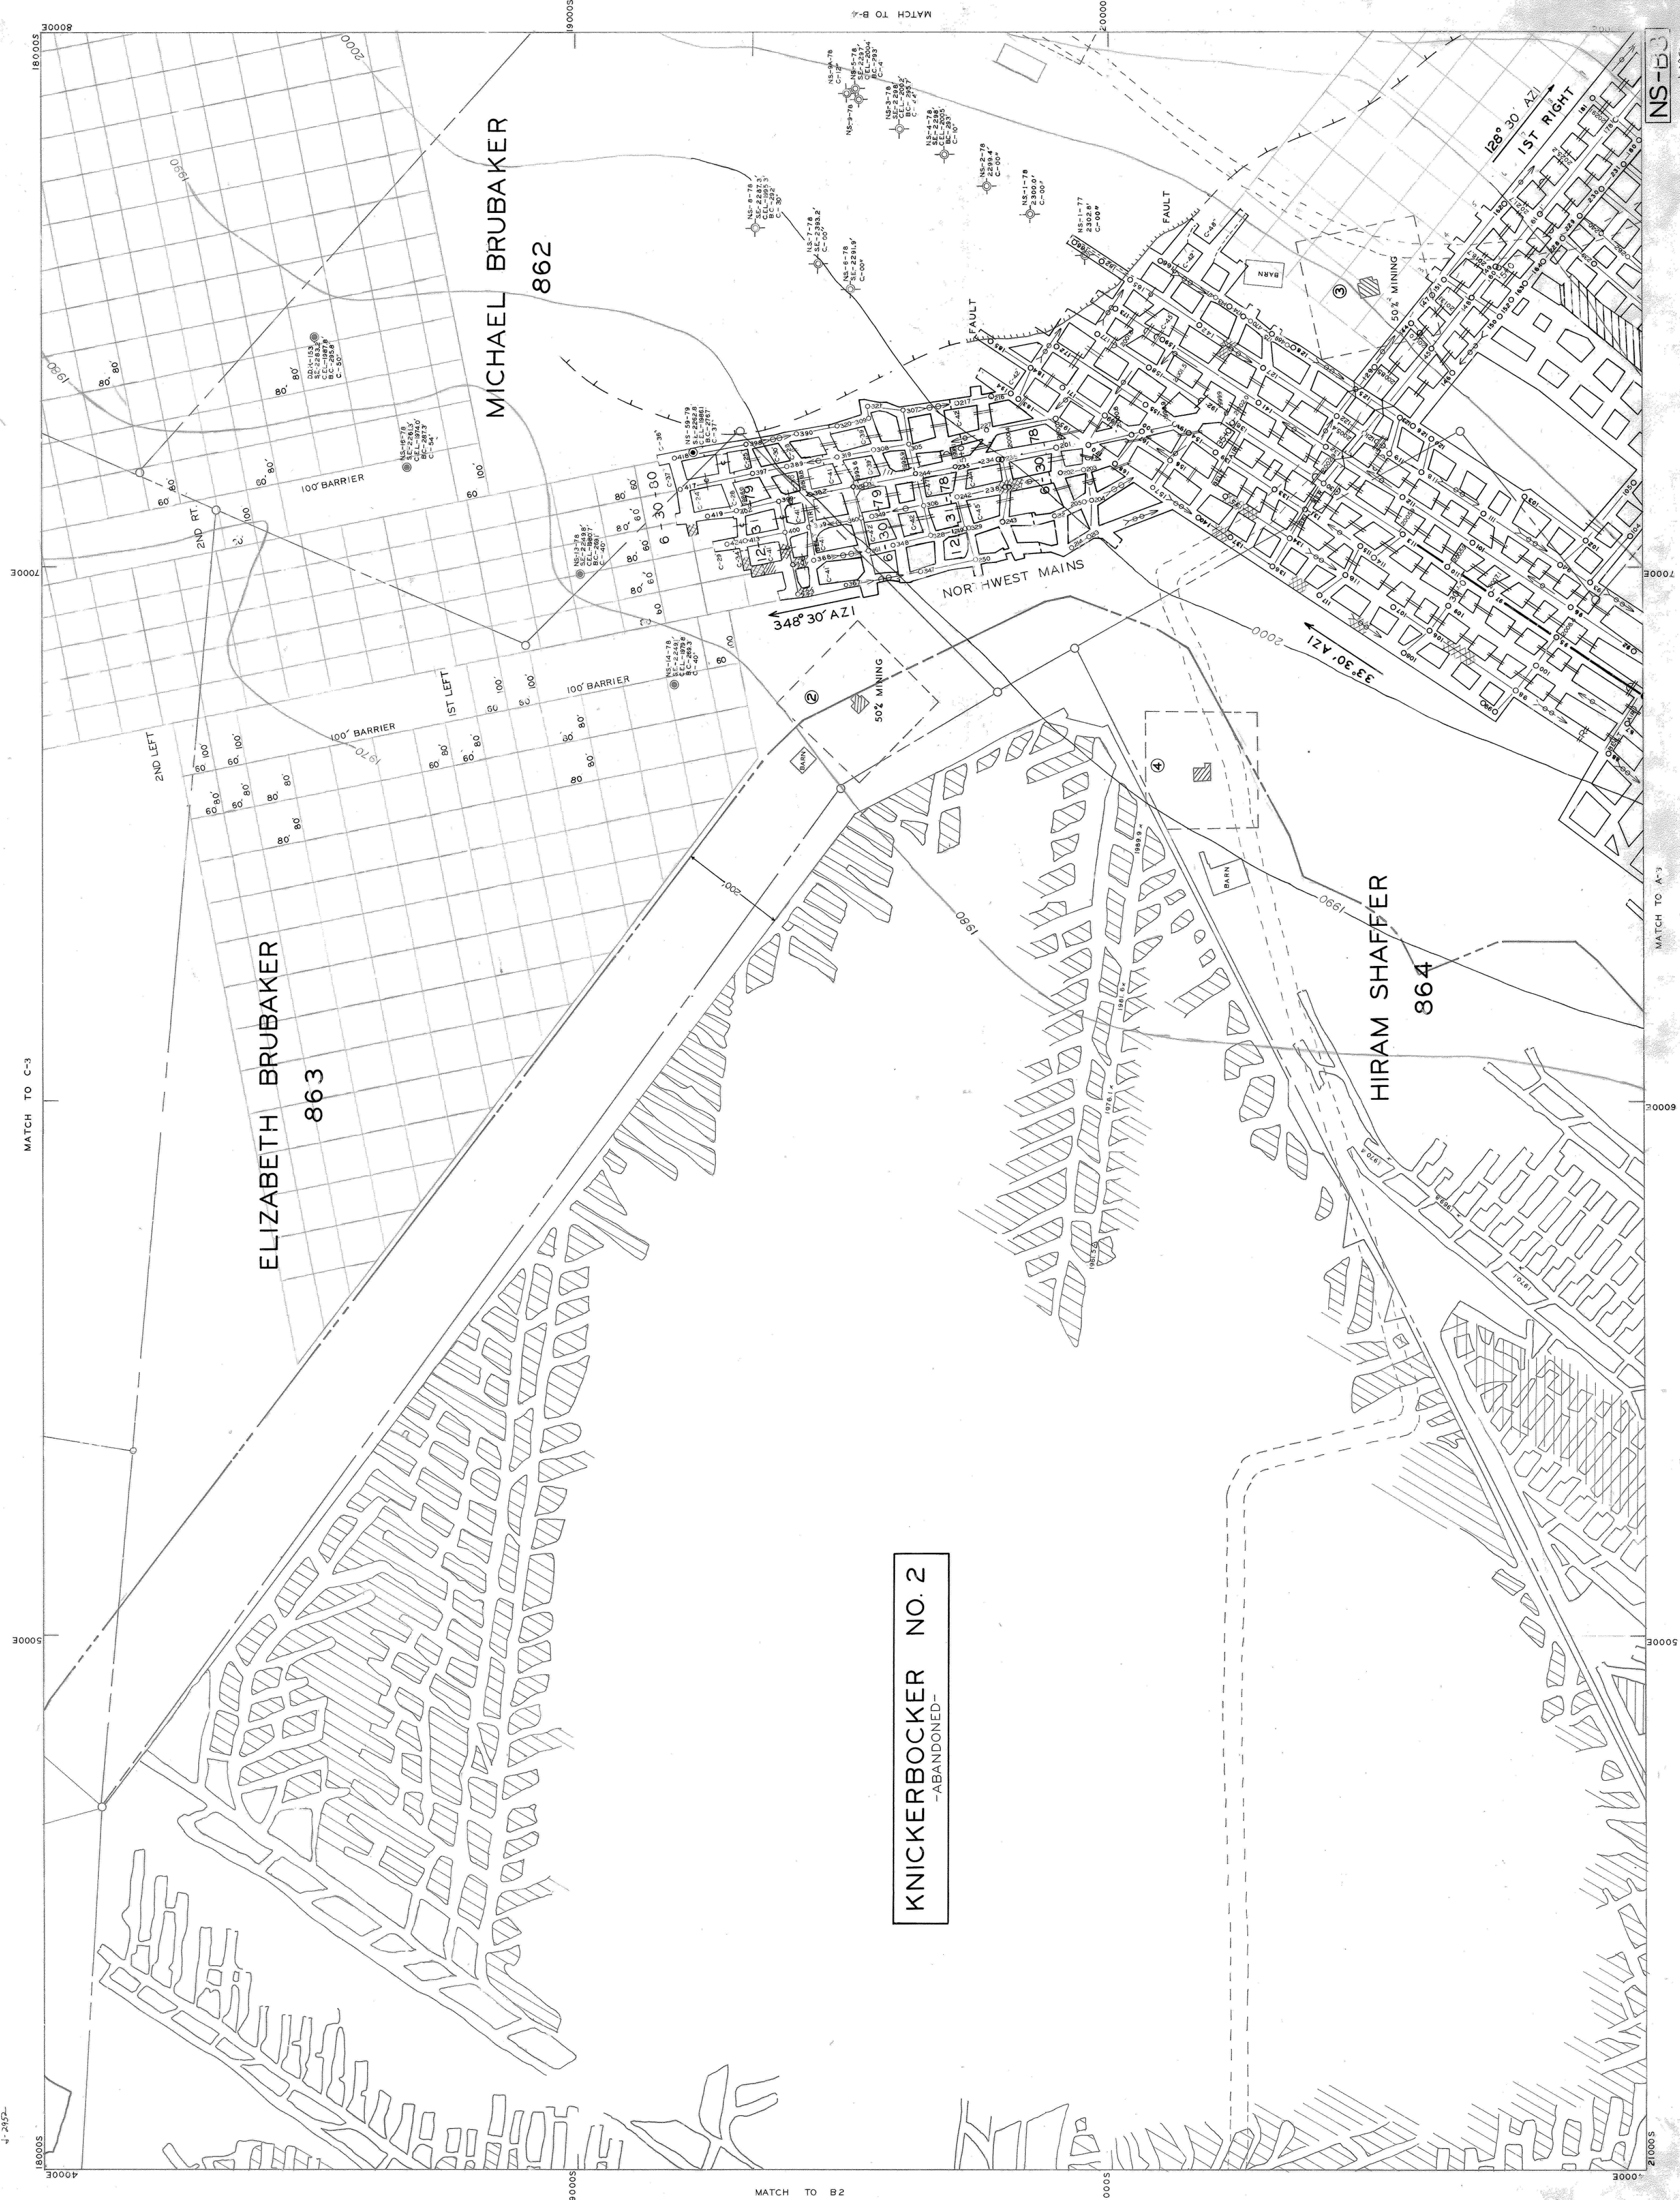

KNICKERBOCKER NO. 2
-ABANDONED-

ELIZABETH BRUBAKER
863

MICHAEL BRUBAKER
862

HIRAM SHAFFER
864