


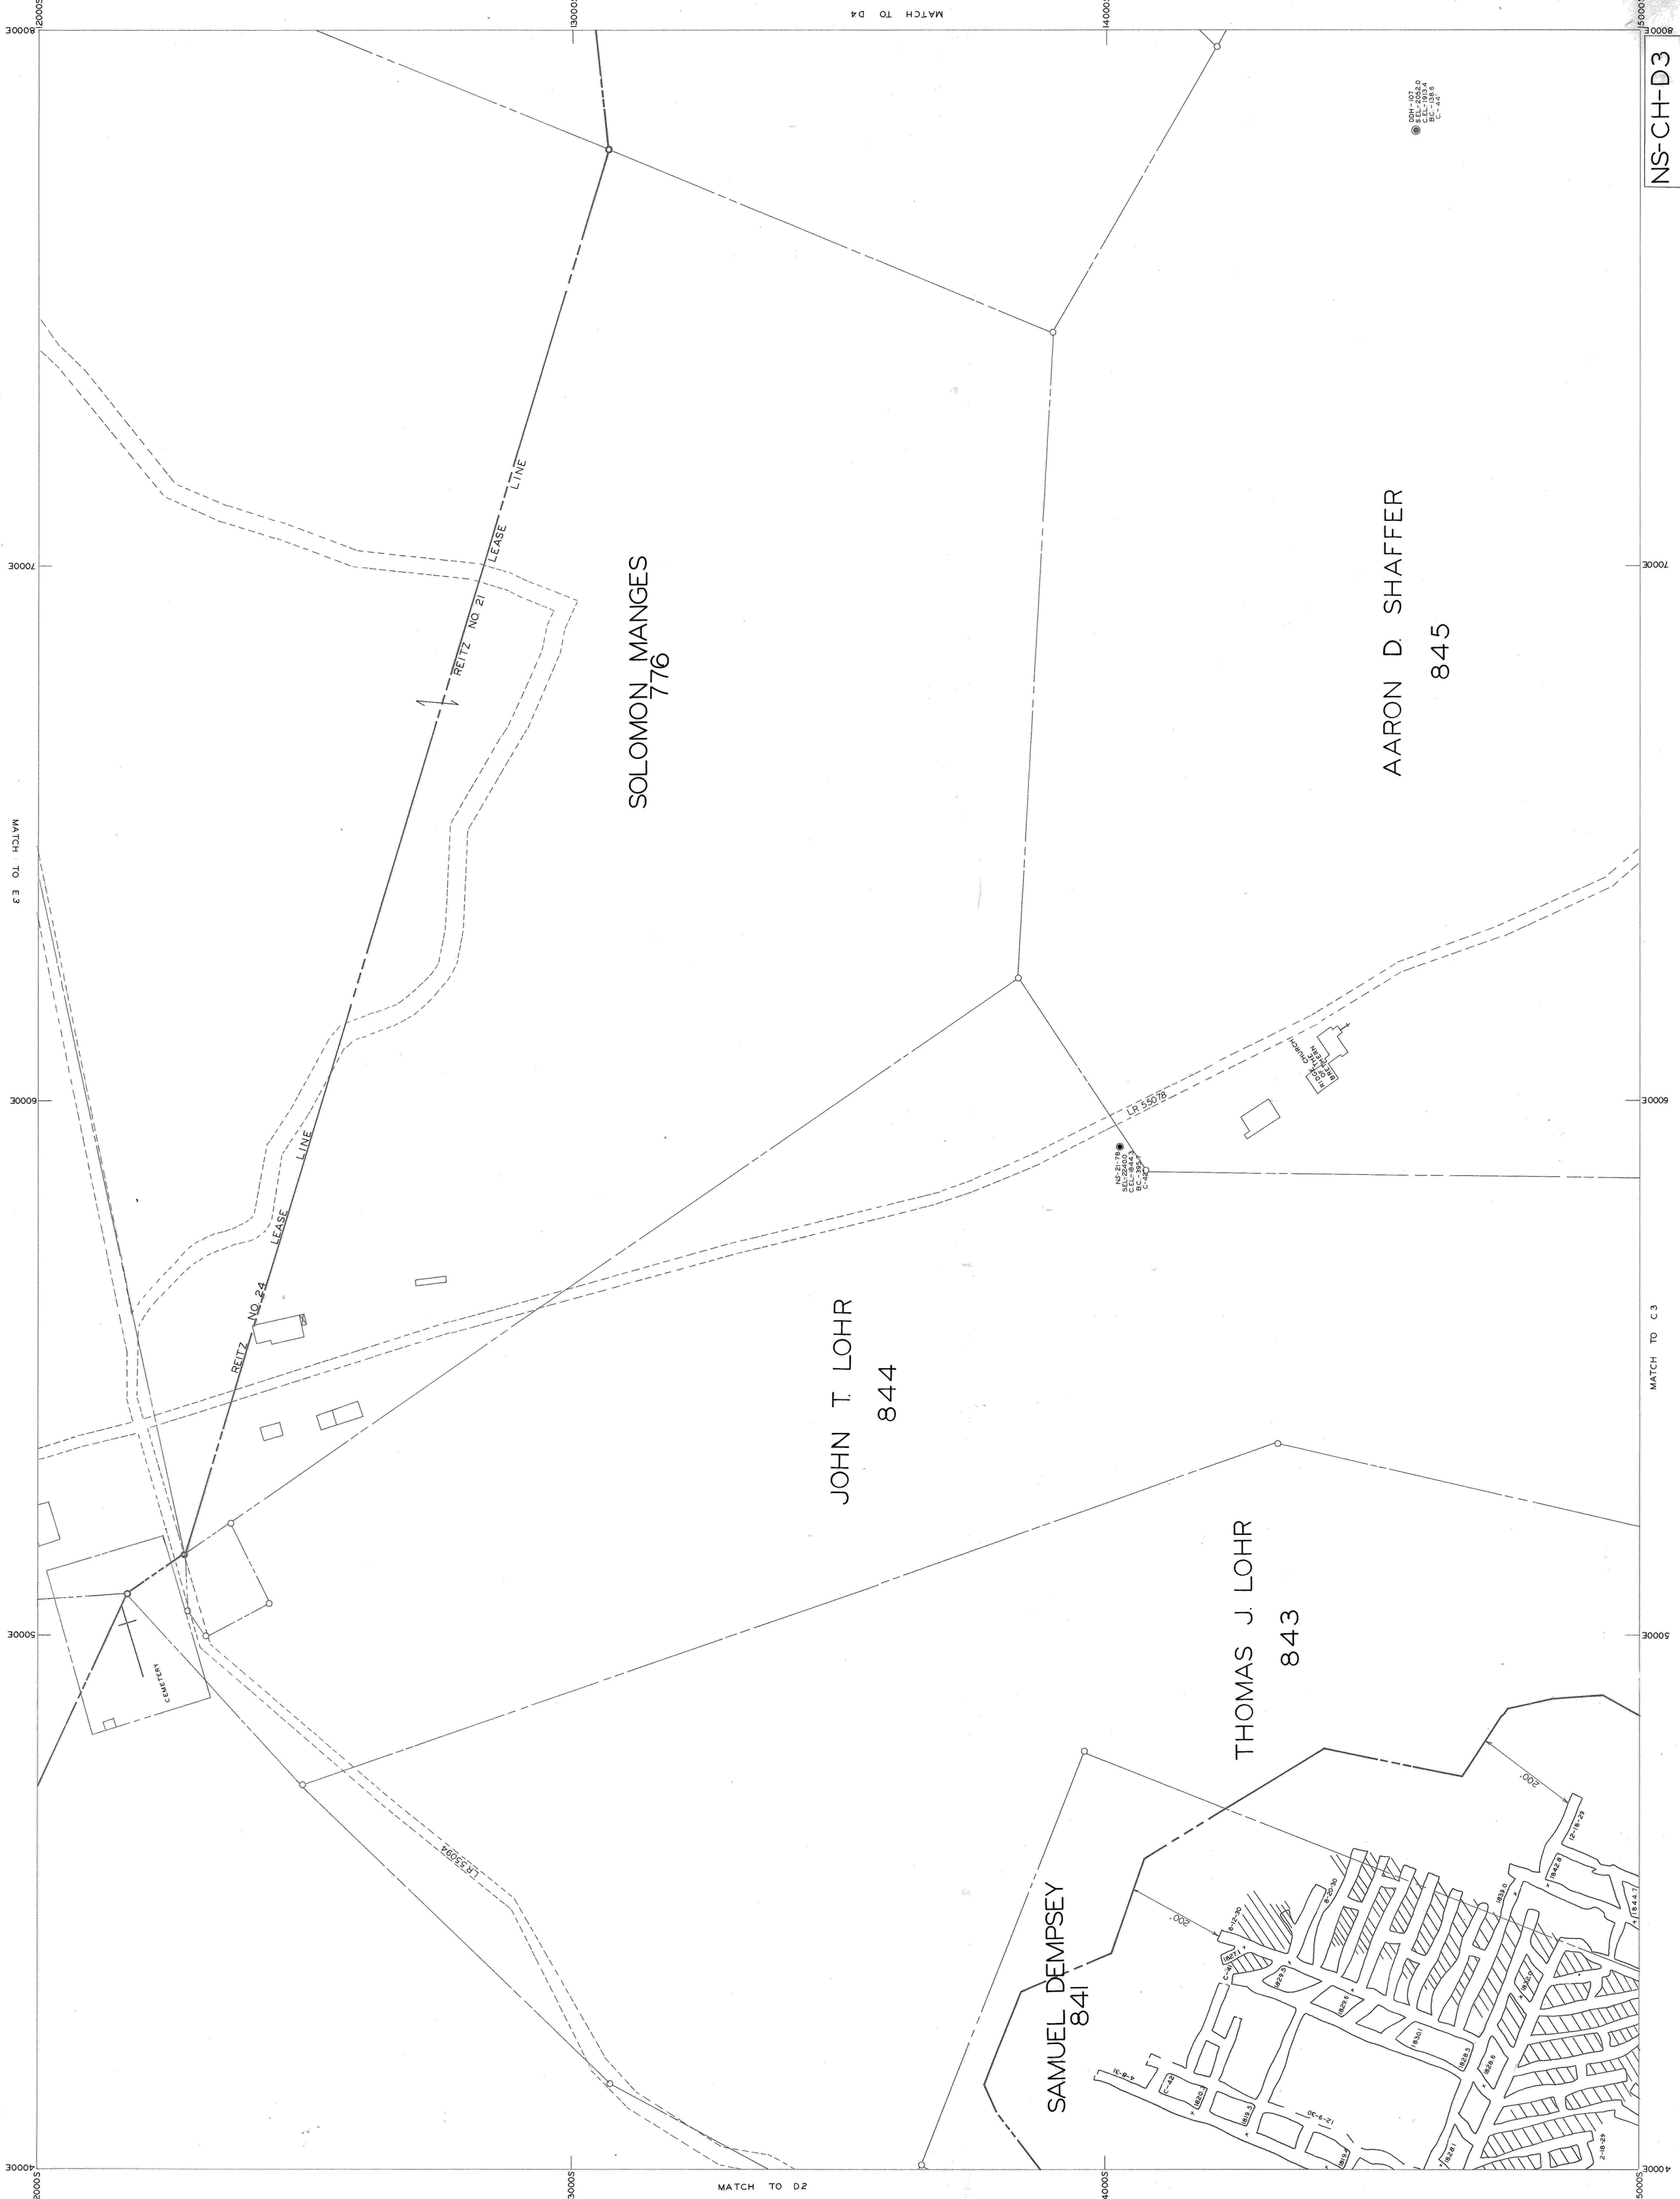

12000S 13000S 14000S 15000S
8000E 7000E 6000E 5000E 4000E
MATCH TO E3
MATCH TO D2

SOLOMON MANGES
776

JOHN T. LOHR
844

AARON D. SHAFFER
845

THOMAS J. LOHR
843

SAMUEL DEMPSEY
841

NS-CH-D3
1-2-27