


16-20781

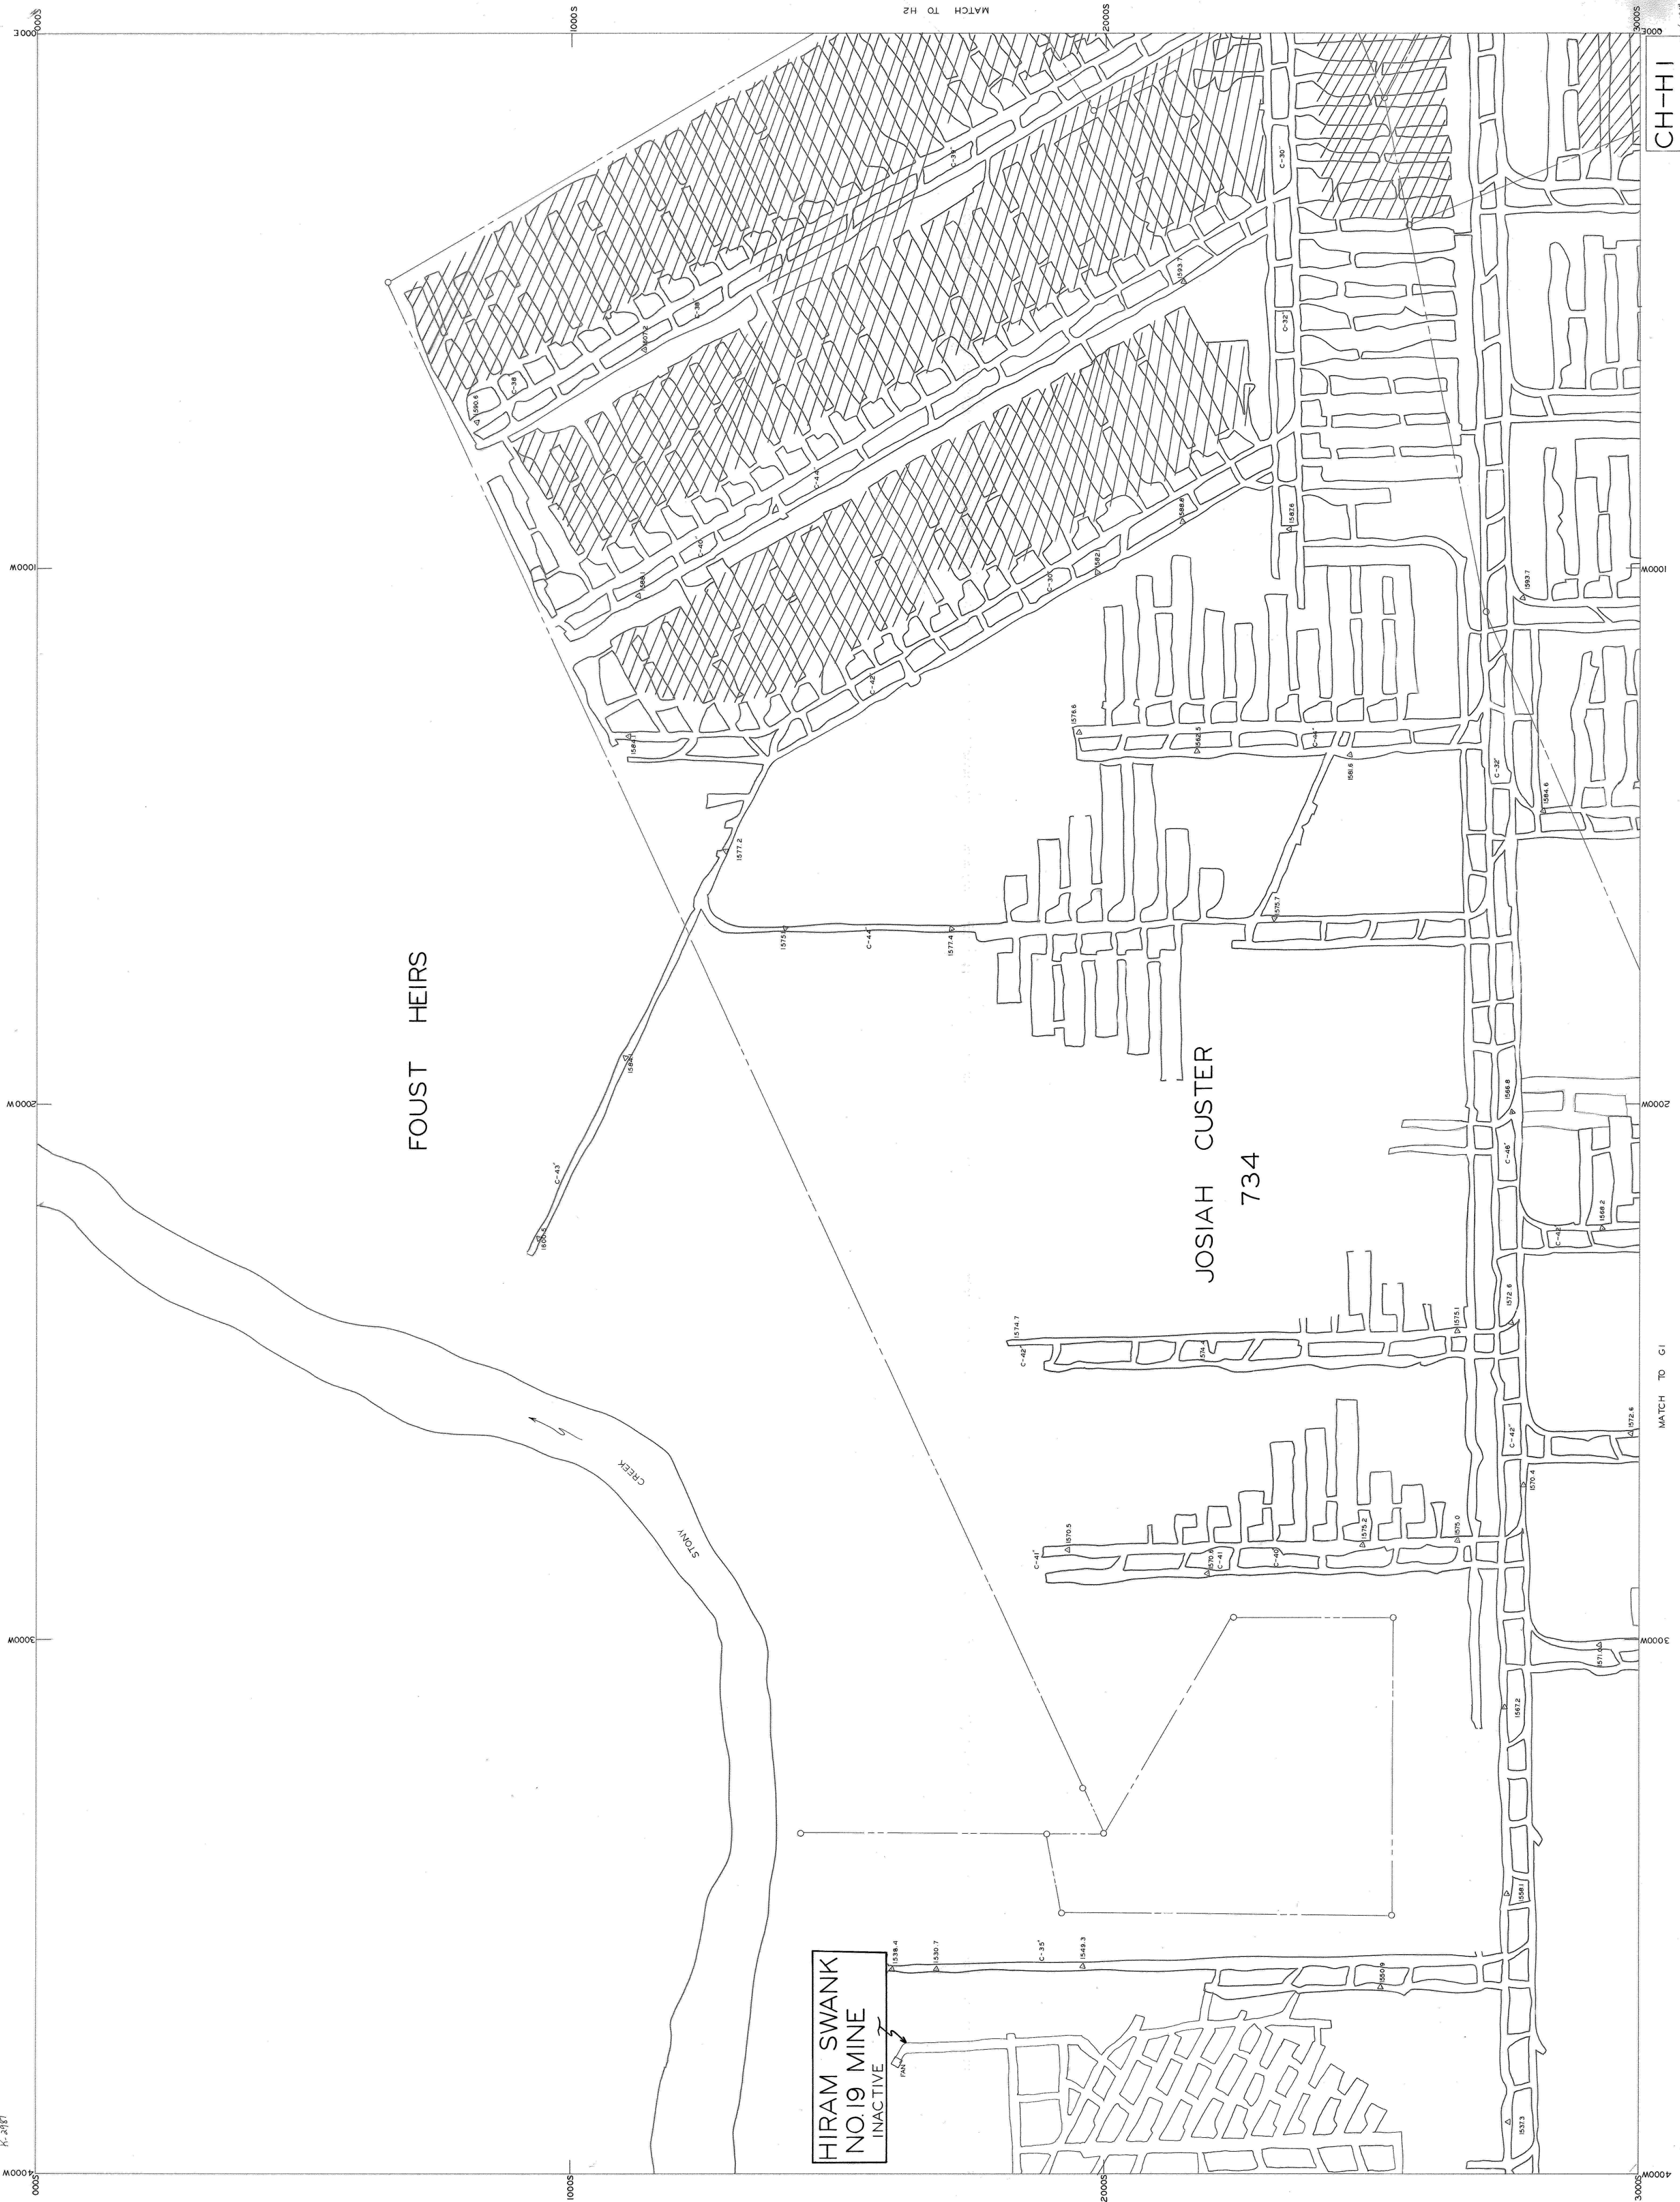

CH-HI

MATCH TO G1














