


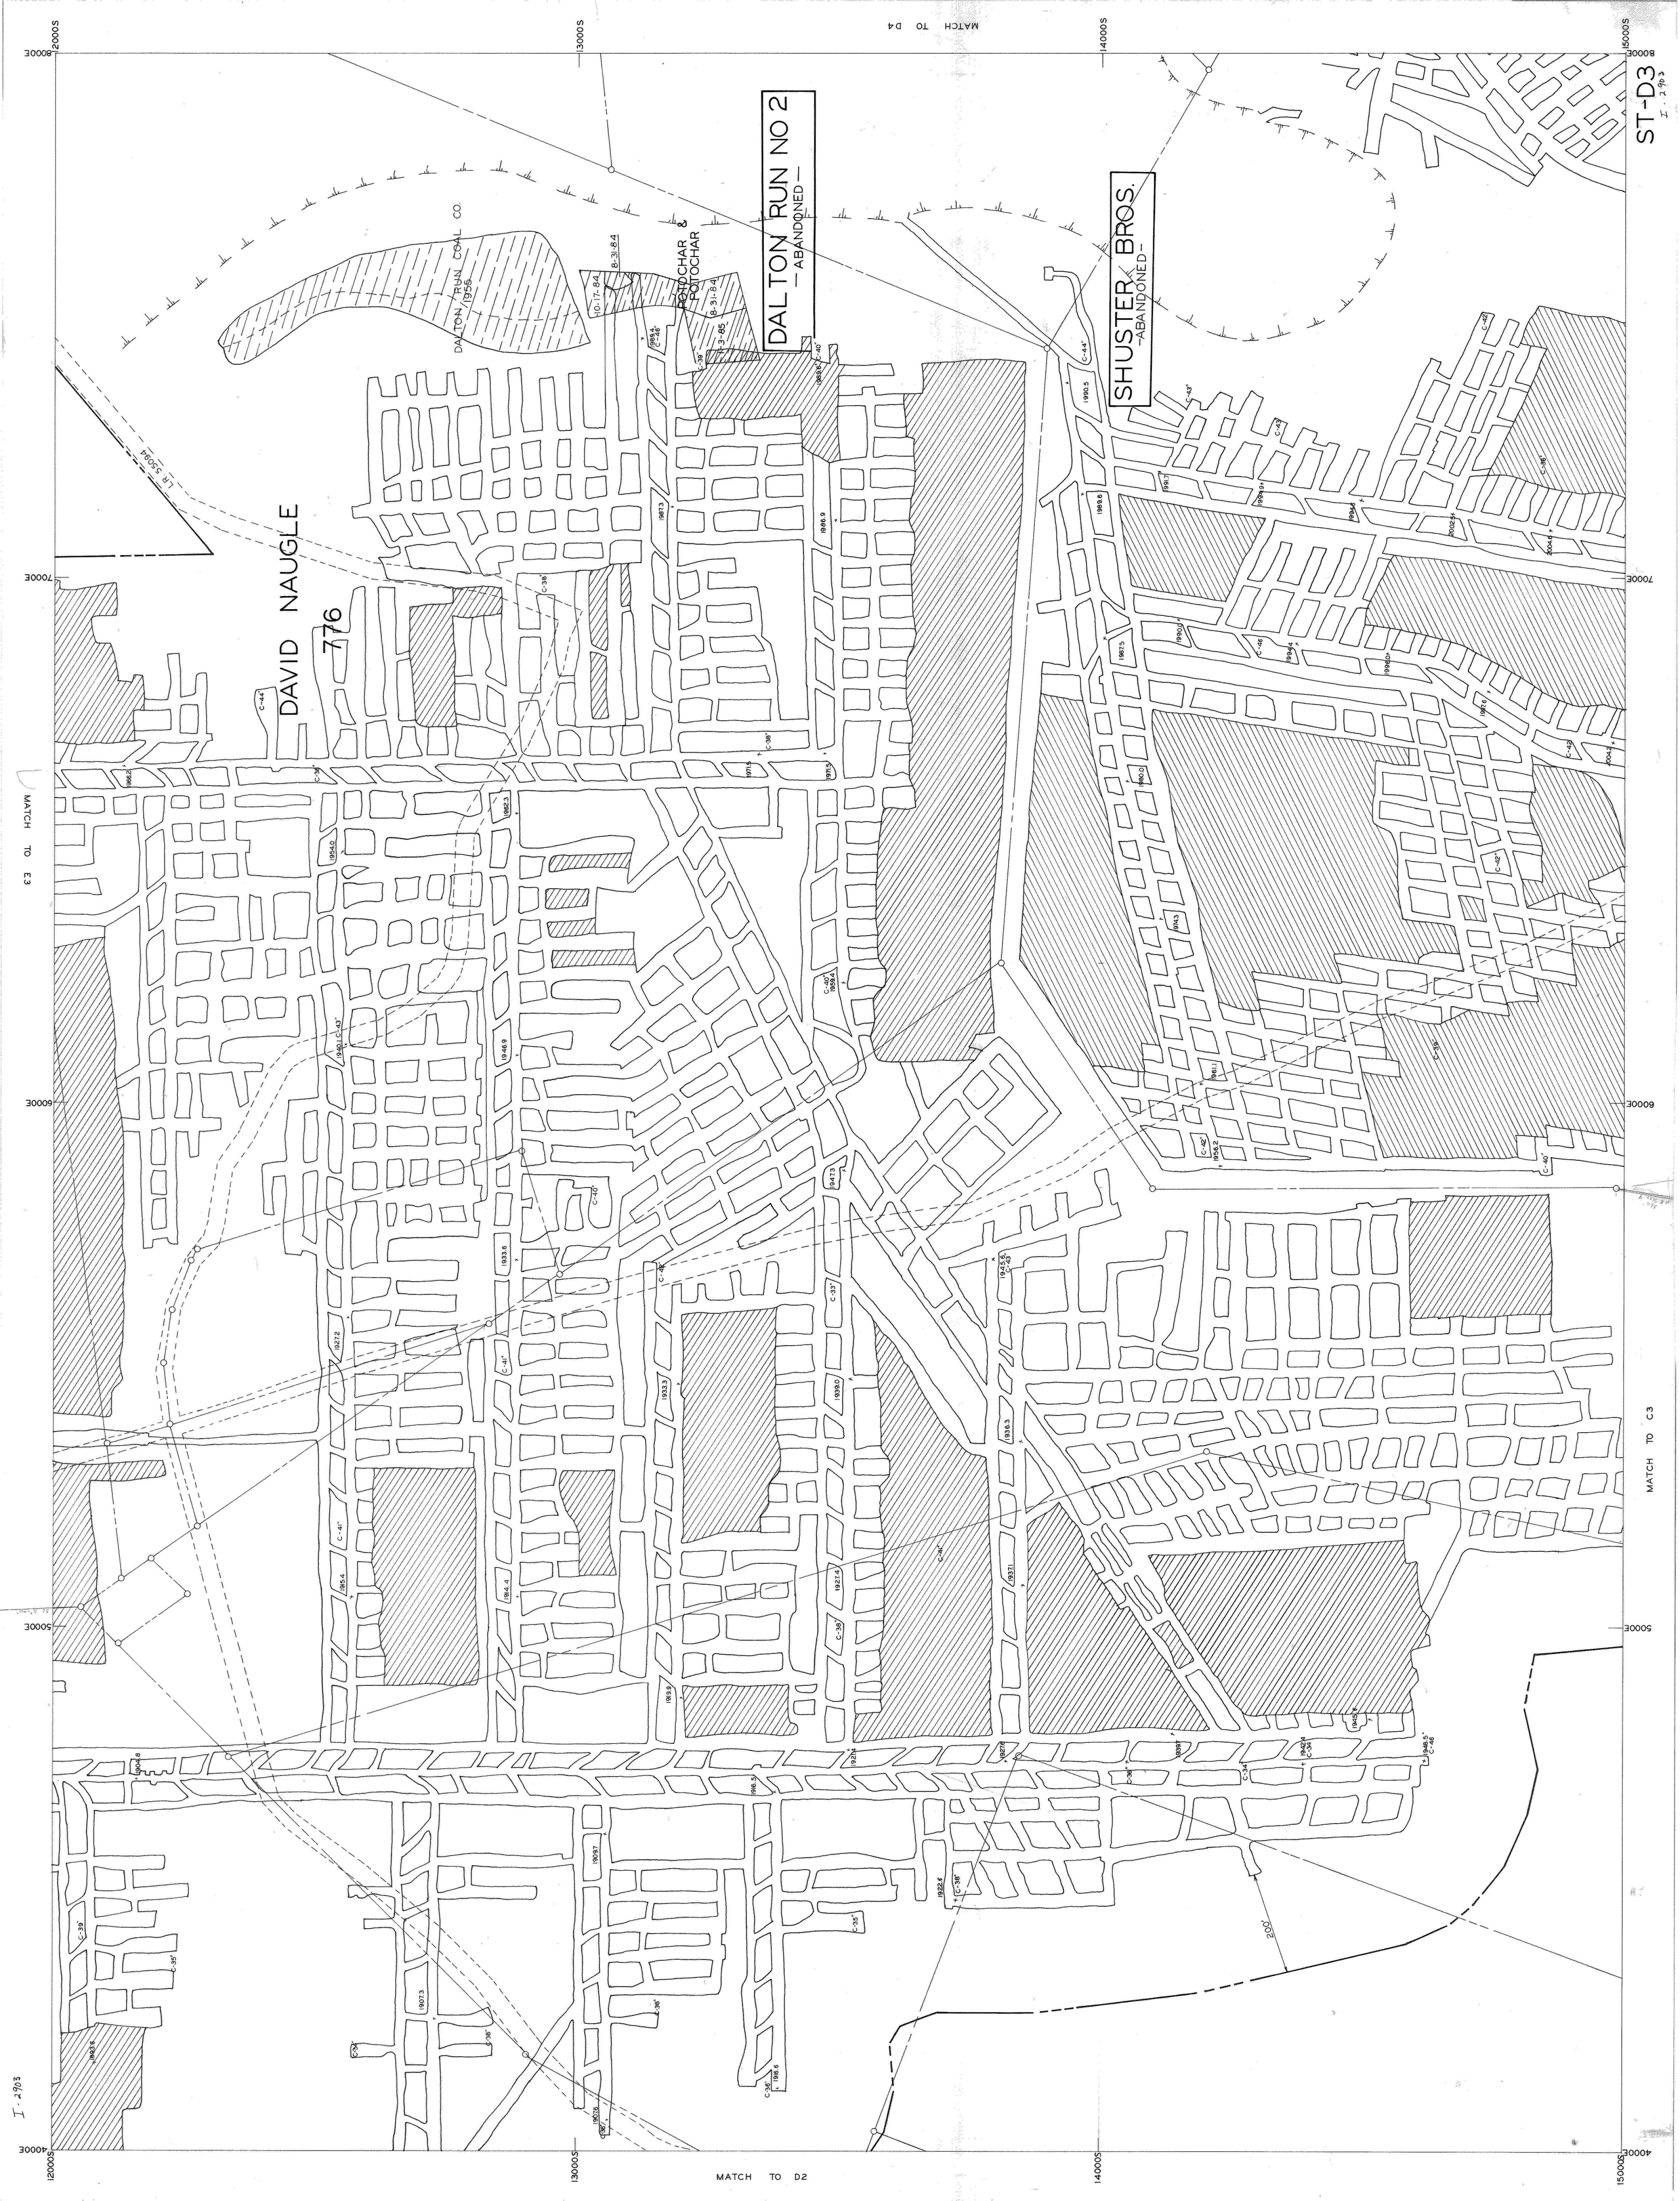

I - 2703

MATCH TO E3

20000

80000

50000

40000

DAVID NAUGLE

776

DALTON RUN COAL CO.

DALTON RUN NO 2  
- ABANDONED -

SHUSTER BROS.  
- ABANDONED -

MATCH TO D2

140000

130000

150000

MATCH TO C3

50000

60000

70000

80000

150000

ST-D3  
I - 2703