


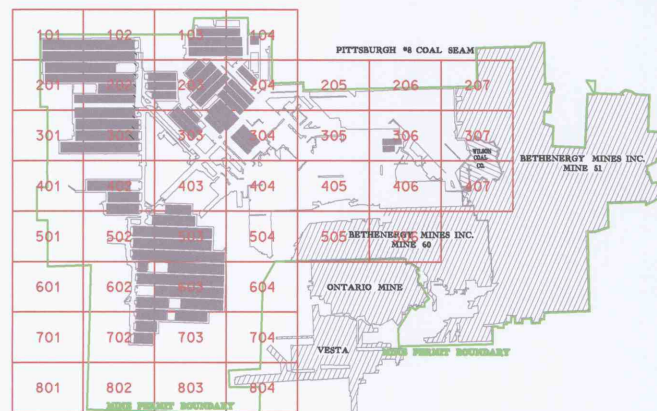

This map submitted in accordance with 30 CFR Sec. 75.1204 & PA Act 55 SB 949 Sec. 228
PERSONS PROVIDING INFORMATION ON MAP:
MARK HUTCHAY, MINE FOREMAN
NATHAN WOODS, MINE ENGINEER, TRANSE

INFORMATION INCORPORATED IN THIS MINE MAP WAS PROVIDED BY THE OPERATOR AND PREVIOUS OPERATORS AND MAY NOT HAVE ALL BEEN VERIFIED OR EVALUATED BY THE UNDERSIGNED. THE MAP MAY ALSO INCORPORATE THE SURVEY RESULTS AND MAPPING PREPARED UNDER THE DIRECTION OF REGISTERED ENGINEERS OTHER THAN THE UNDERSIGNED. SUBJECT TO THE ABOVEMENTIONED QUALIFICATIONS TO THE BEST OF MY KNOWLEDGE AND BELIEF, THIS DRAWING CONTAINS ACCURATE INFORMATION AND HAS BEEN COMPILED IN ACCORDANCE WITH GOOD ENGINEERING PRACTICES. AS OF MARCH 19, 2005, MINE MAPS PREPARED BY STANDARDS ACCORDING TO PA DEP TOP NO. 563-2000-810, SEC. 23.8, PENNSYLVANIA STATE PLANE, COORDINATE GRID (NAD83 DATUM).

CHAIN OF OWNERSHIP:
OWNER/LESSOR
RESERVE COAL, PROPERTIES CO. 11/16/2001 - PRESENT
LUCERNE LAND CO. 12/30/1992 - 11/16/2001
BETHLEHEM STEEL CORP. 12/24/1988 - 12/30/1992
CONSOLIDATION COAL CO. 05/01/1988 - 12/24/1988
PITTSBURGH CONSOLIDATION COAL CO. 10/23/1945 - 05/01/1988
LESSEE/OPERATOR
EIGHTY FOUR MINING CO. 12/30/1992 - PRESENT
BETHENERY MINES, INC. 07/01/1987 - 12/30/1992

EIGHTY FOUR MINING COMPANY
MINE NO. 84
P.O. BOX 4
CLAYVILLE, PA 15323

RELIEF/WATER MONITORING BOREHOLE
HORIZONTAL & VERTICAL CONTROL
STREAM
IDENTIFIED GAS WELL
ALLEGED WELL
EXPLORATION CORE HOLE
SEAL
MINE PERMIT BOUNDARY
NO KNOWN MINE WORKINGS UNDERLYING OR OVERLYING THE MINE PROPERTY
MIN SURVEY ACCURACY -110,000 (CLOSED LOOP)

MSHA LD. NO. 36-00958
PA DEP CMAP NO. 6353302
SCALE: 1" = 200'
FINAL MINE MAP
NOVEMBER 26, 2011

ALL BOREHOLES SEALED EXCEPT PRESSURE RELIEF/WATER MONITORING BOREHOLES
DALLAM POWER, HESTIA VENTILATION, WISCONSINE, LIVINGSTON CONCRETE, LONG SHAFT BOREHOLE,
RICHARDSON POWER, WER POWER, & ZEDDER POWER

