


MATCH TO SHEET 305

MATCH TO SHEET 307



MATCH TO SHEET 406

SHEET 306

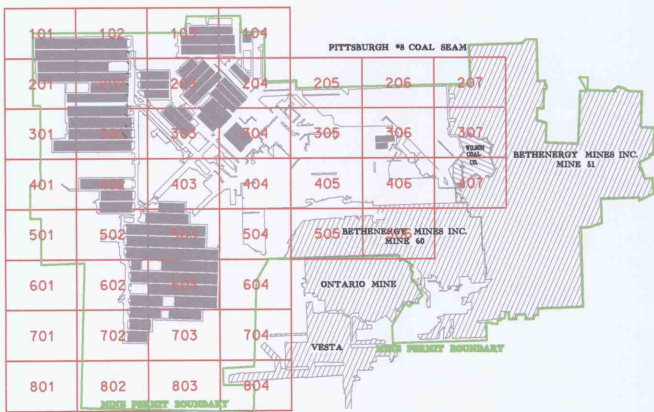

This map submitted in accordance with 30 CFR Sec. 75.1204 & PA Act 55 SB 949 Sec. 228
PERSONS PROVIDING INFORMATION ON MAP:
MARK HRUTKAY, MINE FOREMAN
NATHAN WOODS, MINE ENGINEER TRAINER

INFORMATION INCORPORATED IN THIS MINE MAP WAS PROVIDED BY THE OPERATOR AND PREVIOUS OPERATORS AND MAY NOT HAVE ALL BEEN VERIFIED OR EVALUATED BY THE UNDERSIGNED. THE MAP MAY ALSO INCORPORATE THE SURVEY RESULTS AND MAPPING PREPARED UNDER THE DIRECTION OF REGISTERED ENGINEERS OTHER THAN THE UNDERSIGNED. SUBJECT TO THE FOREMENTIONED QUALIFICATIONS, TO THE BEST OF MY KNOWLEDGE AND BELIEF, THIS DRAWING CONTAINS ACCURATE INFORMATION AND HAS BEEN COMPILED IN ACCORDANCE WITH GOOD ENGINEERING PRACTICES AS OF MARCH 19, 2025. MINE MAPS PREPARED BY STANDARDS ACCORDING TO PA DEP 120.100 NO. 563-2000-810 SEC. 22.8 PENNSYLVANIA STATE PLANE COORDINATE GRID (NAD83 DATUM).

CHAIN OF OWNERSHIP:
OWNER/LESSOR
RESERVE COAL PROPERTIES CO. 11/16/2001 - PRESENT
LUCERNE LAND CO. 12/30/1992 - 11/16/2001
BETHLEHEM STEEL CORP. 12/24/1988 - 12/30/1992
CONSOLIDATION COAL CO. 05/01/1988 - 12/24/1988
PITTSBURGH CONSOLIDATION COAL CO. 11/23/1945 - 05/01/1988

LESSEE/OPERATOR
EIGHTY FOUR MINING CO. 12/30/1992 - PRESENT
BETHLEHEM MINES, INC. 07/01/1987 - 12/30/1992

EIGHTY FOUR MINING COMPANY
MINE #4
CLAYSVILLE, PA 15323

MSHA LD. NO. 36-00958
PA DEP CHART NO. 6383102
SCALE 1" = 200'
FINAL MINE MAP
NOVEMBER 28, 2011

RELIEF/WATER MONITORING BOREHOLE
HORIZONTAL & VERTICAL CONTROL
STREAM
IDENTIFIED GAS WELL
ALLEGED WELL
EXPLORATION CORE HOLE
SEAL
MINE PERMIT BOUNDARY

NO KNOWN MINE WORKINGS UNDERLYING OR OVERLYING THE MINE PROPERTY
MIN SURVEY ACCURACY - 110,000 (CLOSED LOOP)
ALL BOREHOLES SEALED EXCEPT PRESSURE RELIEF/WATER MONITORING BOREHOLES (HALLAM POWER, HUSTAVA VENTILATION, KISKIRKLINE, LIVINGSTON CONCRETE, LONG SHAFT BOREHOLE, RICHARDSON POWER, WER POWER, & ZEDKER POWER)

