

$$\begin{array}{r} 750 \\ 300 \\ \hline 1050 \end{array}$$

$$\begin{array}{r} 3270 \\ 1500 \\ \hline 4770 \end{array}$$

UNITED INDUSTRIES


$$\begin{array}{r} 6500 \\ 8\frac{1}{2} \\ \hline 50400 \\ 3 \end{array}$$

$$\begin{array}{r} 3600 \\ 8\frac{1}{2} \\ \hline 28800 \\ 1800 \\ \hline 30600 \end{array}$$

$$\begin{array}{r} 28 \\ 26 \\ 24 \\ 20 \\ 20 \\ \hline 1 \end{array}$$

$$\begin{array}{r} 7650 \\ 1050 \\ \hline 8700 \end{array}$$

$$\begin{array}{r} 260 \\ 240 \\ \hline 240 \end{array}$$

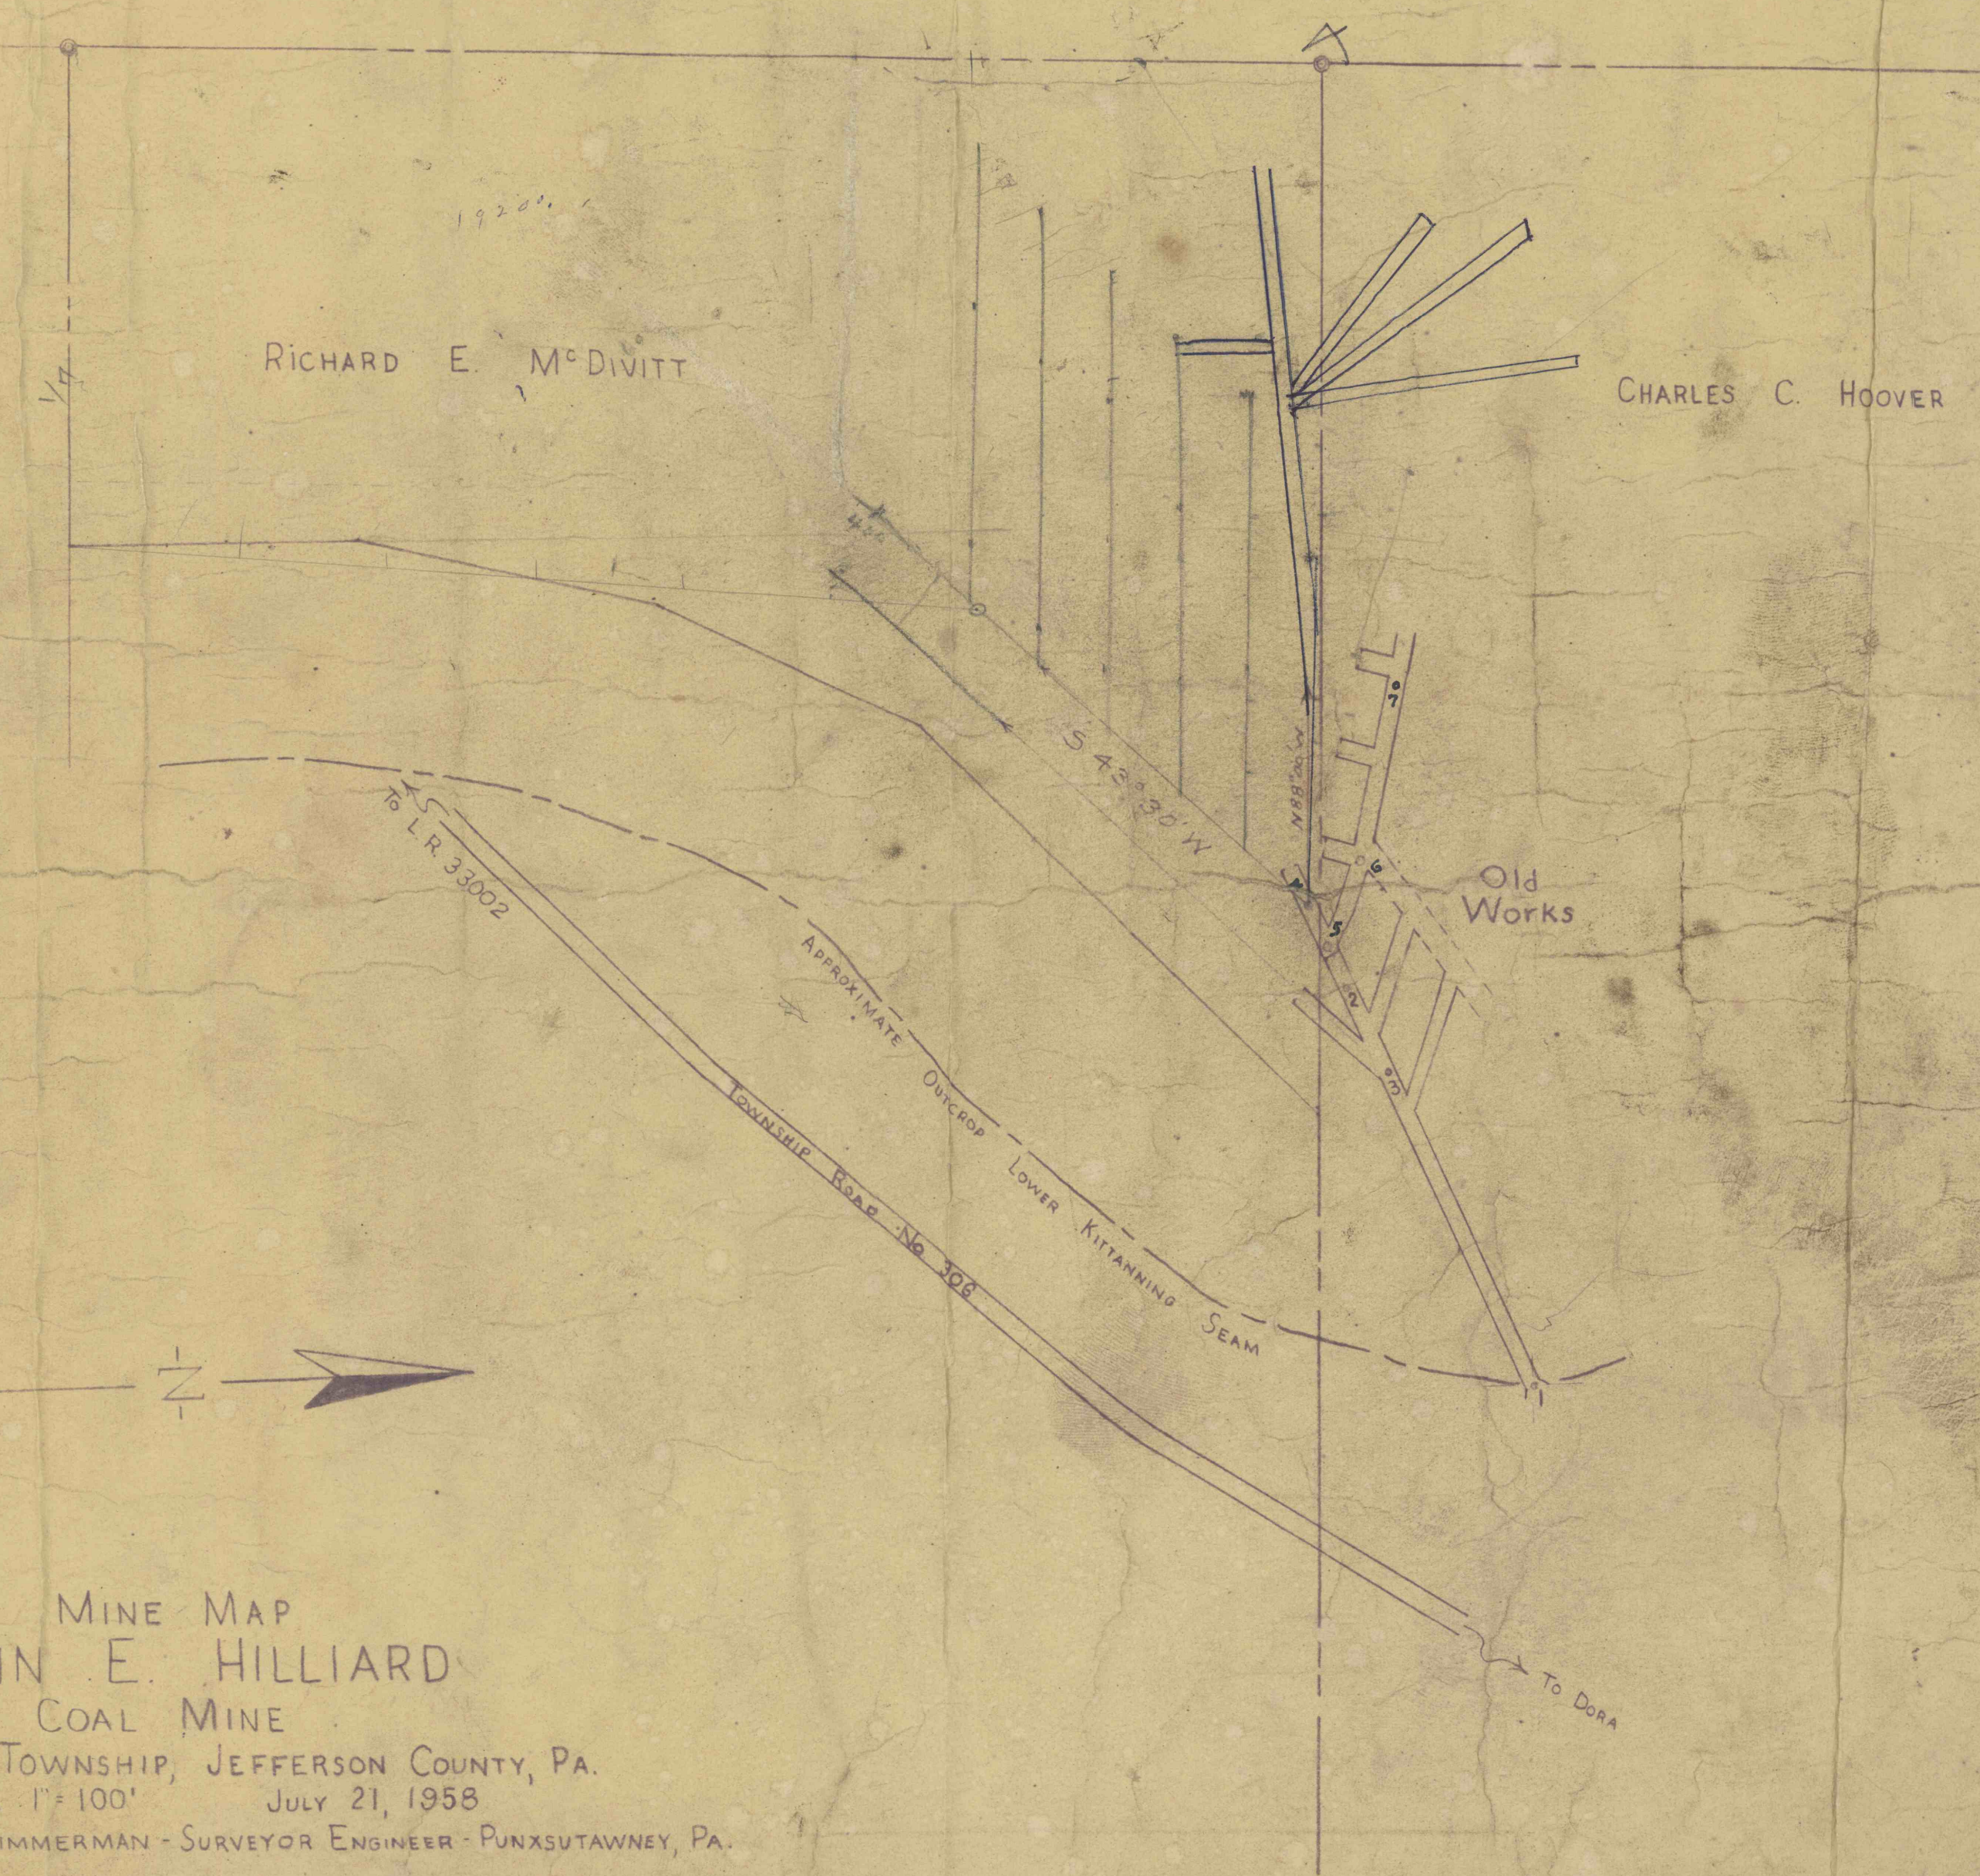

MINE MAP
 JOHN E. HILLIARD
 COAL MINE
 PORTER TOWNSHIP, JEFFERSON COUNTY, PA.
 SCALE 1"=100' JULY 21, 1958
 WALTER J. ZIMMERMAN - SURVEYOR ENGINEER - PUNXSUTAWNEY, PA.