MAP SHOWING MINING OPERATIONS OF
INGLESIDE MINE No. 5 "B" SEAM
Situate in Richland and Stonycreek Townships
Cambria County, Pa.

The Lorain Steel Company
Johnstown, Pa.
SUBSIDIARY OF
UNITED STATES STEEL CORPORATION

Scale 1 inch = 100 ft. **September 14, 1932**

DEEP MINE SAFETY 100
0 100 Feet

MAP OF VALLEY SMOKELELESS COAL C

MINING OPERATIONS
LOCATED IN
STONY CREEK TWP. CAMBRIA CO. PA.
MAR 25 1918 FETTERMAN ENG. CO. JOHNSTOWN PA.
SCALE 1" = 100 FT.

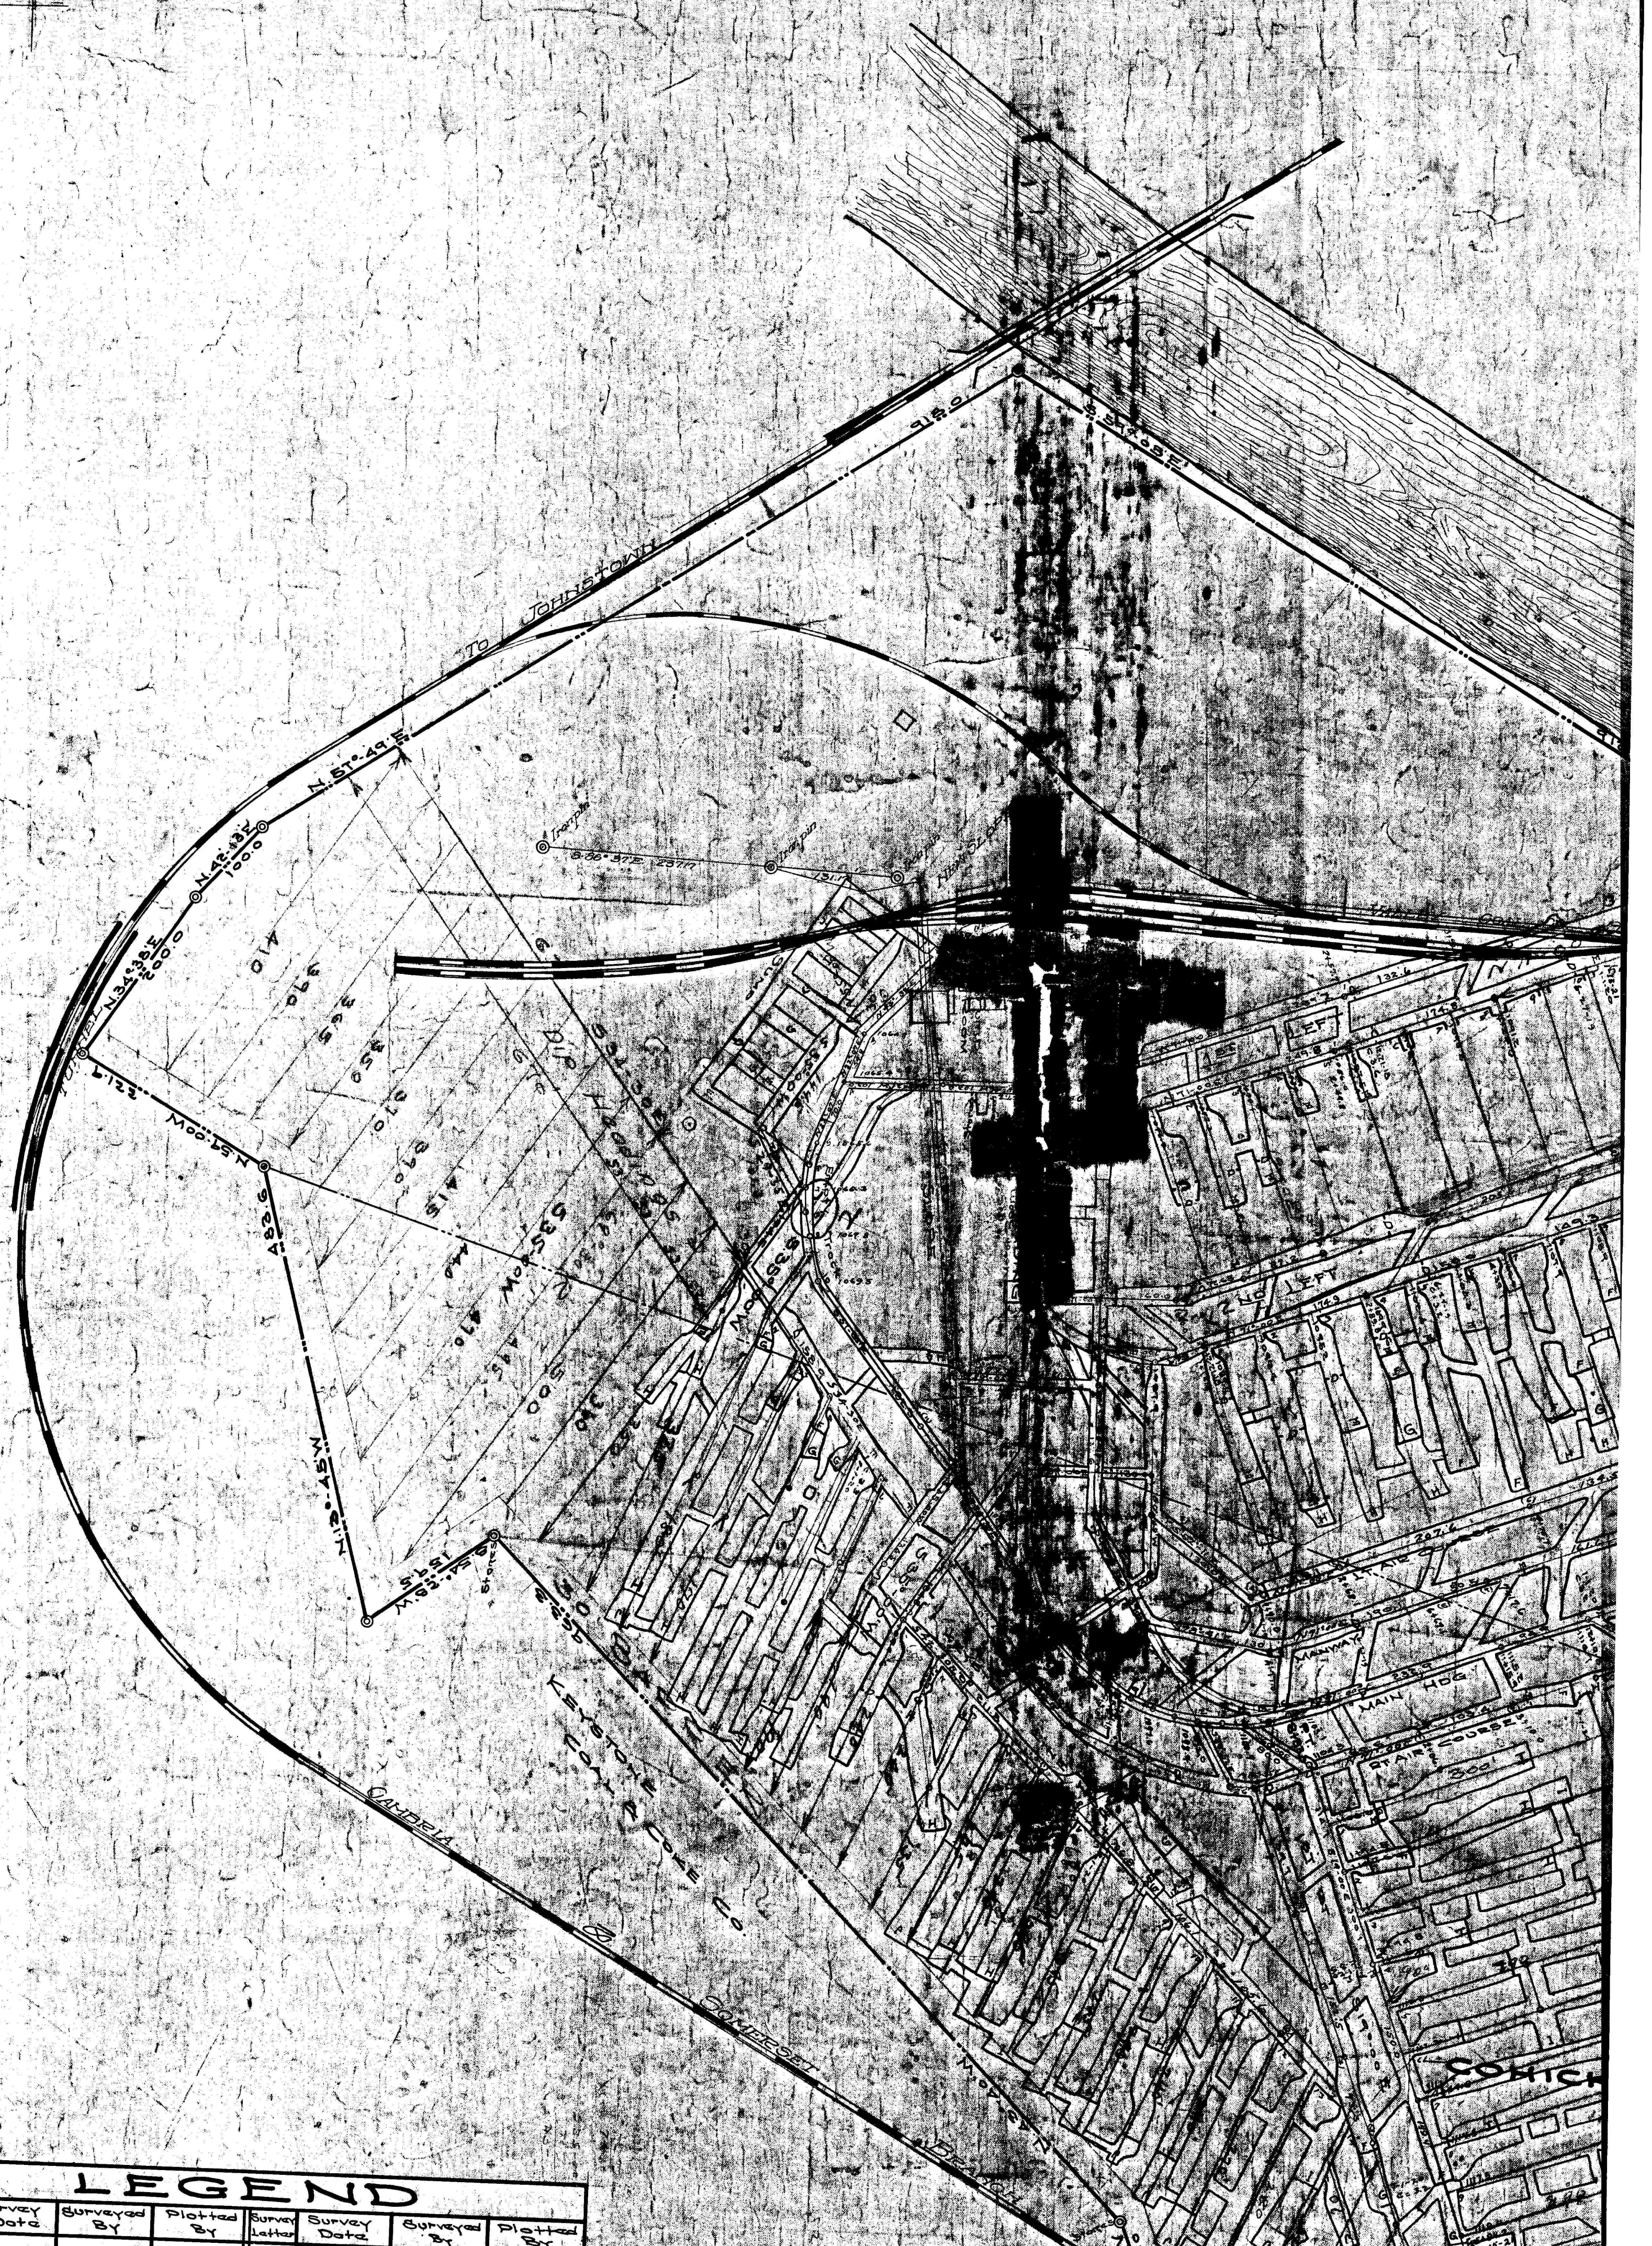

LEGEND

Survey Letter	Survey Date	Surveyed By	Plotted By	Survey Letter	Survey Date	Surveyed By	Plotted By
A	Nov. 16, 1917						
B	June 4, 1918						
C	Dec. 21, 1918	Singer	Llewellyn				
D	June 21, 19	"	"				
E	Jan. 1, 1920	"	"				
F	July 1, 1920	"	Hinks.				
G	Jan 15, 1921	"	Edkins				
H	July 9, 1921	"	"				
I	Jan 12-1922	"	"				
"J"	June 20-1922	"	"				
K	Jan-9-23	"	"				
L	July 6-23	Galbraith	"				
M	Jan-5-24	"	"				
N	Nov-4-25	"	A. Hinks				
O	Jan-4-26	"	" "				