


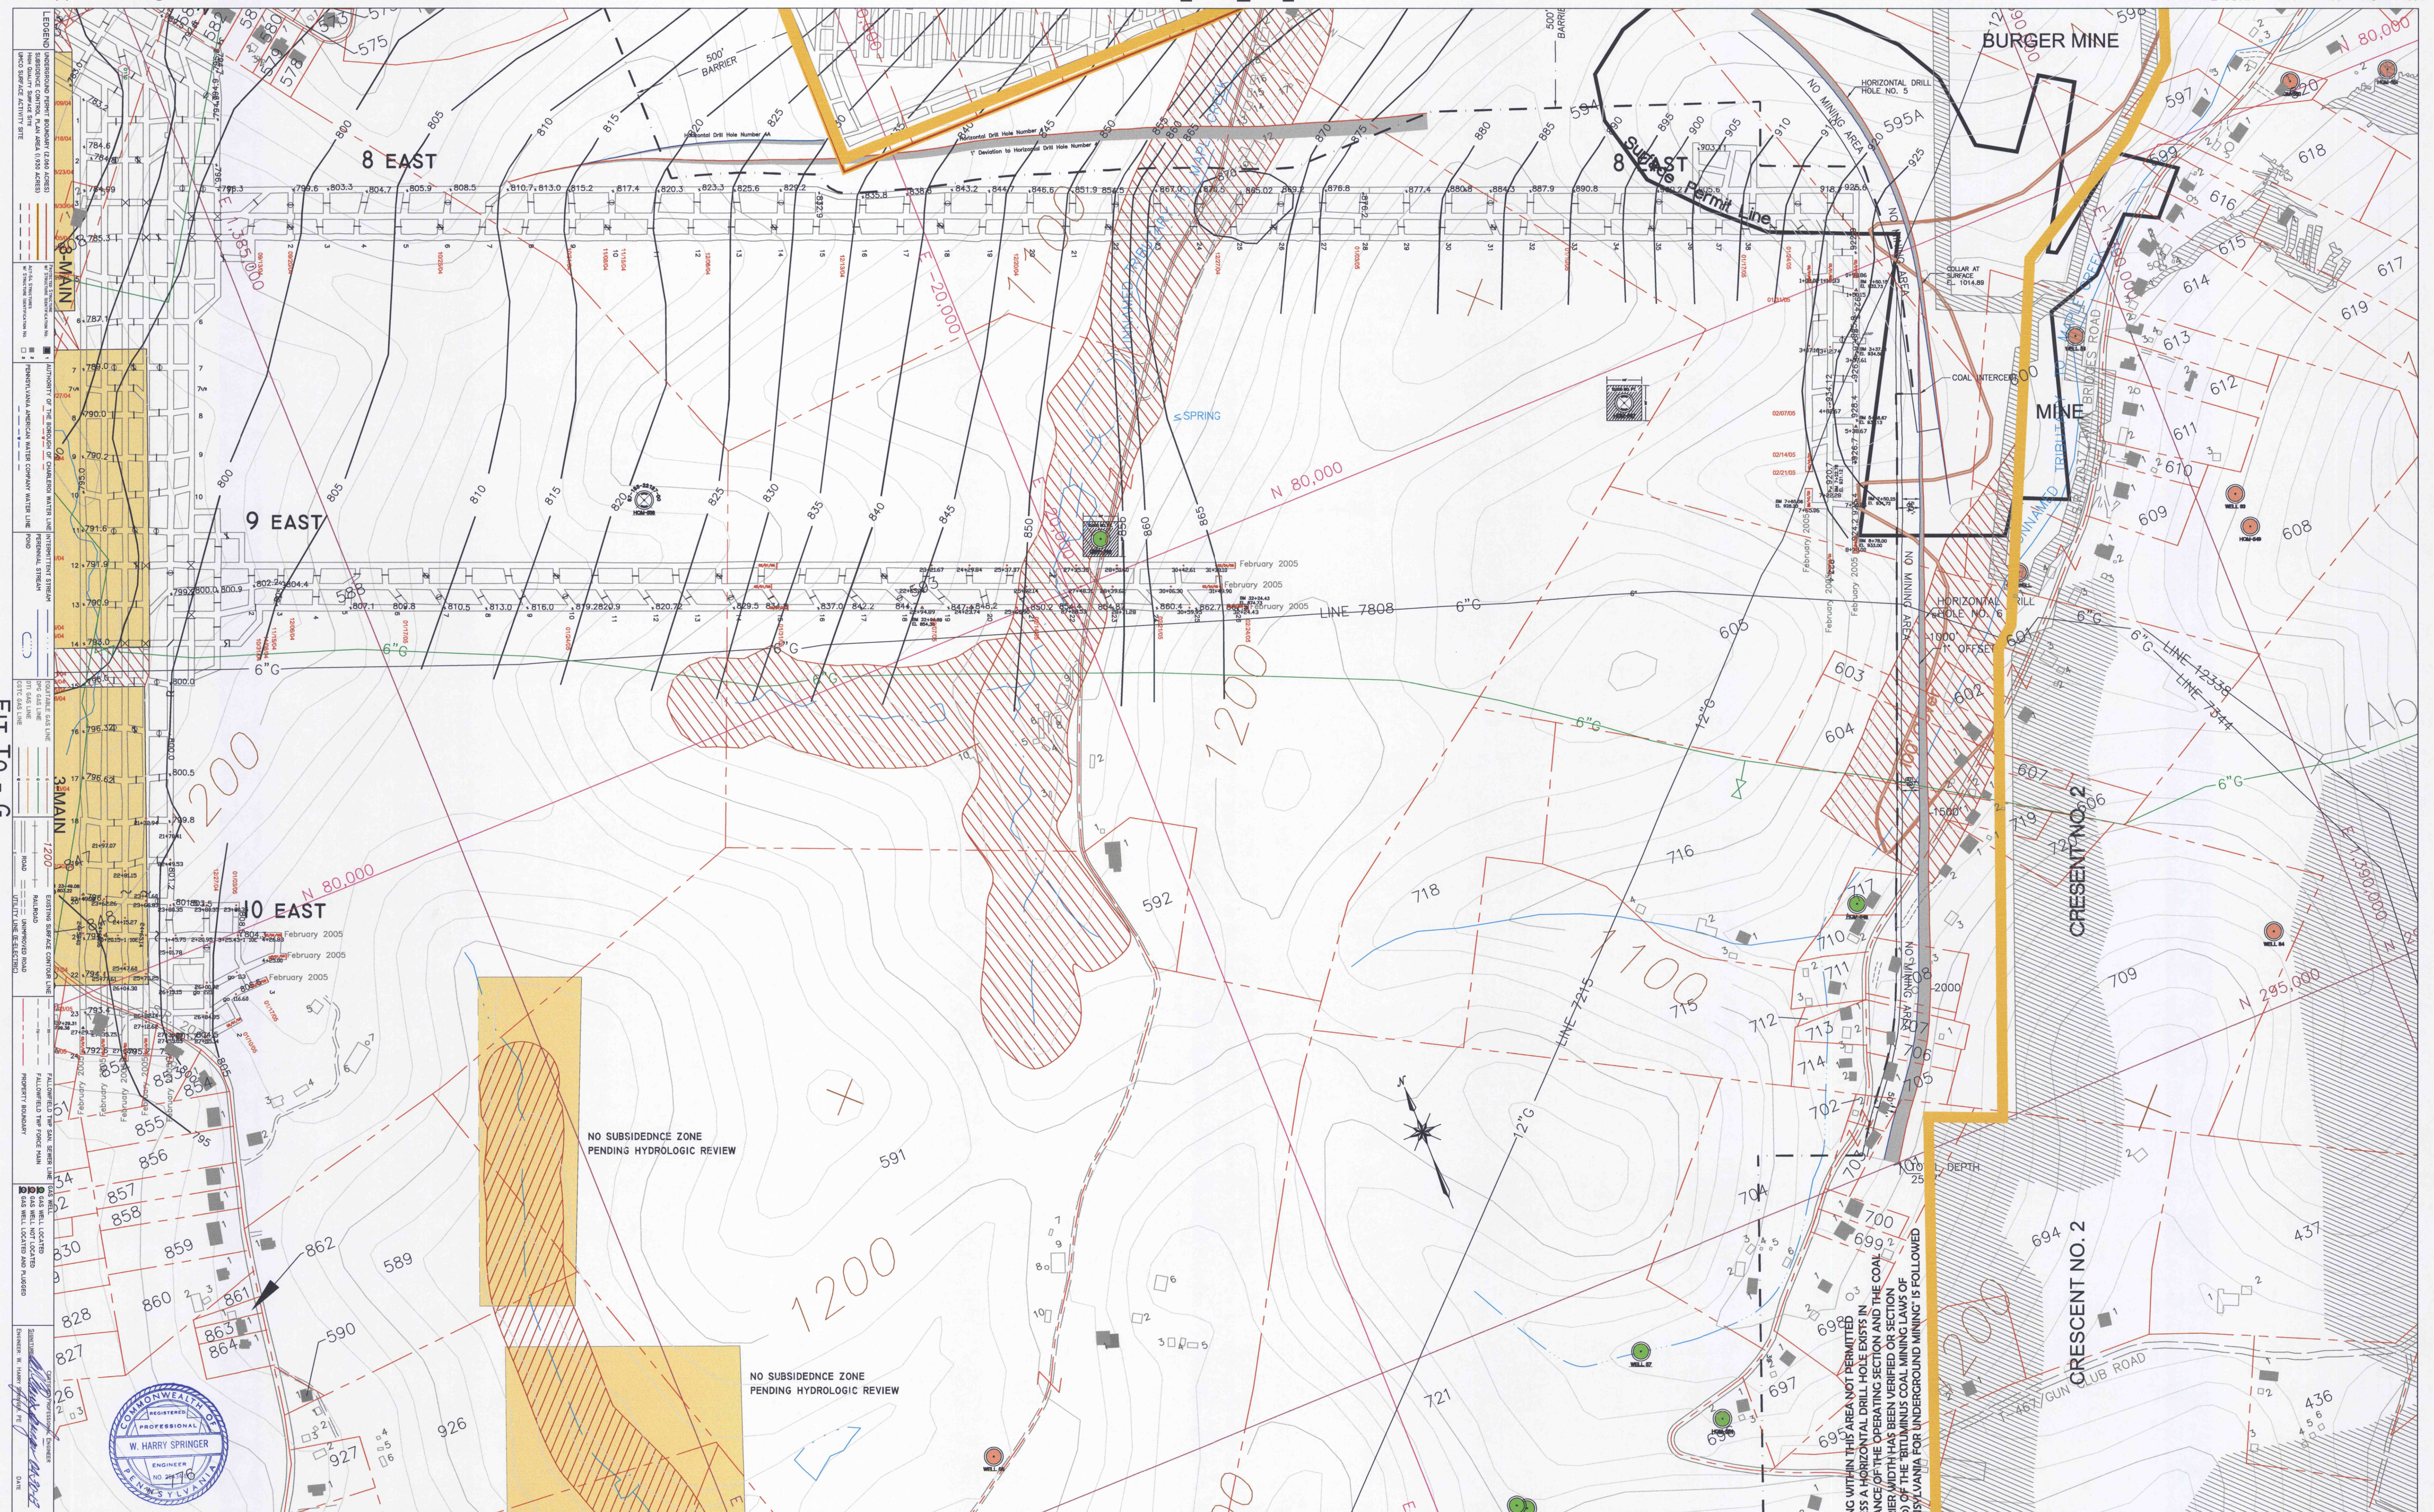

FIT TO - G

FIT TO - F

FIT TO - J

SHEET - H