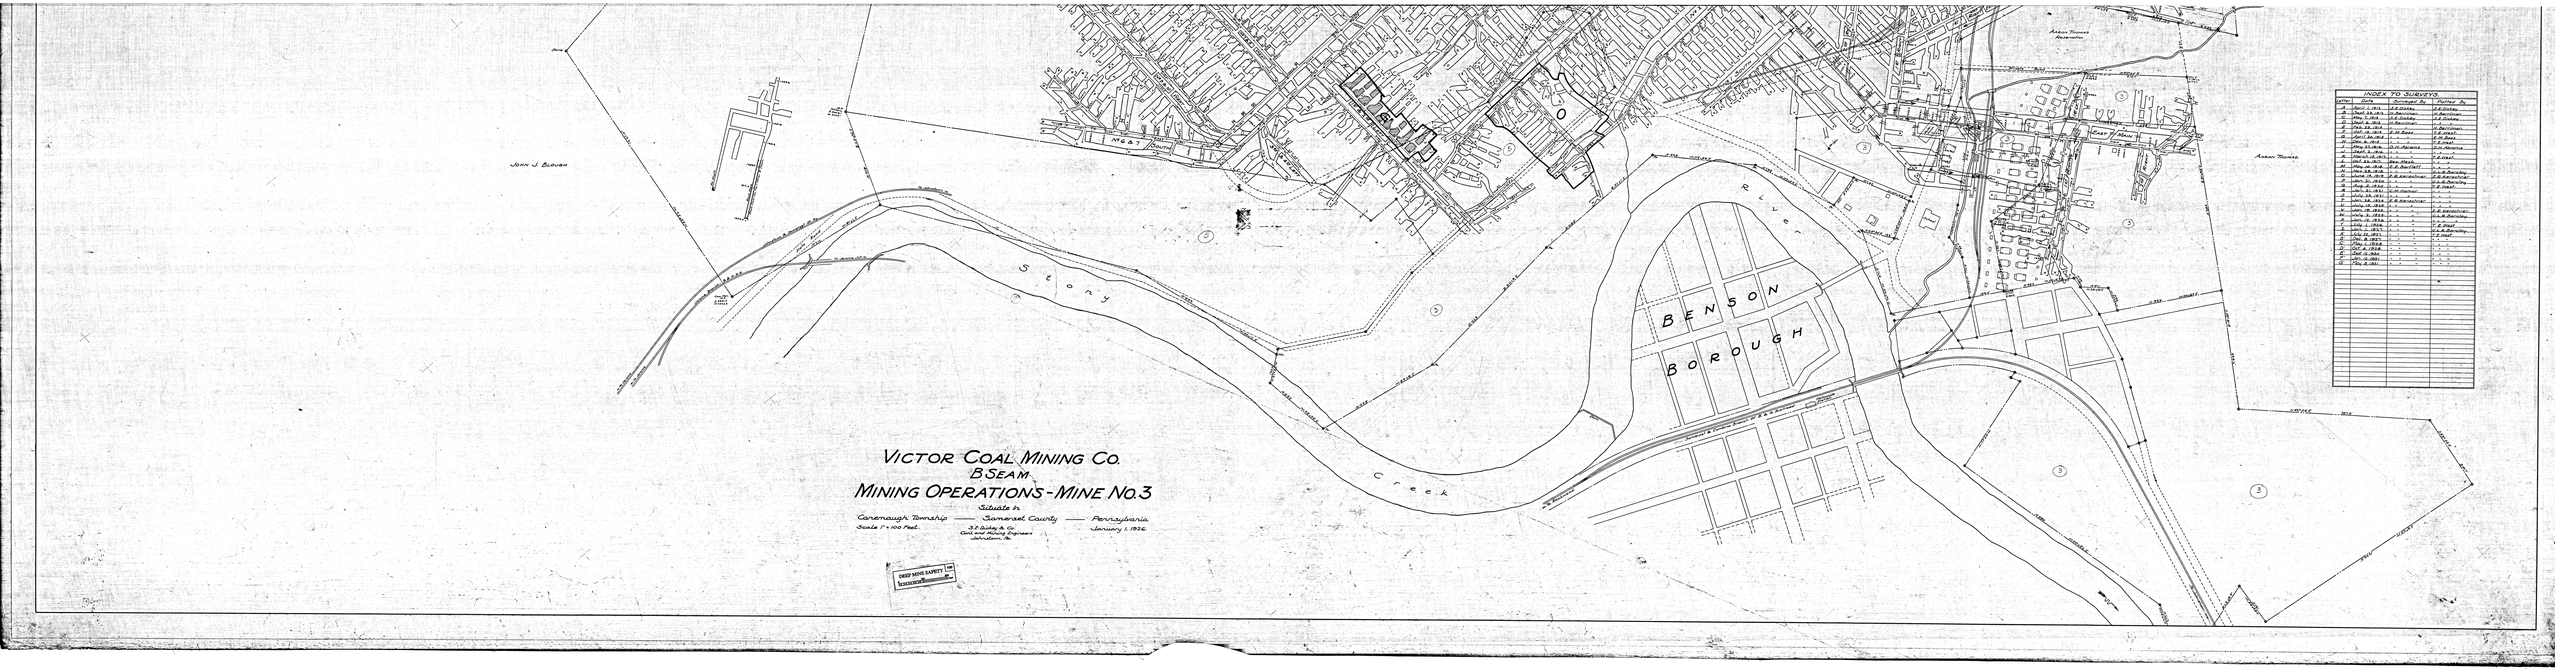
BENSON
BOROUGH
Stony
Creek
River
John J. Blough
Adam Thomas
Adam Thomas Recreation
Grant Avenue
Main Street
Mine No. 3
